
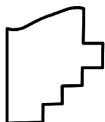
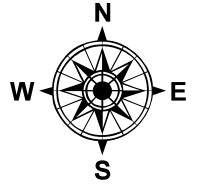


PARENT PARCEL: 07-00-004-108-059

CHILD PARCEL: **AC CORR PER SURVY BY SCOTT J. CASEY**

STARTING POINT: C/L OF CHESTNUT RIDGE AND LEAR NAGLE RD

21-04739-C

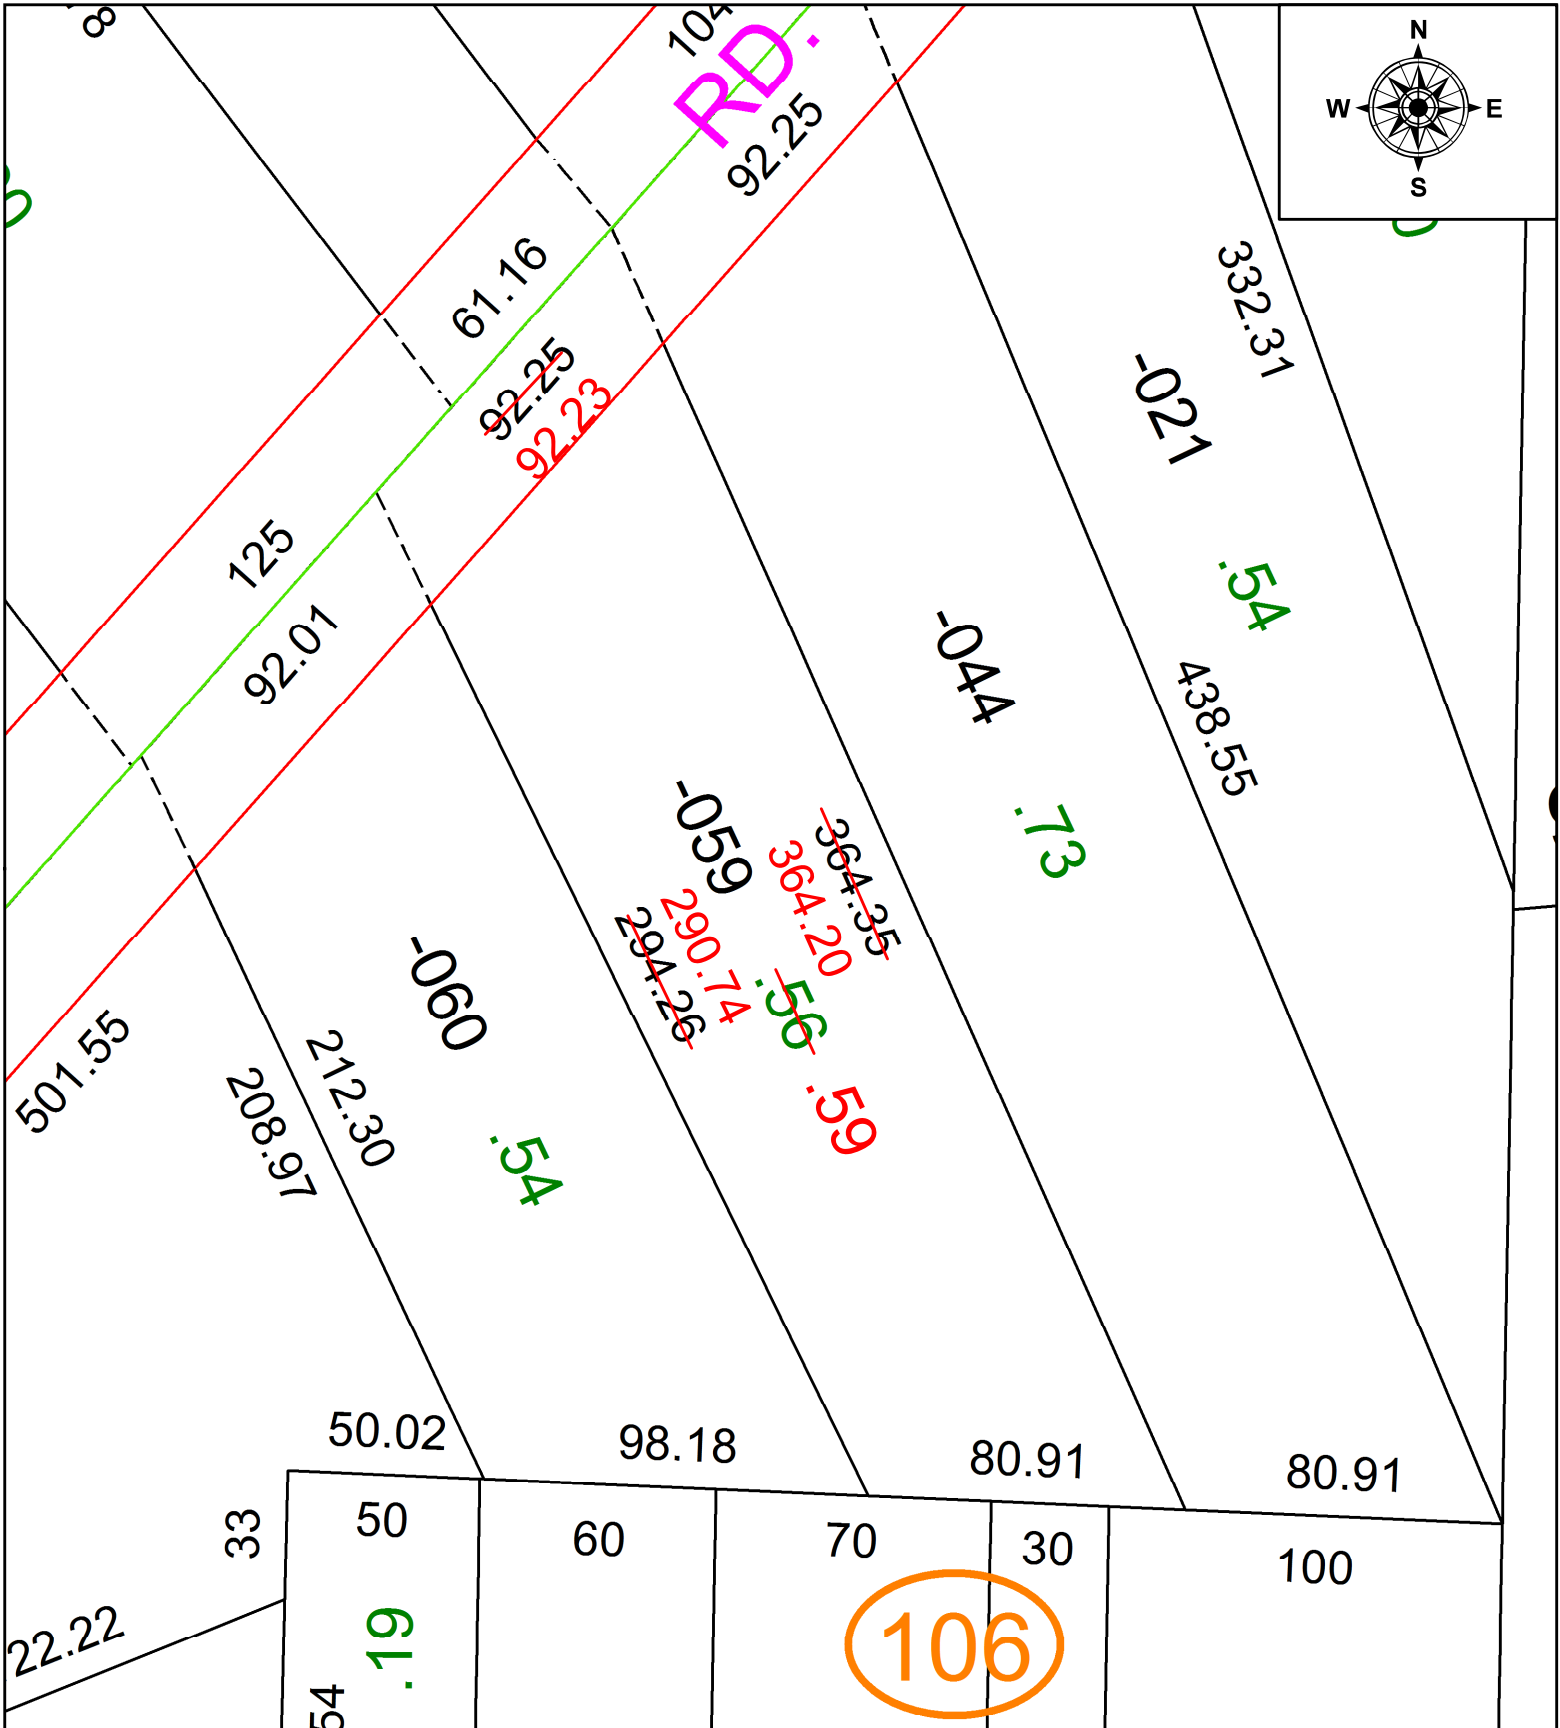

**SPLITS/DEEDS PROCESSED**  
 LORAIN COUNTY TAX MAP DEPARTMENT  
 226 MIDDLE AVE. ELYRIA, OH

SURVEYED BY: SCOTT J. CASEY  
 CLOSURE: 1: 239722  
 MAP PAGE(S): 07-00-004-C  
 APPROVED BY: AC DATE: 12/7/2021  
 SCALE: 1" = 50 PRIOR INSTRUMENT: 2021- 0847933