
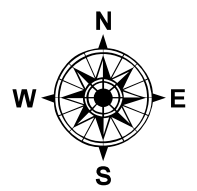


PARENT PARCEL: 12-00-047-103-011

CHILD PARCEL: **AC CORR PER SURV BY JOHN G. HOY**

STARTING POINT: C/L OF BRIARWOOD LANE AND SW CORNER OF LAND CONVEYED TO TP 2013 2018-0699172

21-04740-A

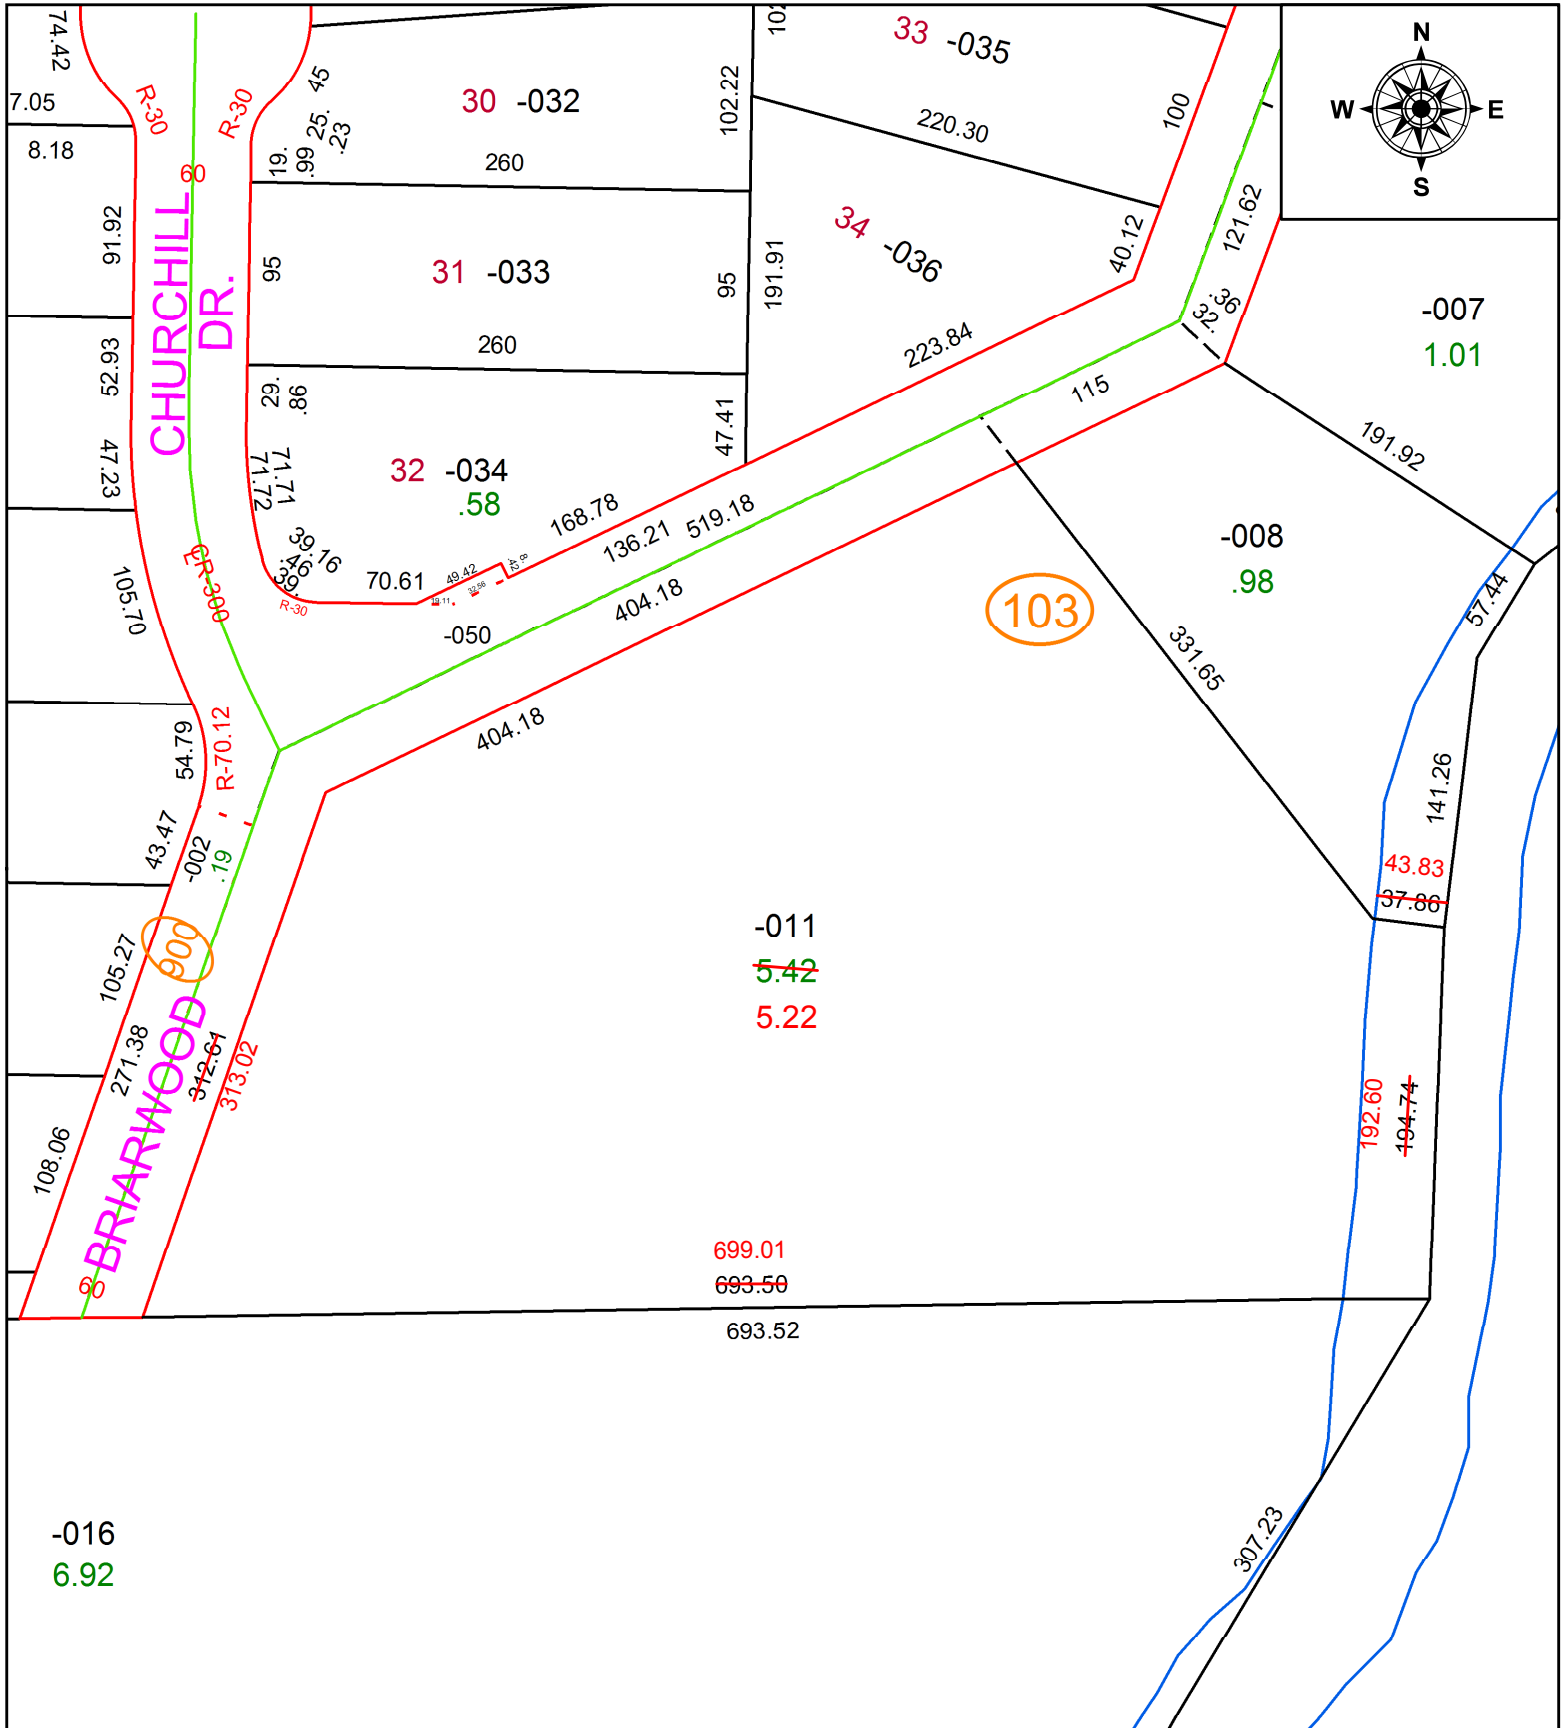

SPLITS/DEEDS PROCESSED
 LORAIN COUNTY TAX MAP DEPARTMENT
 226 MIDDLE AVE. ELYRIA, OH

SURVEYED BY: JOHN G. HOY
 CLOSURE: 1: 154772
 MAP PAGE(S): 12-00-047
 APPROVED BY: AC DATE: 12/7/2021
 SCALE: 1" = 100 PRIOR INSTRUMENT: 2018-0699172