
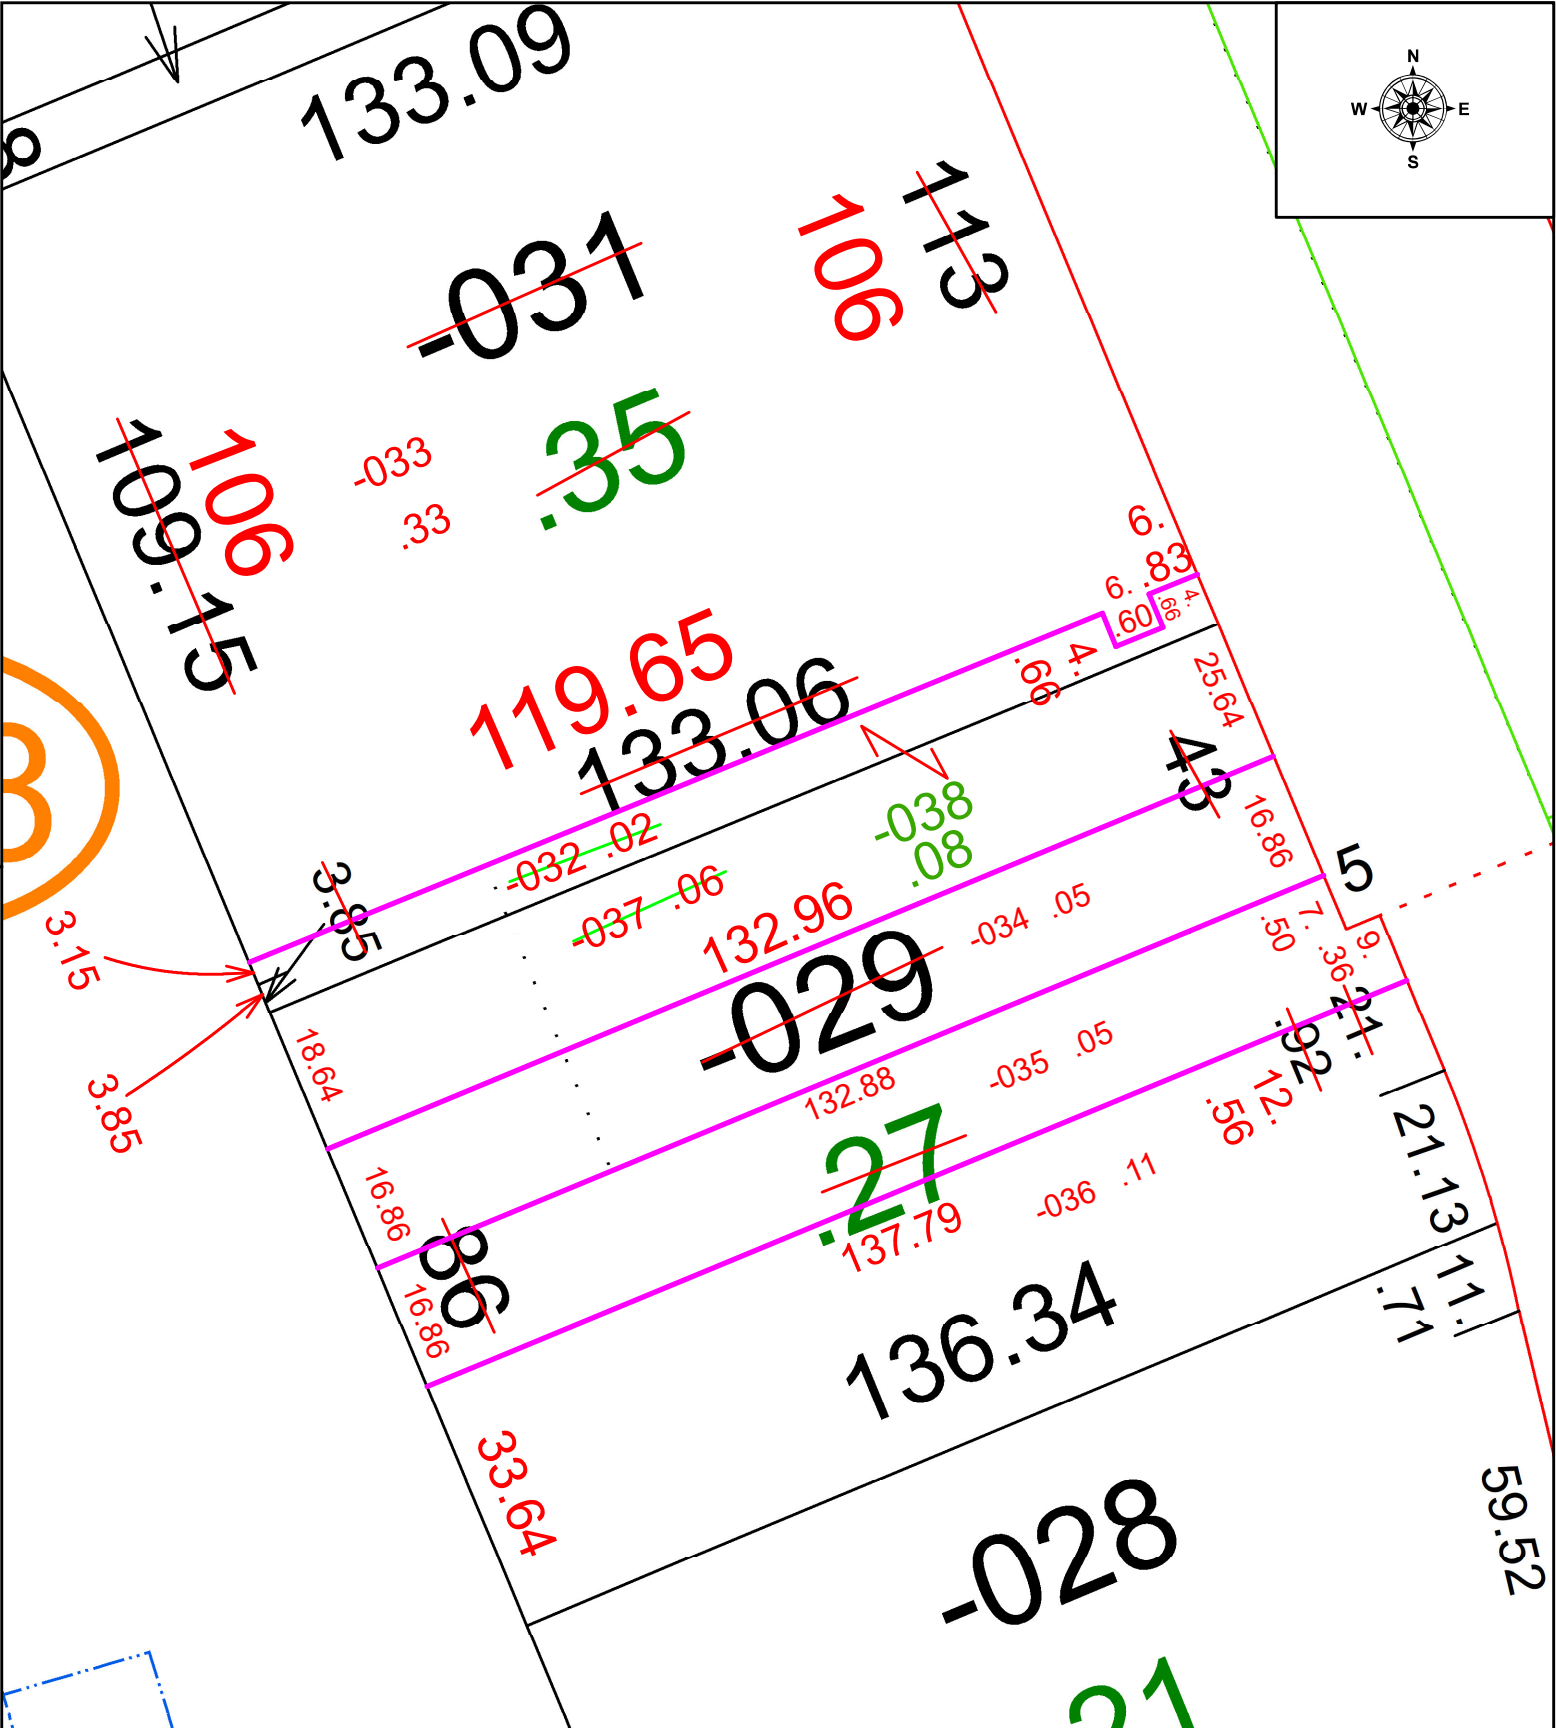


PARENT PARCEL: 02-01-001-108-029 & -031
CHILD PARCEL: 02-01-001-108-032 THRU -038
STARTING POINT: MONUMENT BOX @ INTERSECTION OF C/LS OF ARZIONAAVE & BASCULE DR

23-04742

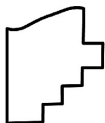

 **SPLITS/DEEDS PROCESSED**
LORAIN COUNTY TAX MAP DEPARTMENT
226 MIDDLE AVE. ELYRIA, OH

SURVEYED BY: PATRICK MCGANNON	SURVEY # 51001
CLOSURE: 1: 50745	
MAP PAGE(S): 02-01-001	
APPROVED BY: WRZ	DATE: 8/29/2023
SCALE: 1" = 25'	PRIOR INSTRUMENT: #2020-0794799