


PARENT PARCEL: 06-24-151-000-003


CHILD PARCEL: **FR. & DEPTH TO AC. CORR. PER SURVEY**

STARTING POINT: CL OF FURNACE ST. & LESNICK CT.


21-04743-C

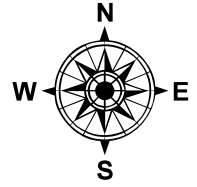

-003 .14 291.72

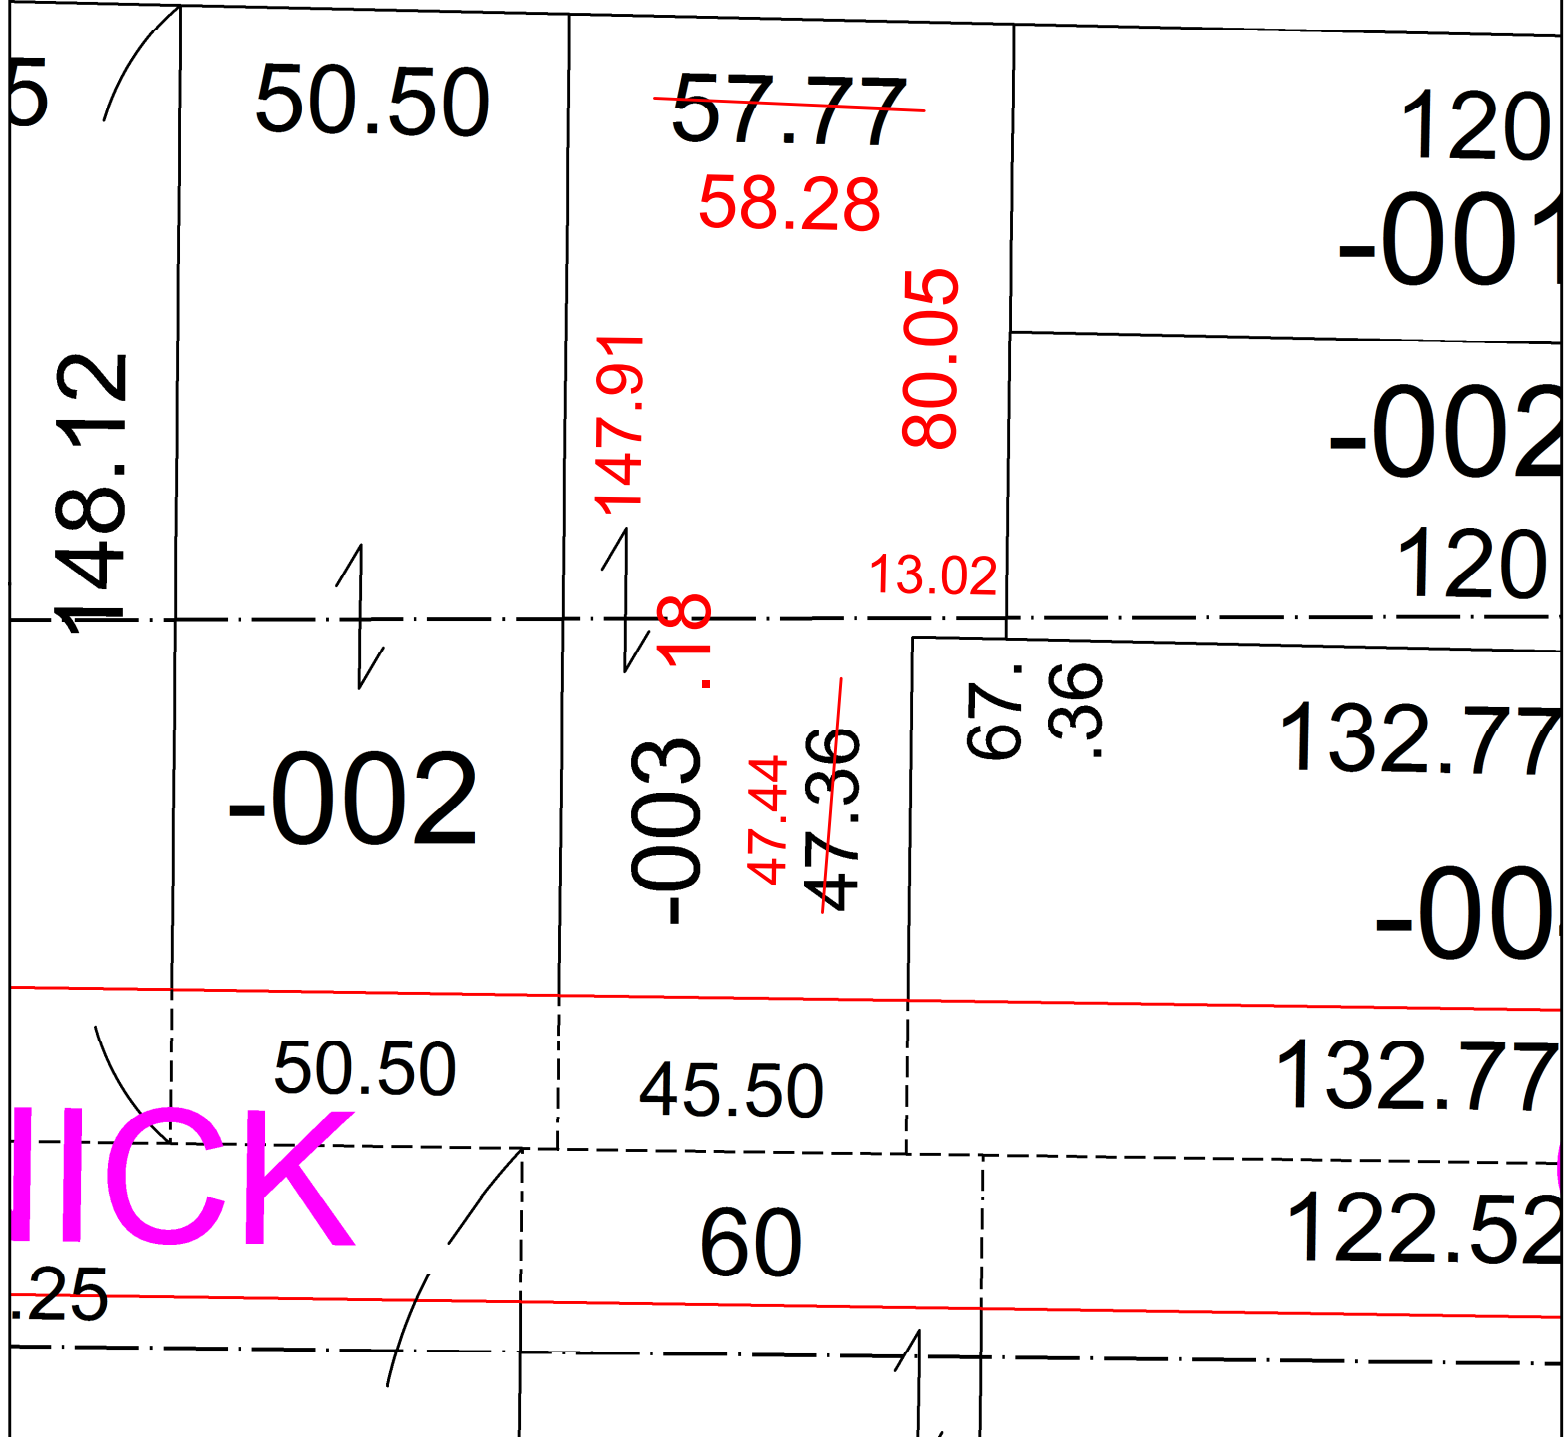

LICK

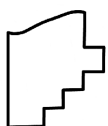

SPLITS/DEEDS PROCESSED
LORAIN COUNTY TAX MAP DEPARTMENT
226 MIDDLE AVE. ELYRIA, OH

SURVEYED BY: SCOTT CASEY
 CLOSURE: 1: 45606
 MAP PAGE(S): 06-24-151
 APPROVED BY: DMA DATE: 12/9/2021
 SCALE: 1" = 25' PRIOR INSTRUMENT: 2019-0732452