
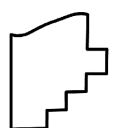


PARENT PARCEL: 12-00-003-000-171

CHILD PARCEL: 12-00-003-000-174 & -175

STARTING POINT: C/L OF CLARK AND SNELL RD

23-04744

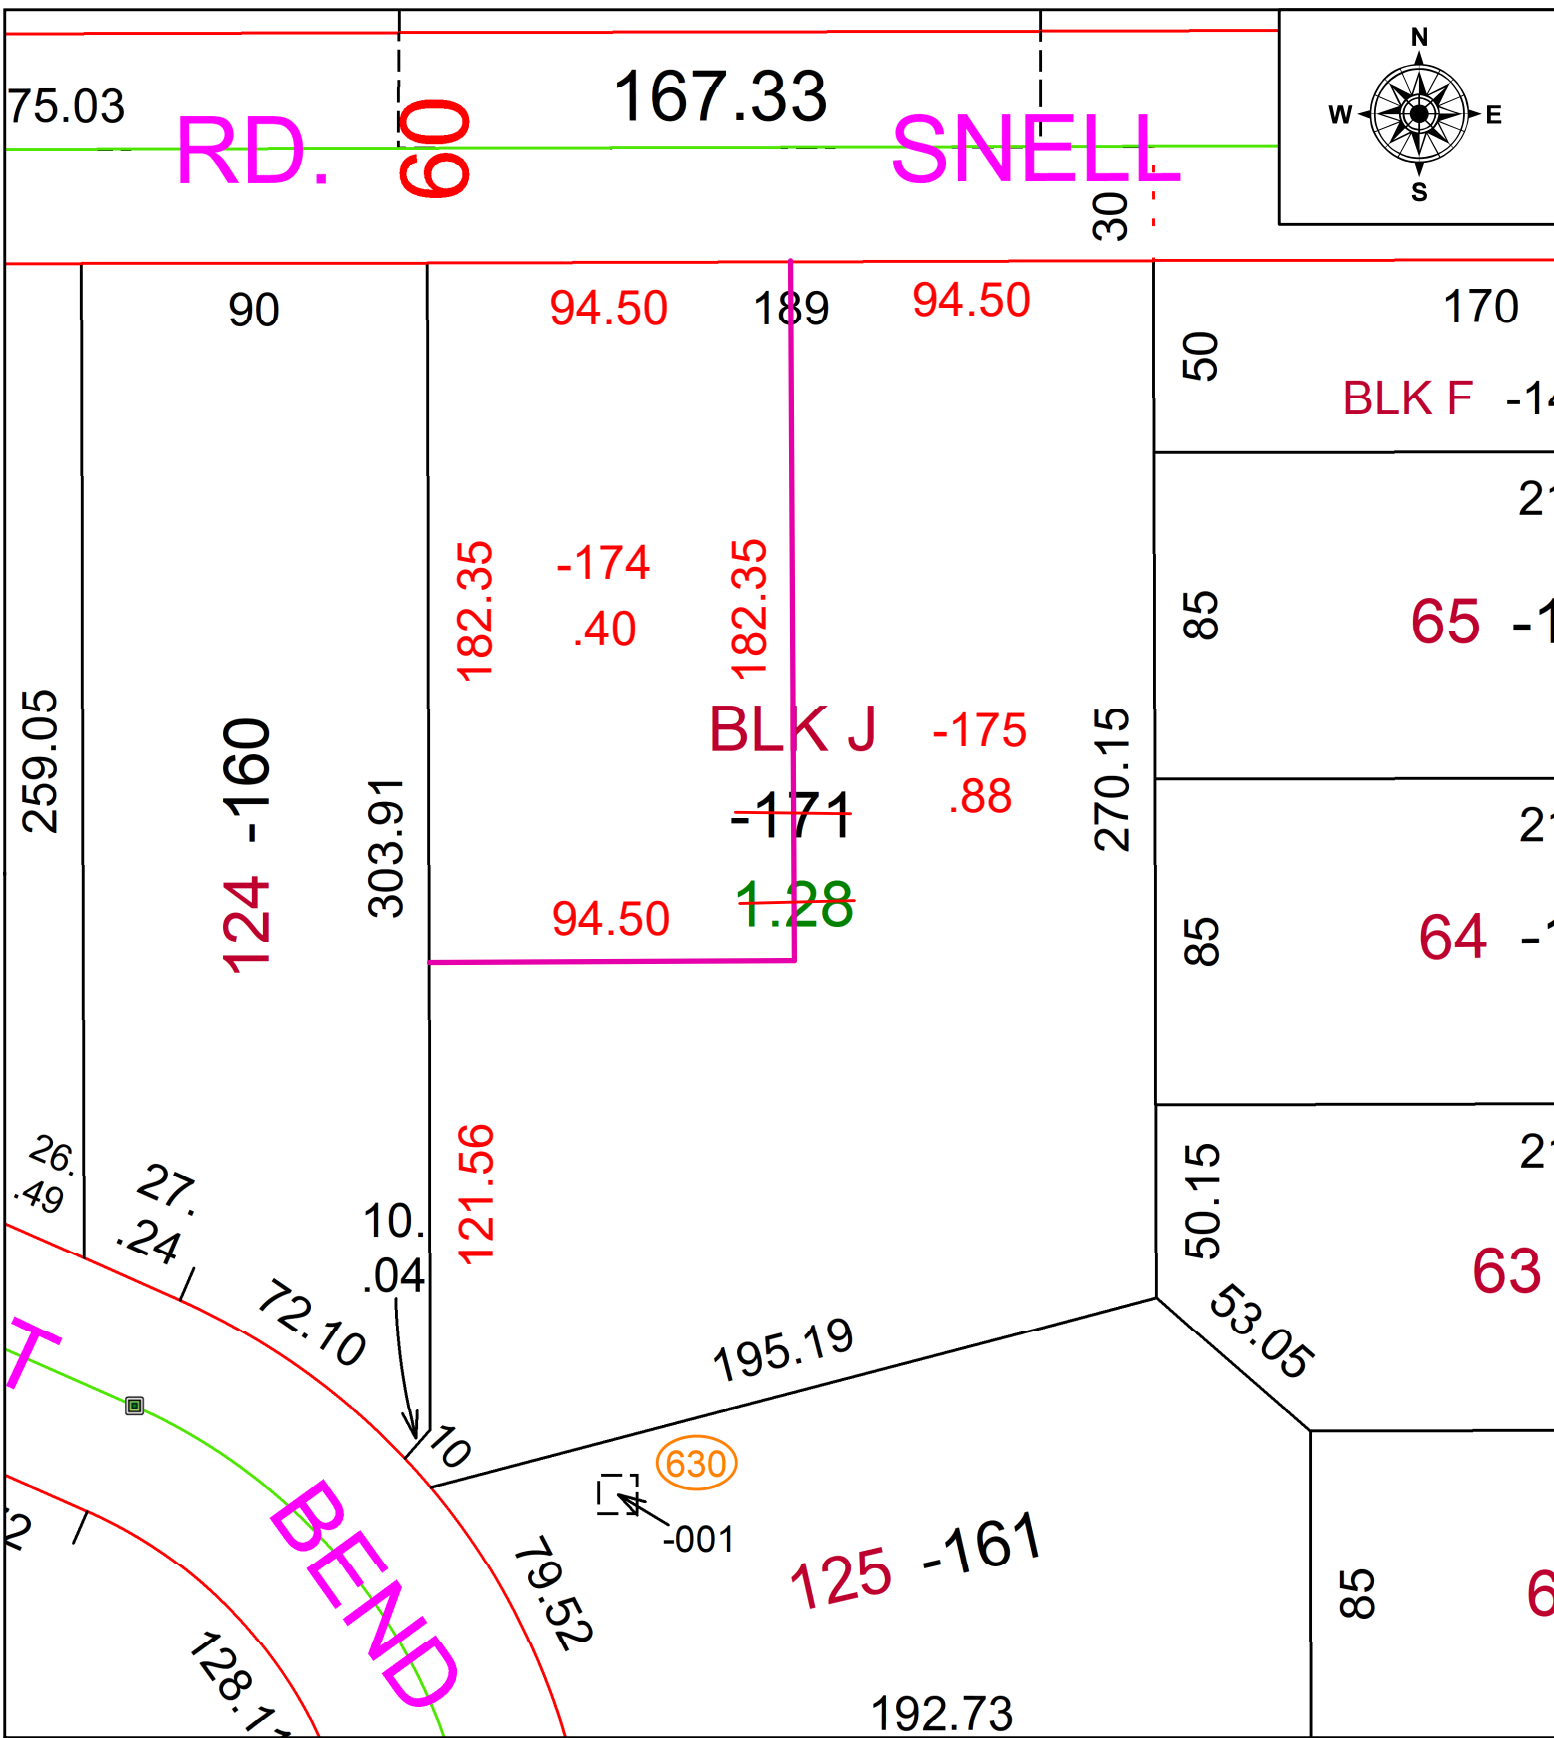

SPLITS/DEEDS PROCESSED
 LORAIN COUNTY TAX MAP DEPARTMENT
 226 MIDDLE AVE. ELYRIA, OH

SURVEYED BY: GEORGE A. HOFMANN SURV # 51002
 CLOSURE: 1: 23241
 MAP PAGE(S): 12-00-003
 APPROVED BY: AC DATE: August 31, 2023
 SCALE: 1 in = 50 ft PRIOR INSTRUMENT: 2015- 0543987