
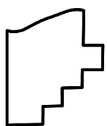


PARENT PARCEL: 07-00-008-116-003, 07-00-009-101-060, & 07-00-016-112-030

CHILD PARCEL: N/A ACREAGE CORRECTION PER DAVID A. BRUNKHORST

STARTING POINT: N/A

21-04745-C

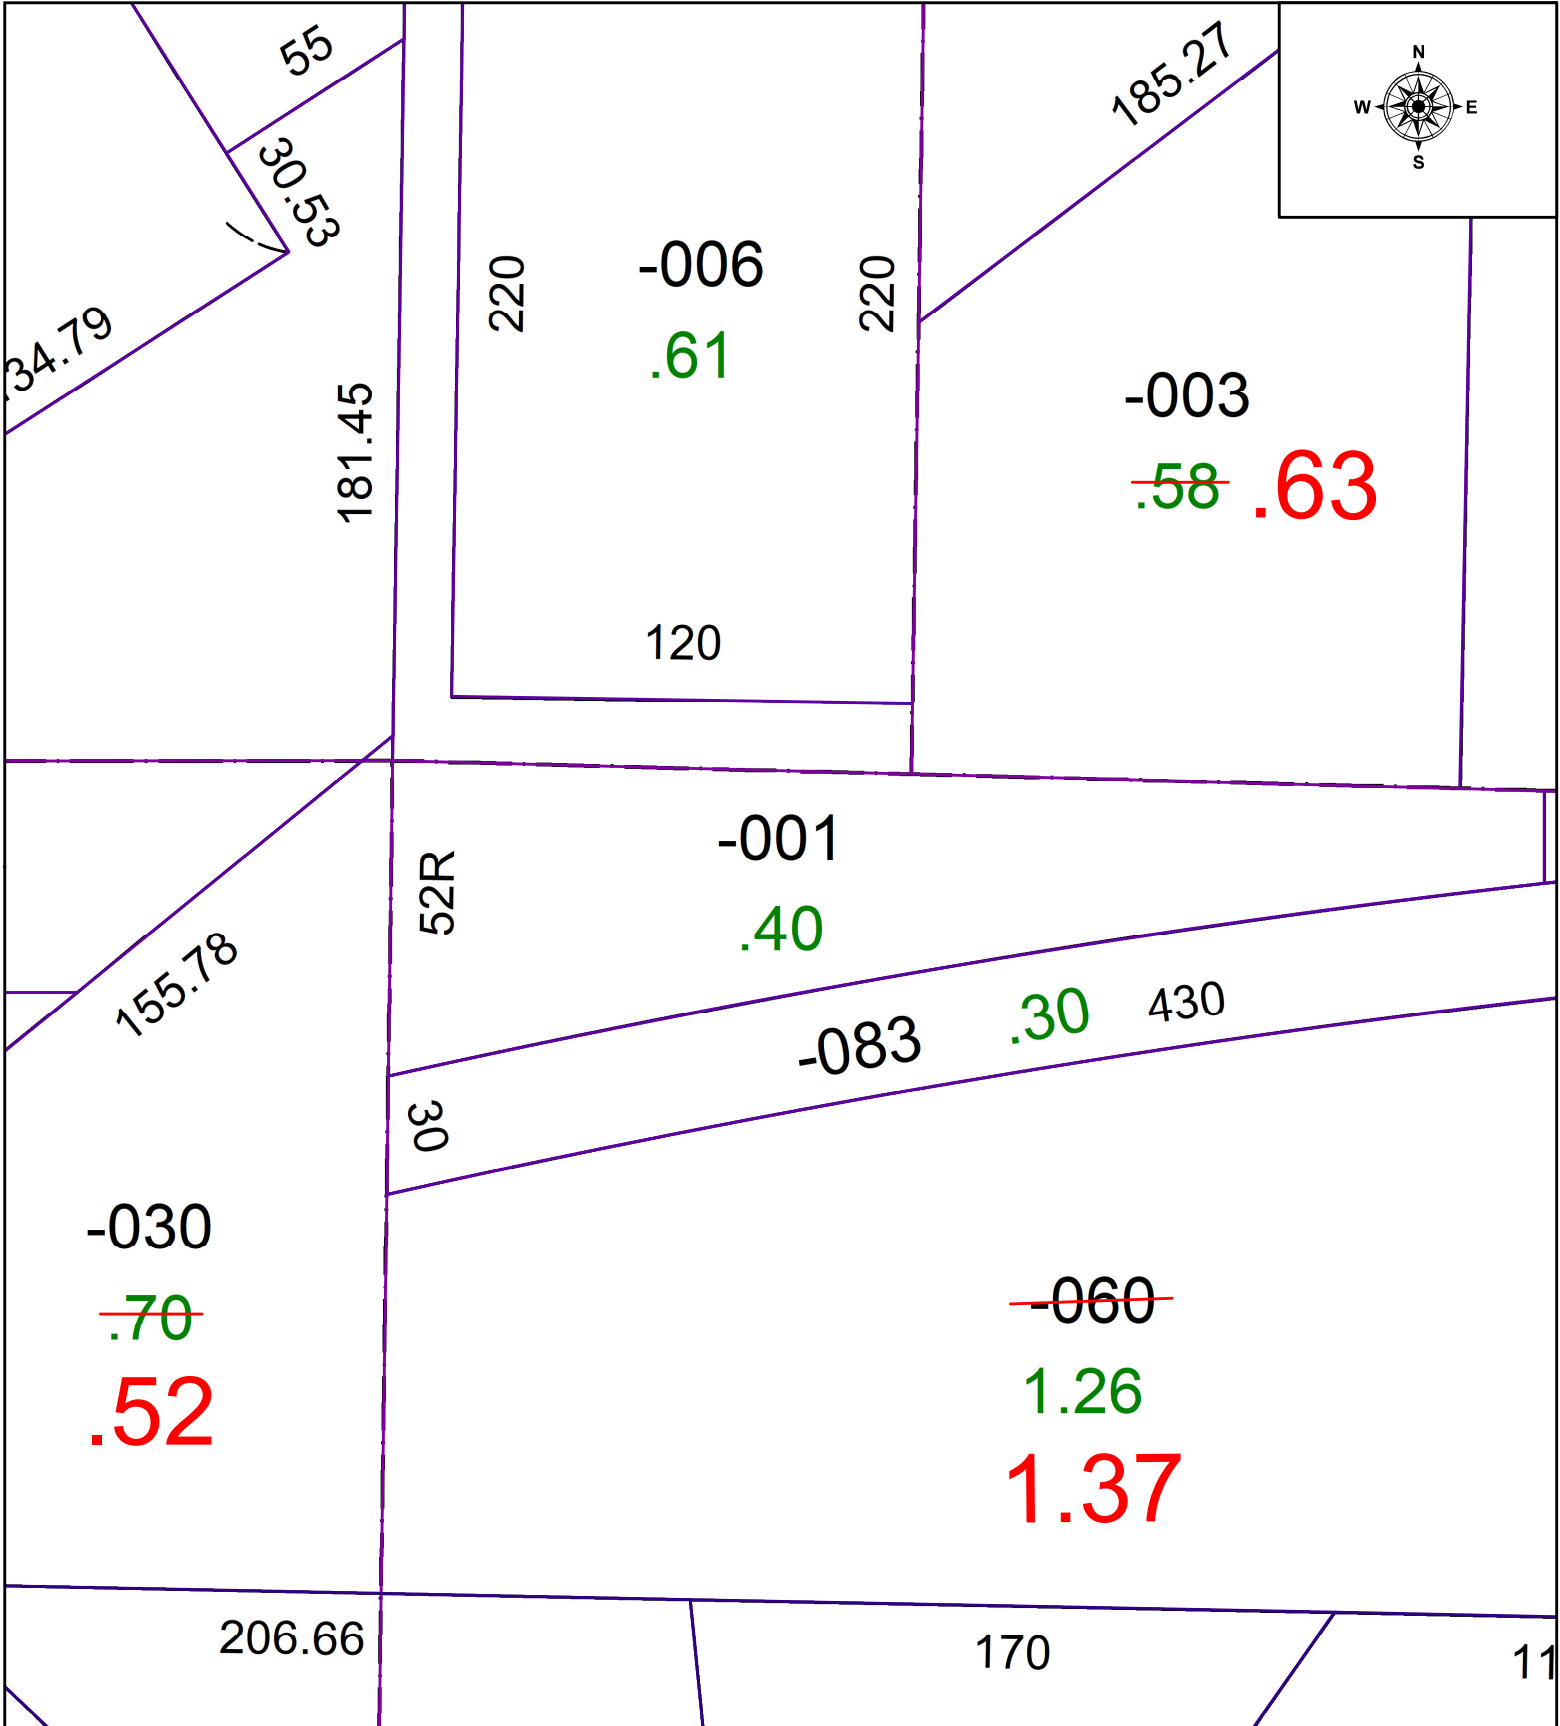

SPLITS/DEEDS PROCESSED
LORAIN COUNTY TAX MAP DEPARTMENT
226 MIDDLE AVE. ELYRIA, OH

SURVEYED BY: DAVID A. BRUNKHORST

CLOSURE: N/A

MAP PAGE(S): 07-00-009

APPROVED BY: WRZ DATE: 12/14/2021

SCALE: 1" = 50

PRIOR INSTRUMENT: 2008-0242285