


PARENT PARCEL: 08-12-019-000-025

AC CORR PER SURVEYOR BRENT ANDERSON


23-04745

CHILD PARCEL: 08-12-019-000-027, -028, -029, 08-12-002-000-053, & -054

STARTING POINT: MAG NAIL @ INTERSECTION OF TRACT 12, O.L. 2, 18, & 19

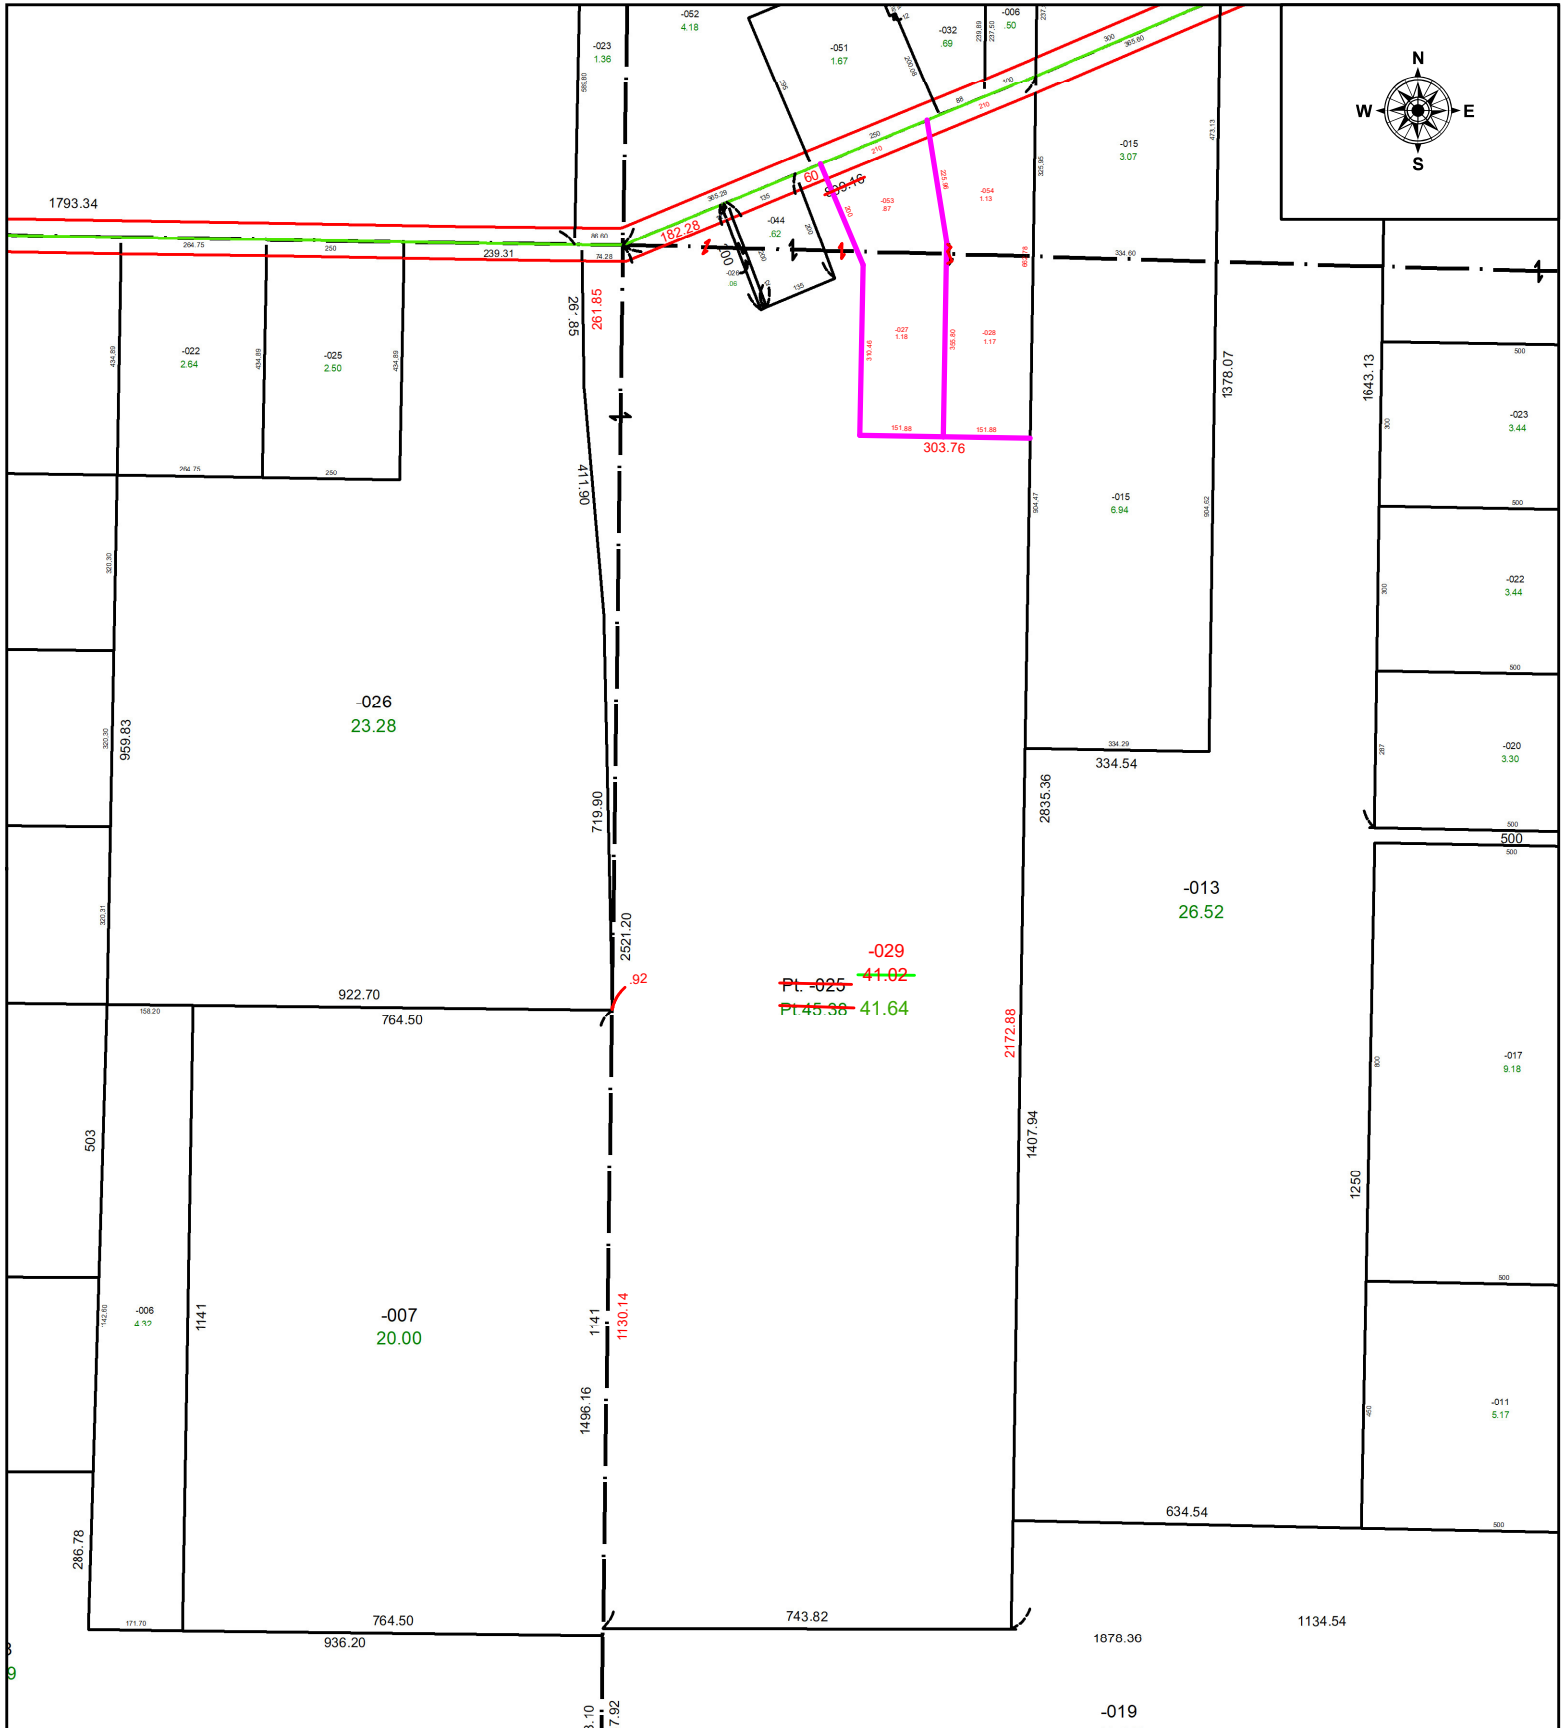

~~Pt. -025~~ 41.02
~~Pt. -029~~ 41.64

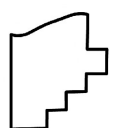

SPLITS/DEEDS PROCESSED
 LORAIN COUNTY TAX MAP DEPARTMENT
 226 MIDDLE AVE. ELYRIA, OH

SURVEYED BY: BRENT ANDERSON SURVEY # 51004
 CLOSURE: 1:460275
 MAP PAGE(S): 08-12-019
 APPROVED BY: WRZ DATE: 9/7/2023
 SCALE: 1" = 350 PRIOR INSTRUMENT: #2019-0713084