
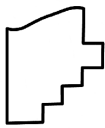
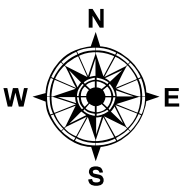


PARENT PARCEL: 15-00-035-000-111

CHILD PARCEL: **MAP CORRECTION ONLY**

STARTING POINT: S.W. CORNER OF VICKSBURG COURT CONDO PH. 4 P.V. 65, PG. 75

21-04748-C

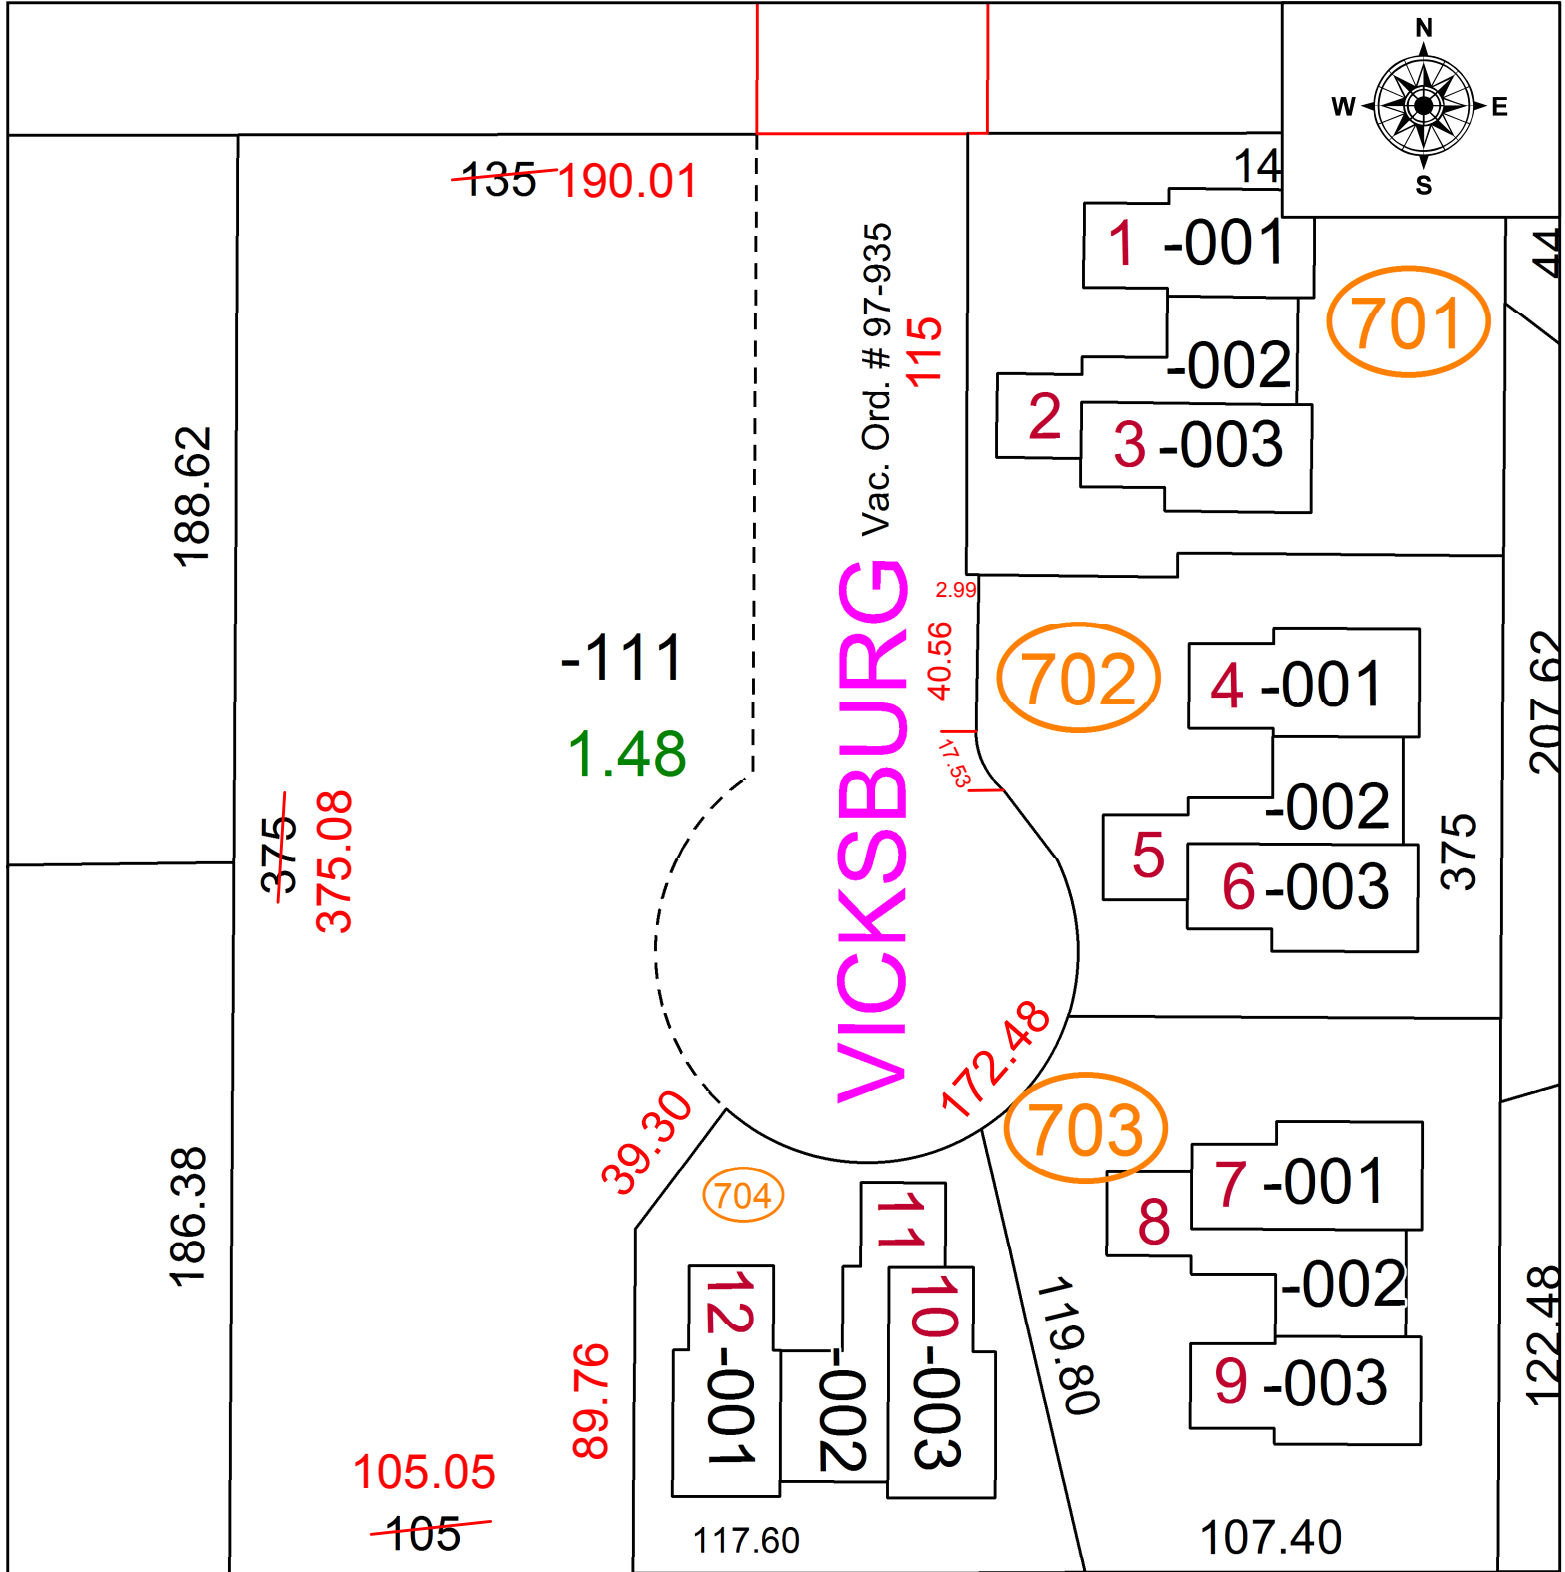

SPLITS/DEEDS PROCESSED
LORAIN COUNTY TAX MAP DEPARTMENT
226 MIDDLE AVE. ELYRIA, OH

SURVEYED BY: THOMAS SIMON
CLOSURE: 1: 2993237
MAP PAGE(S): 15-00-035
APPROVED BY: DMA DATE: 12/16/2021
SCALE: 1" = 50' PRIOR INSTRUMENT: 2007-0212770