


PARENT PARCEL: 09-00-086-110-044, -045

CHILD PARCEL: 09-00-086-110-062 **COMBINATION AND AC CORR PER SURV BY THOMAS SIMON**

STARTING POINT: C/L OF E VINE ST AND S PARK ST

21-04749-C

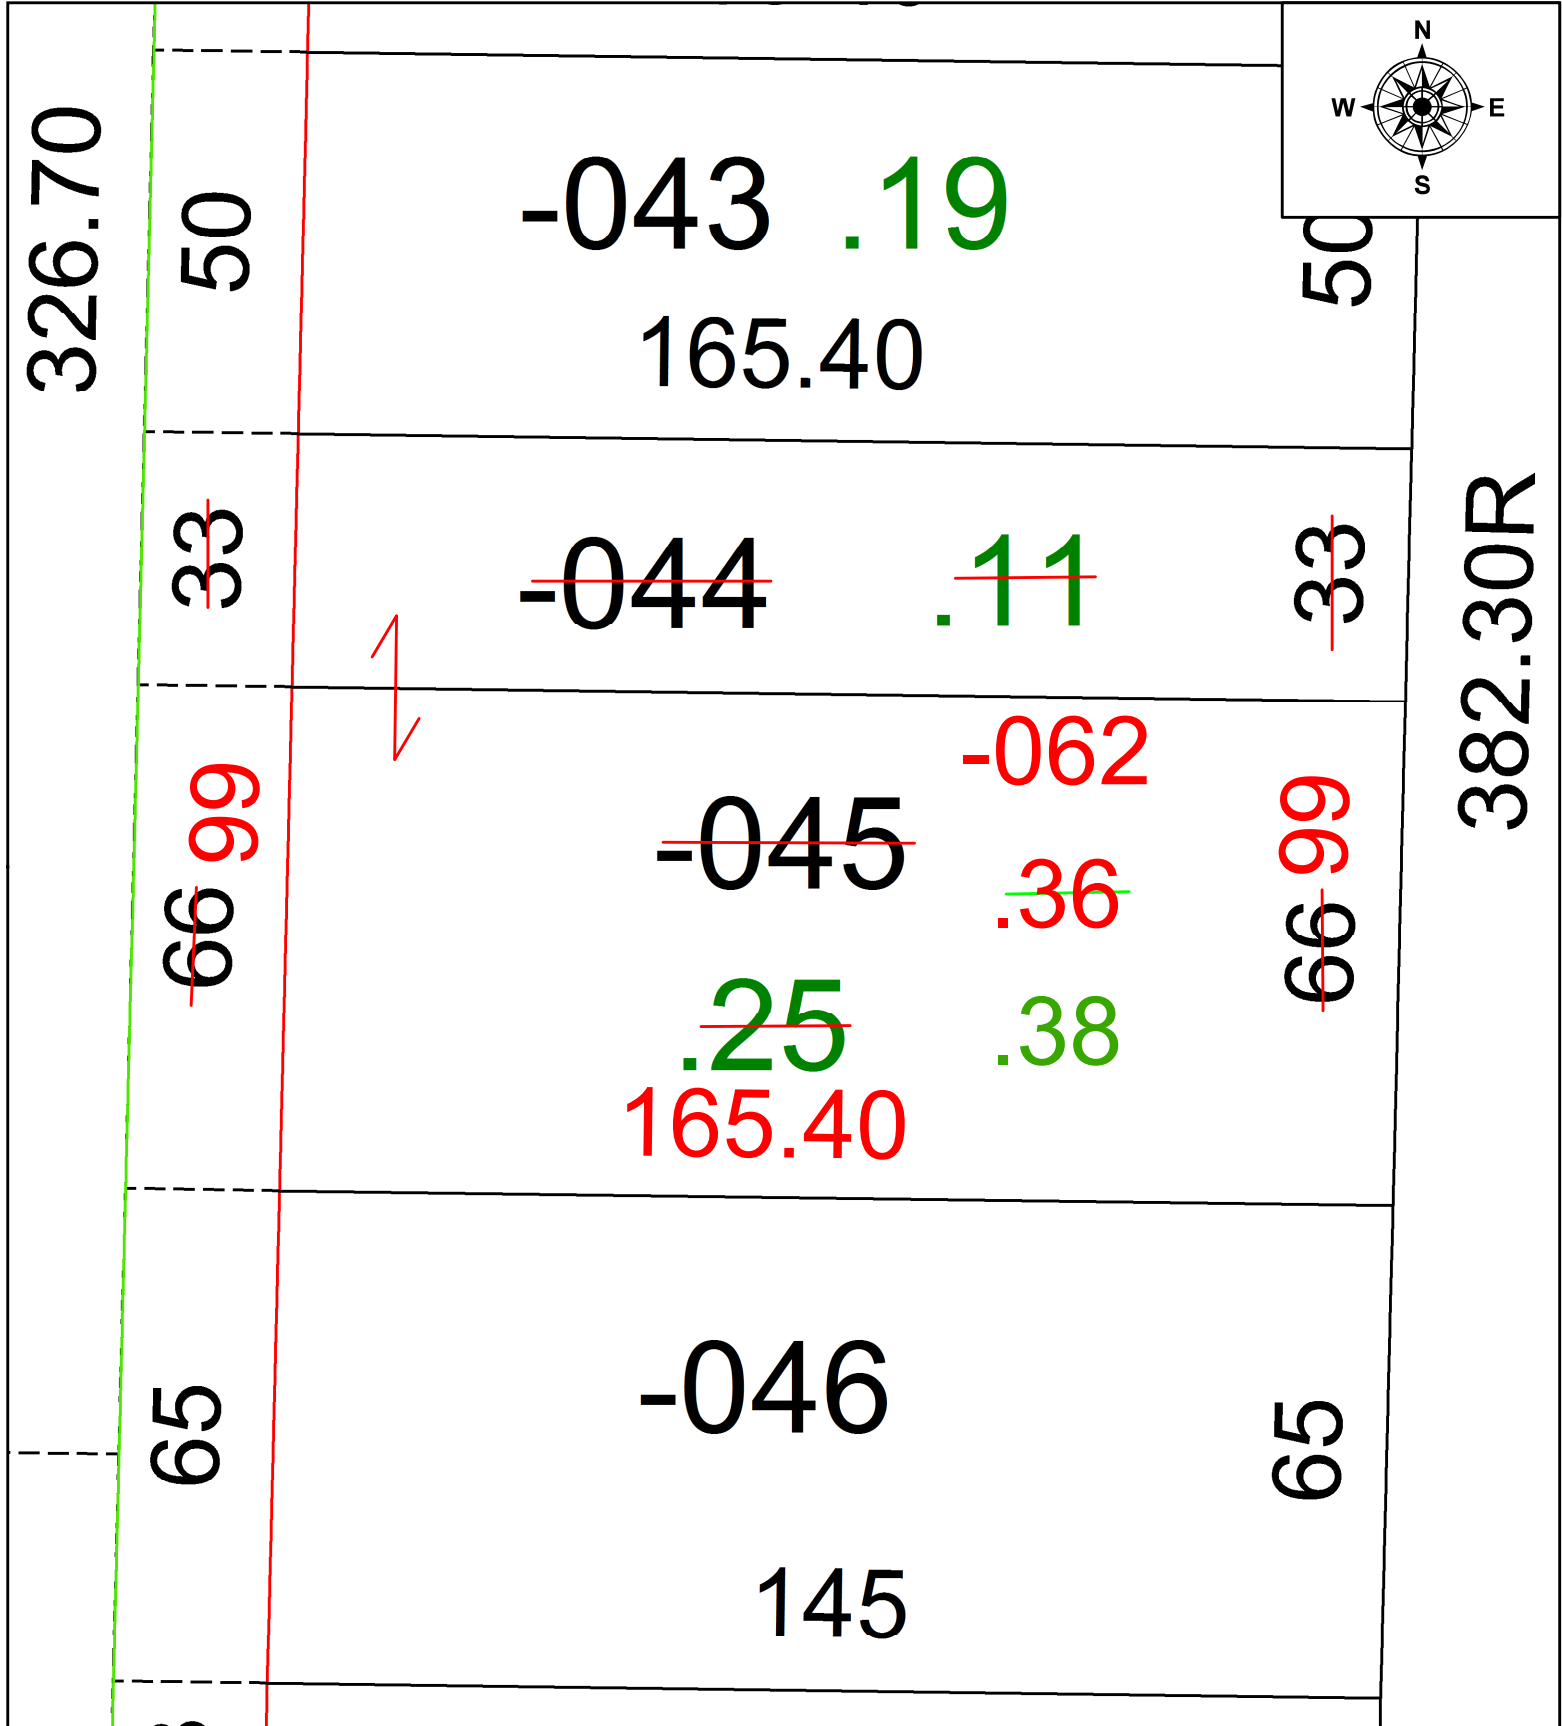

**SPLITS/DEEDS PROCESSED**  
LORAIN COUNTY TAX MAP DEPARTMENT  
226 MIDDLE AVE. ELYRIA, OH

SURVEYED BY: THOMAS A. SIMON

CLOSURE: 1: 2147483648

MAP PAGE(S): 09-00-086-B

APPROVED BY: AC DATE: 12/16/2021

SCALE: 1" = 25' PRIOR INSTRUMENT: 2021- 0827062