


PARENT PARCEL: 06-25-002-111-071 & -208

CHILD PARCEL: 06-25-002-111-266

STARTING POINT: N.E. CORNER OF S/L 245 PARKWOOD ESTATES 3 3 P.V. 25 PG. 84

23-04749

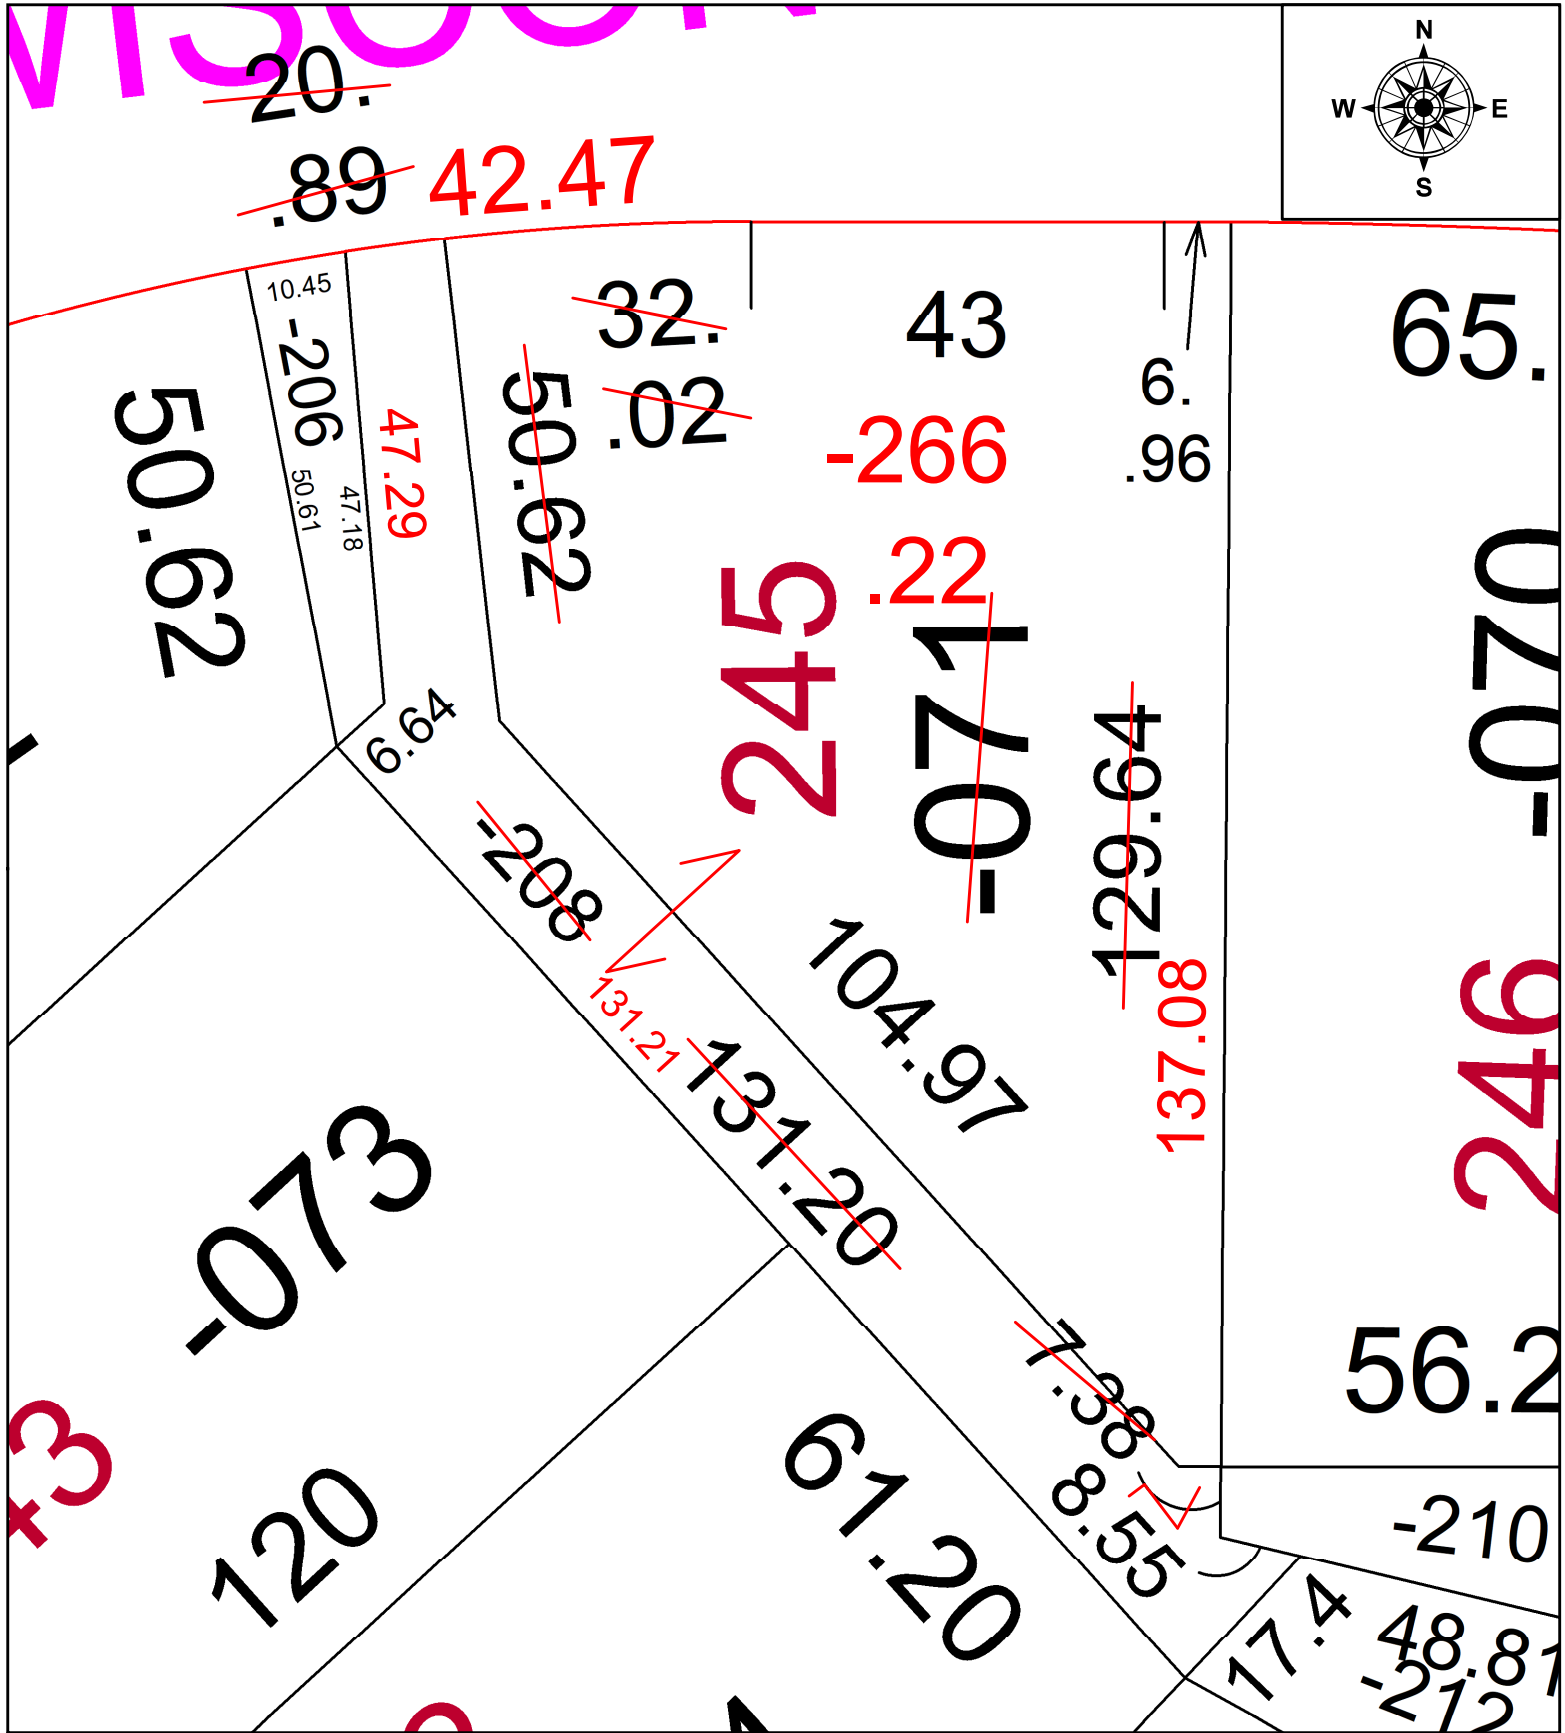

SPLITS/DEEDS PROCESSED
LORAIN COUNTY TAX MAP DEPARTMENT
226 MIDDLE AVE. ELYRIA, OH

SURVEYED BY: THEODORE SPILLMAN SURVEY #: 51011
CLOSURE: 1:58965
MAP PAGE(S): 06-25-002
APPROVED BY: DMA DATE: 9/12/2023
SCALE: 1" = 20' PRIOR INSTRUMENT: 2003-0949780