



PARENT PARCEL: 03-00-096-108-065
CHILD PARCEL: 03-00-096-108-066 & -067
STARTING POINT: N/A

21-04756-U

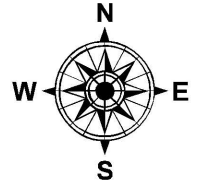

UNCOMBINATION PER INSTRU. #
2006-0170234 & 1995-0355267

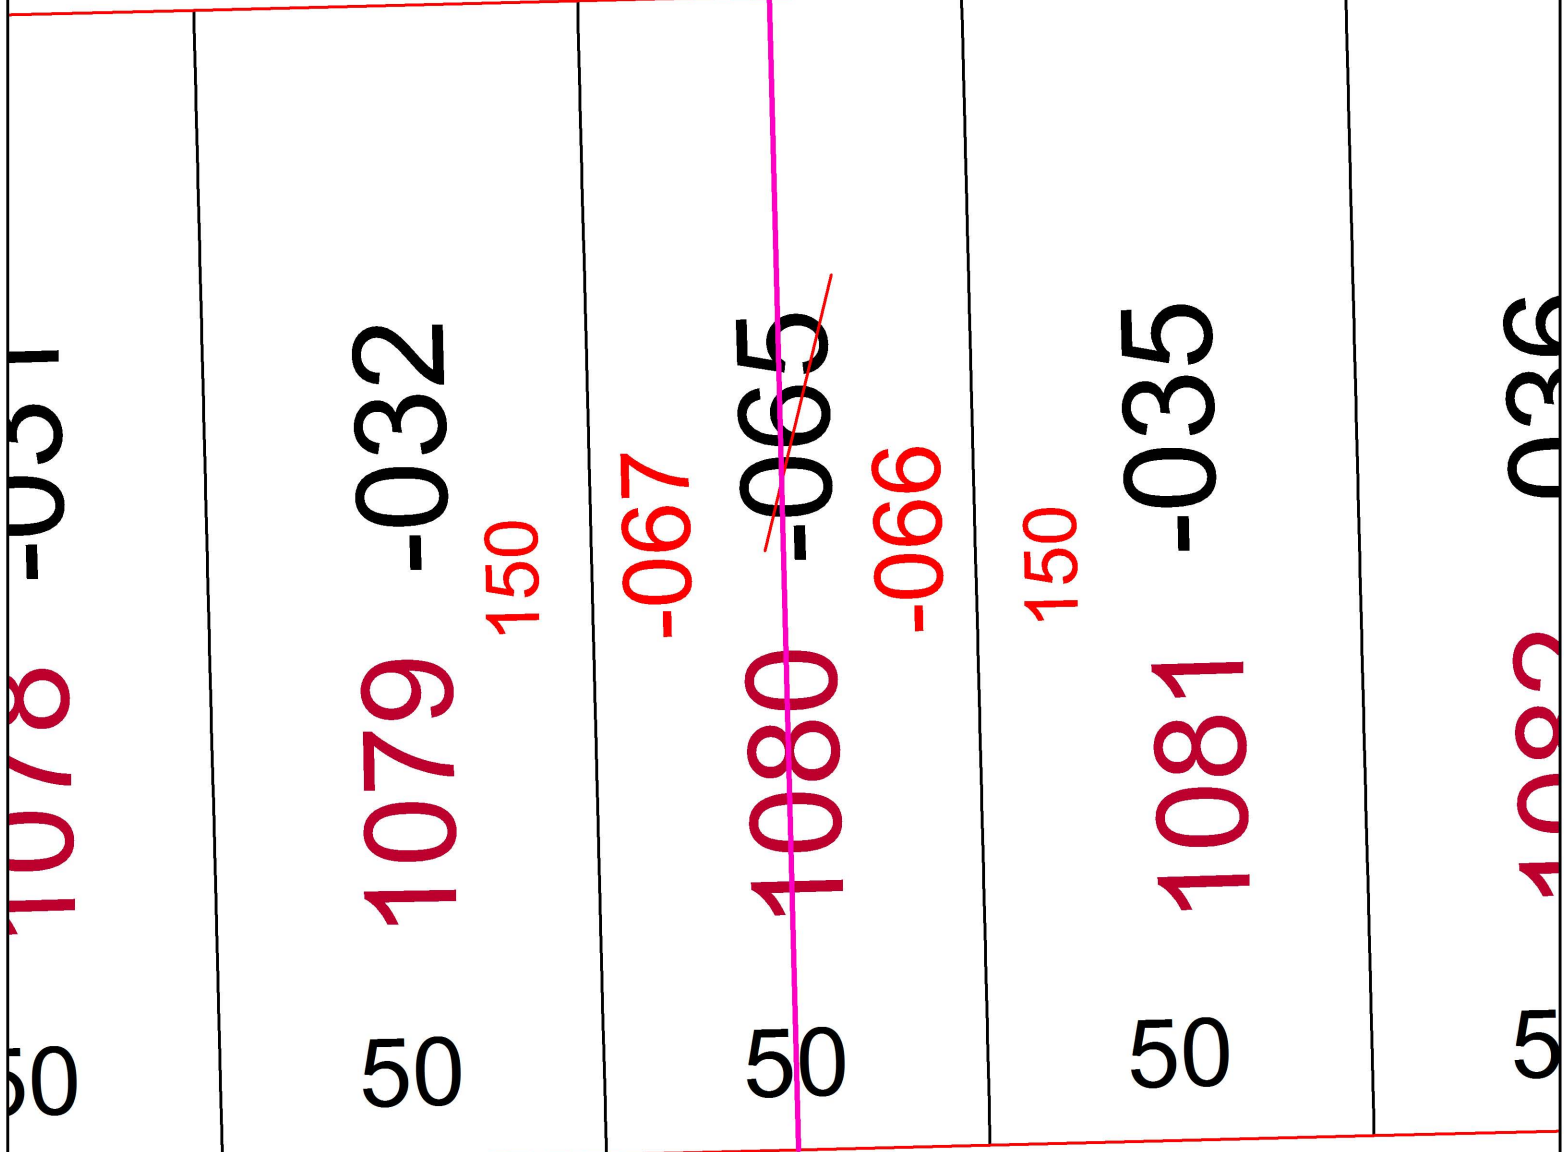

25 25



SPLITS/DEEDS PROCESSED
LORAIN COUNTY TAX MAP DEPARTMENT
226 MIDDLE AVE. ELYRIA, OH

SURVEYED BY: N/A
CLOSURE: N/A
MAP PAGE(S): 03-00-096
APPROVED BY: DMA DATE: 12/29/2021
SCALE: 1" = 25' PRIOR INSTRUMENT: 2006-0170234