


PARENT PARCEL: 06-25-030-102-023

CHILD PARCEL: **FRONTAGE & DEPTH TO AC CORR PER SURV BY WILFREDO BARBOSA**

22-04759-C

STARTING POINT: SE CORNER OF S/L 136

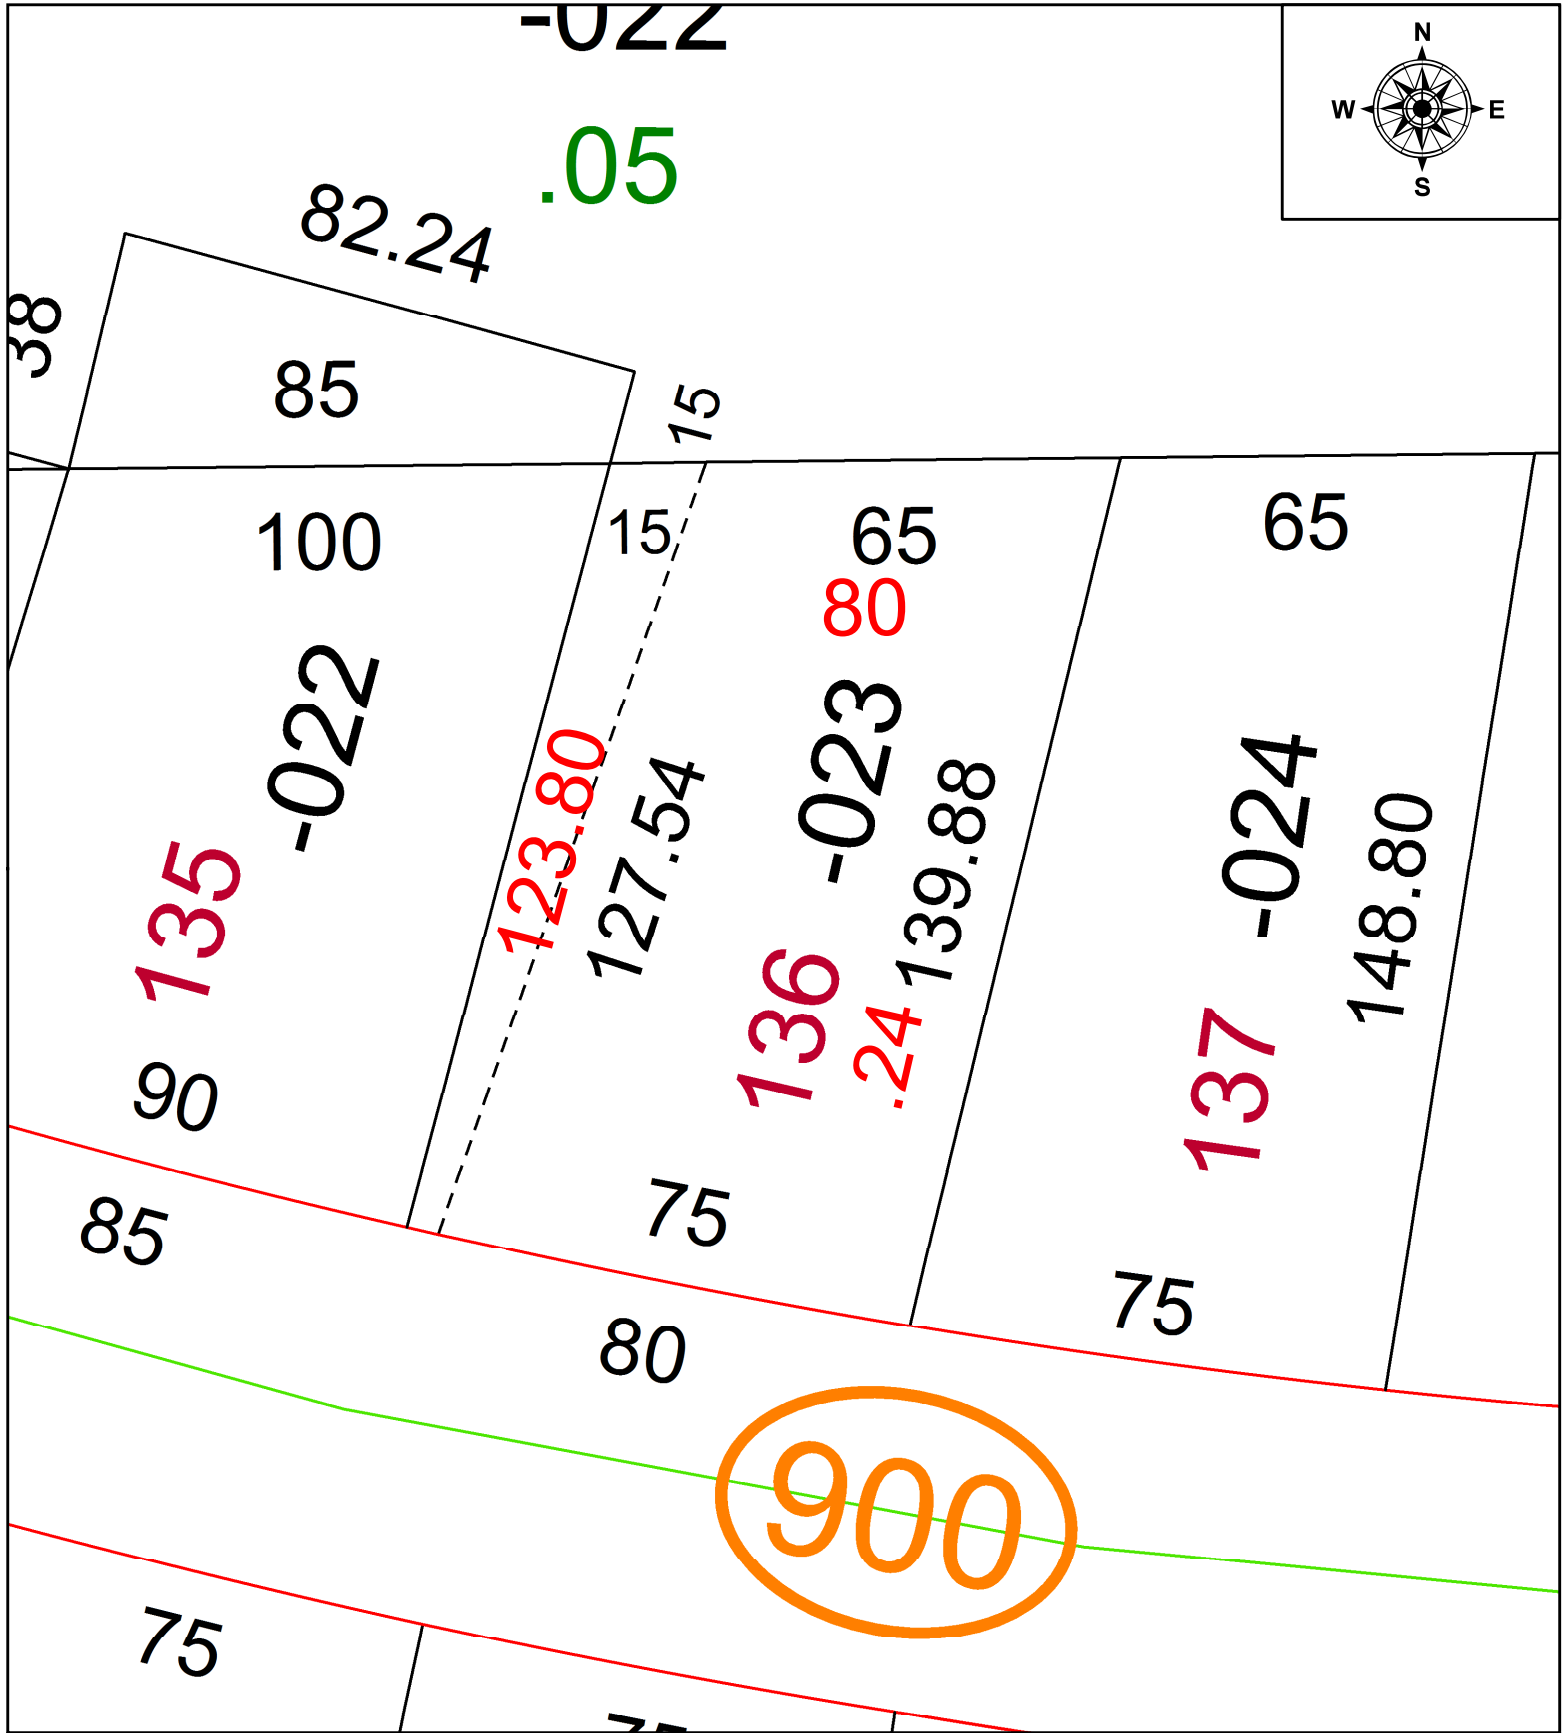

SPLITS/DEEDS PROCESSED
 LORAIN COUNTY TAX MAP DEPARTMENT
 226 MIDDLE AVE. ELYRIA, OH

SURVEYED BY: WILFREDO BARBOSA

CLOSURE: 1: 169573

MAP PAGE(S): 06-52

APPROVED BY: AC DATE: 1/3/2022

SCALE: 1" = 30 PRIOR INSTRUMENT: 2020- 0747297