


PARENT PARCEL: 16-00-018-102-040, -041, & -031

CHILD PARCEL: 16-00-018-102-043, -044, -045, -031

AC CORR PER SURVYOR ANDREW PLANET



23-04761

STARTING POINT: PK NAIL @ INTERSECTION OF C/L OF GRAFTON RD & EAST LINE OF O.L. 18

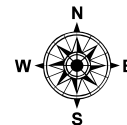

-030
33.96

870.82

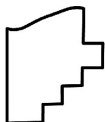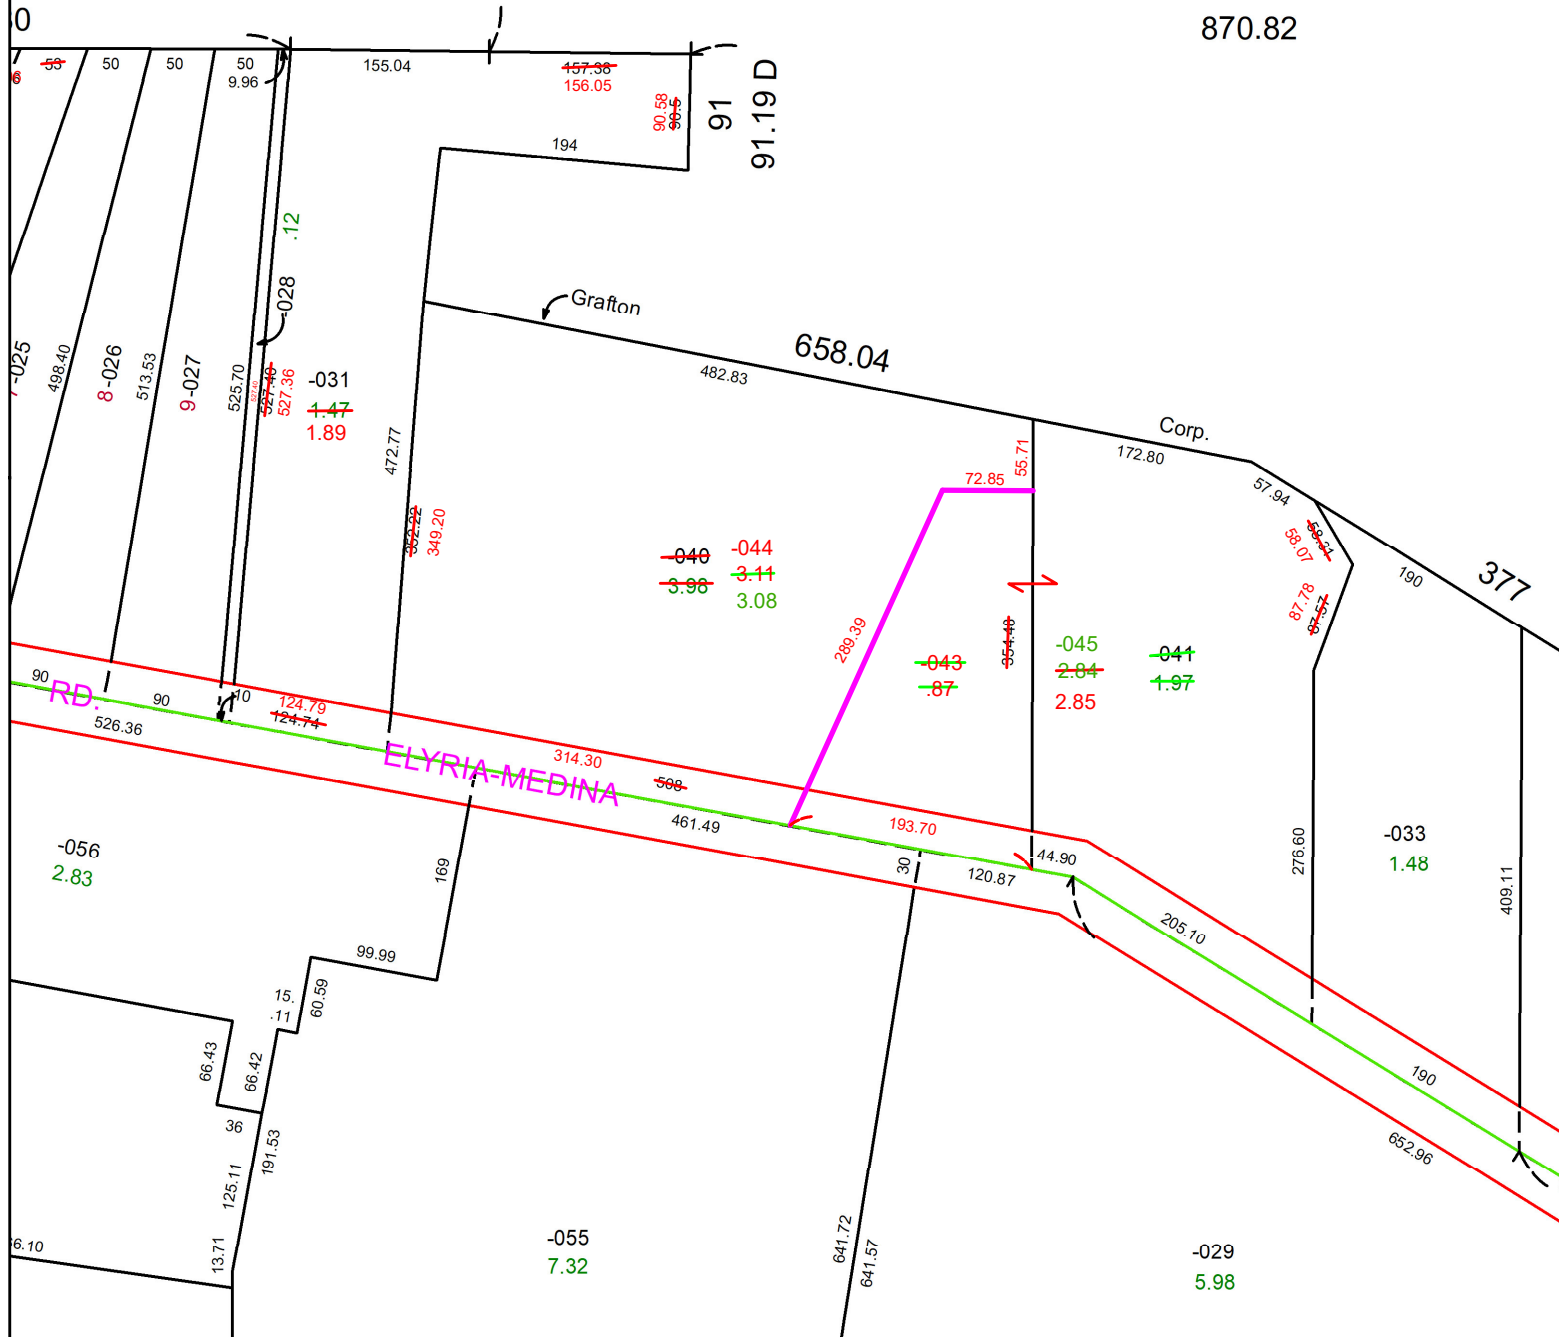

SPLITS/DEEDS PROCESSED
LORAIN COUNTY TAX MAP DEPARTMENT
226 MIDDLE AVE. ELYRIA, OH

SURVEYED BY: ANDREW PLANET SURVEY #51046
CLOSURE: 1: 170427
MAP PAGE(S): 16-00-018
APPROVED BY: WRZ DATE: 10/31/2023
SCALE: 1" = 150 PRIOR INSTRUMENT: #2018-0692932