
**PARENT PARCEL:** 05-00-023-112-010

CHILD PARCEL: N/A FRONTAGE AND DEPTH TO ACREAGE PER SCOTT J. CASEY

STARTING POINT: INTERSECTION OF NORTH SIDE OF CLEVELAND AVE. & EAST SIDE OF LINCOLN ST.

22-04763-C

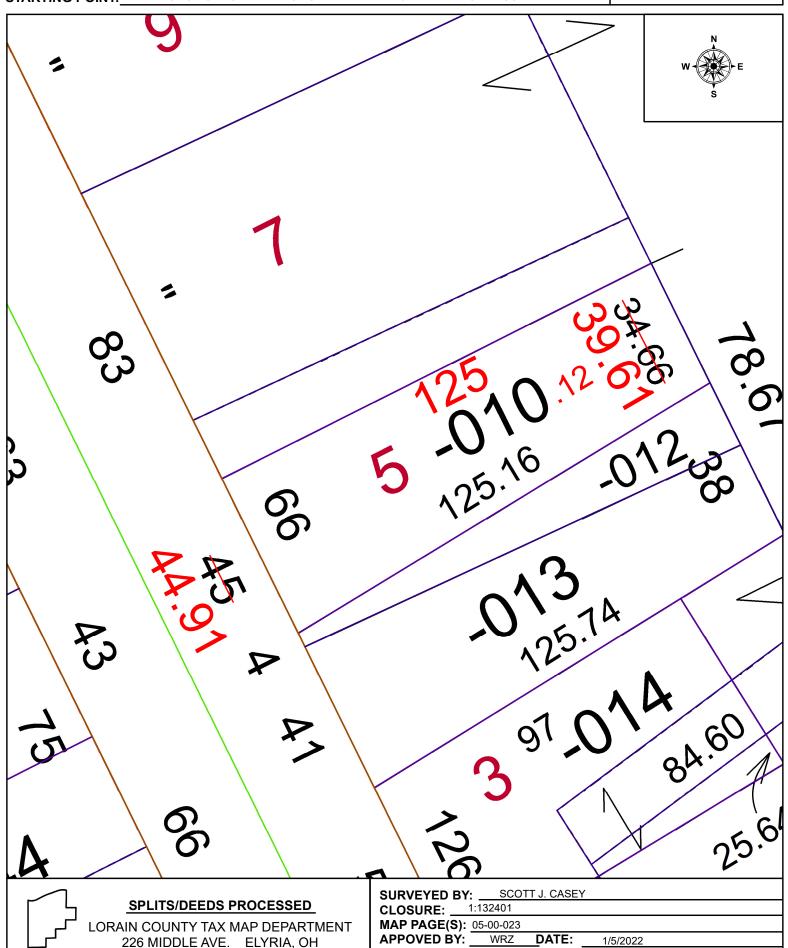

SCALE:

1" = 25

PRIOR INSTRUMENT:

2020-0758570