
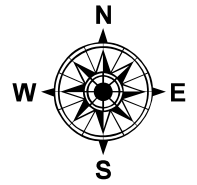


PARENT PARCEL: 09-00-087-104-024

CHILD PARCEL: **AC CORR PER SURV BY BRENT D. ANDERSON**

STARTING POINT: C/L OF E COLLEGE ST AND ORCHARD ST

22-04767-C

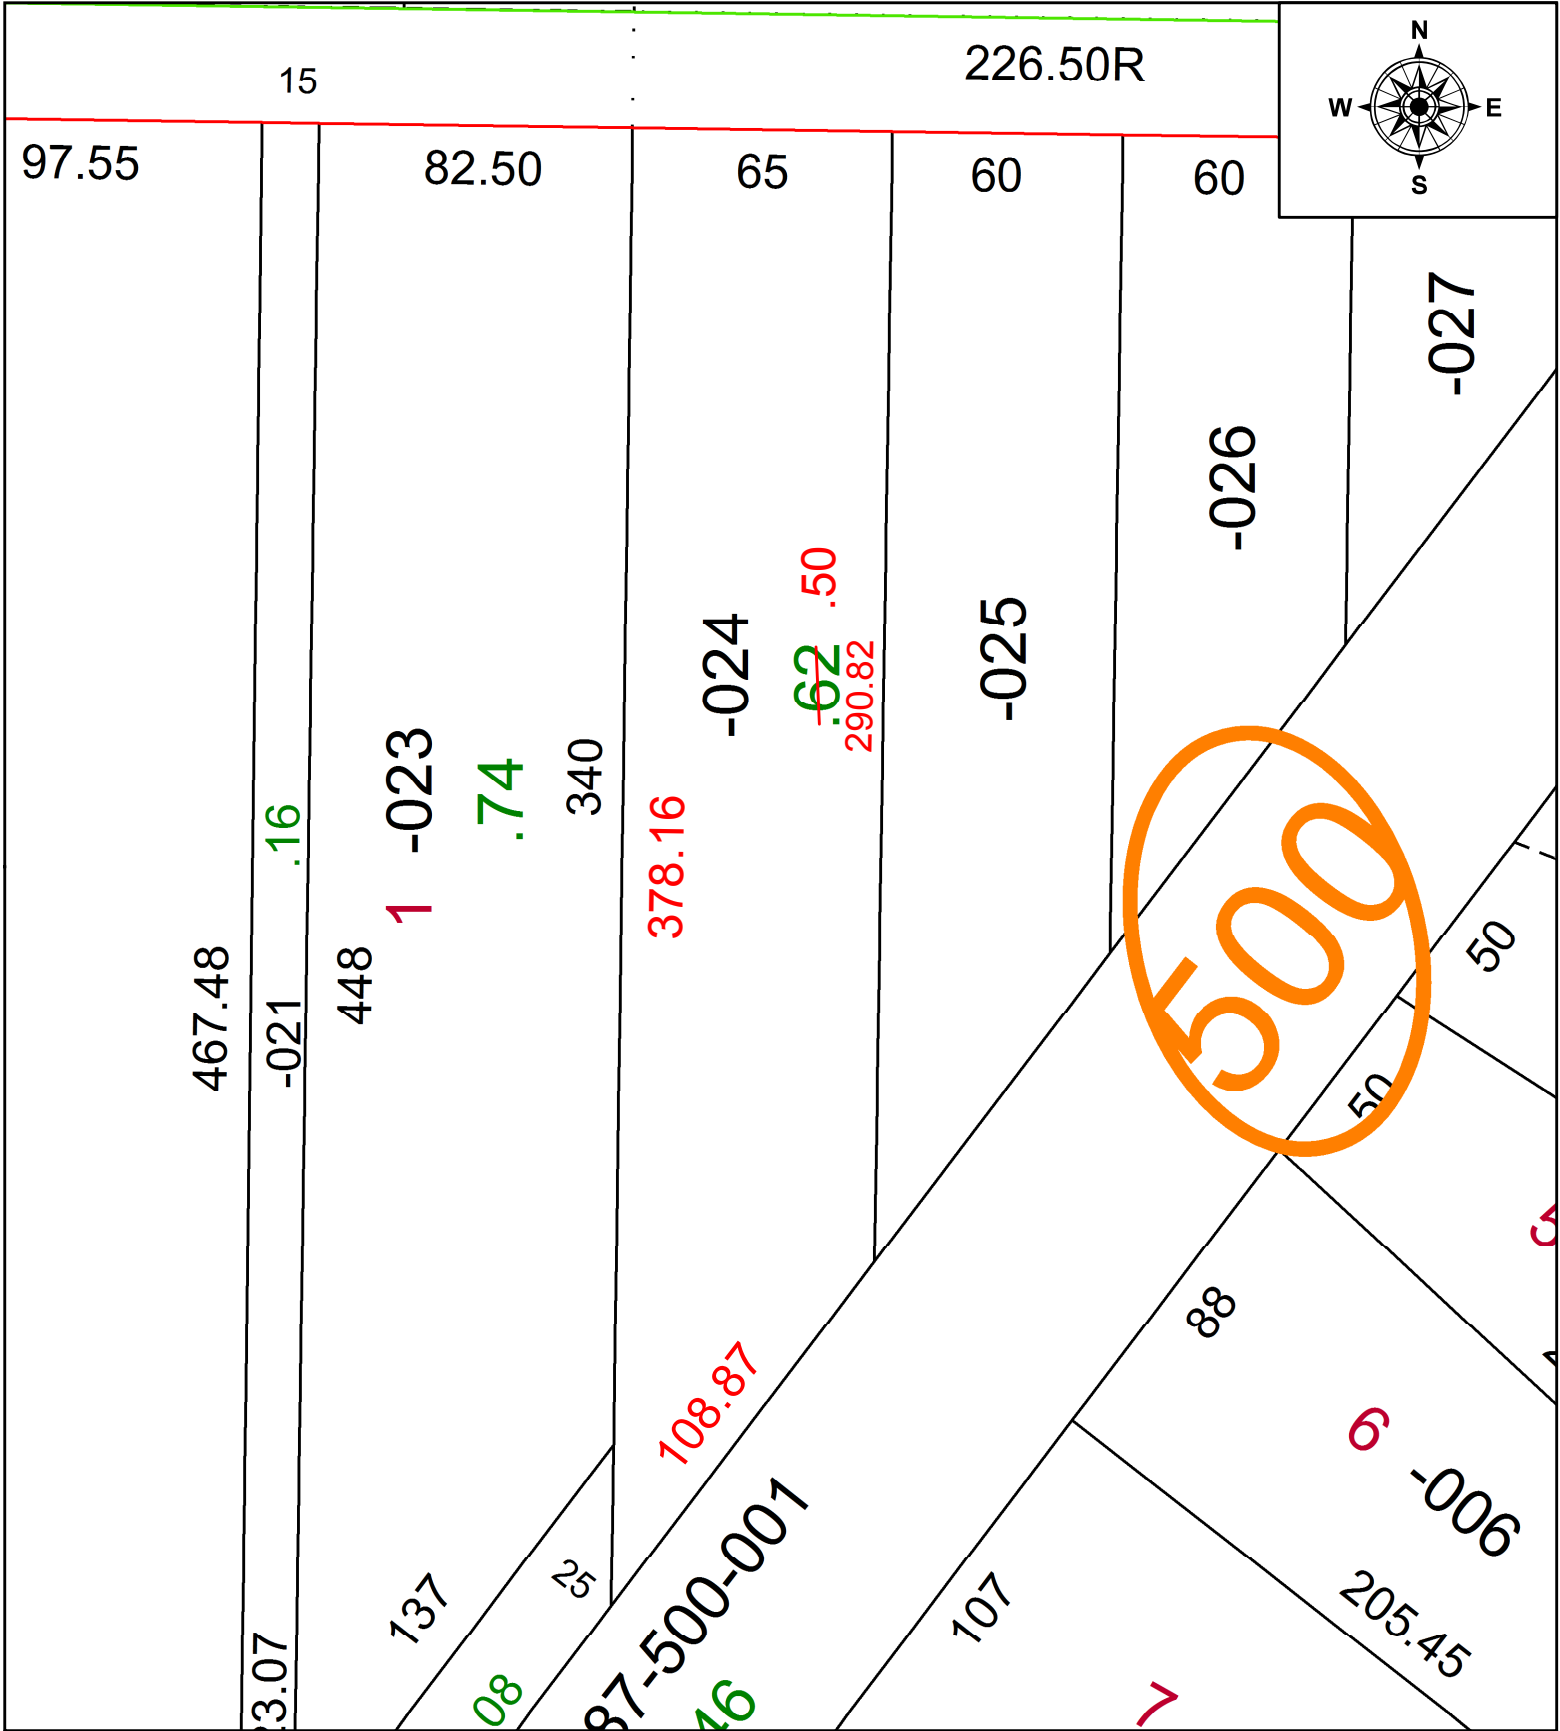

SPLITS/DEEDS PROCESSED
 LORAIN COUNTY TAX MAP DEPARTMENT
 226 MIDDLE AVE. ELYRIA, OH

SURVEYED BY: BRENT D. ANDERSON
 CLOSURE: 1: 290272
 MAP PAGE(S): 09-00-087-A
 APPROVED BY: AC DATE: 1/13/2022
 SCALE: 1" = 50 PRIOR INSTRUMENT: 2016- 0606785