


PARENT PARCEL: 09-00-045-000-009

CHILD PARCEL: 09-00-045-000-010 & -011

AC CORR PER SURVEYOR TIMOTHY HOZALSKI

23-04767

STARTING POINT: BENT IRON PIN @ NORTHEAST CORNER OF O.L. 45 & C/L OF SR 58

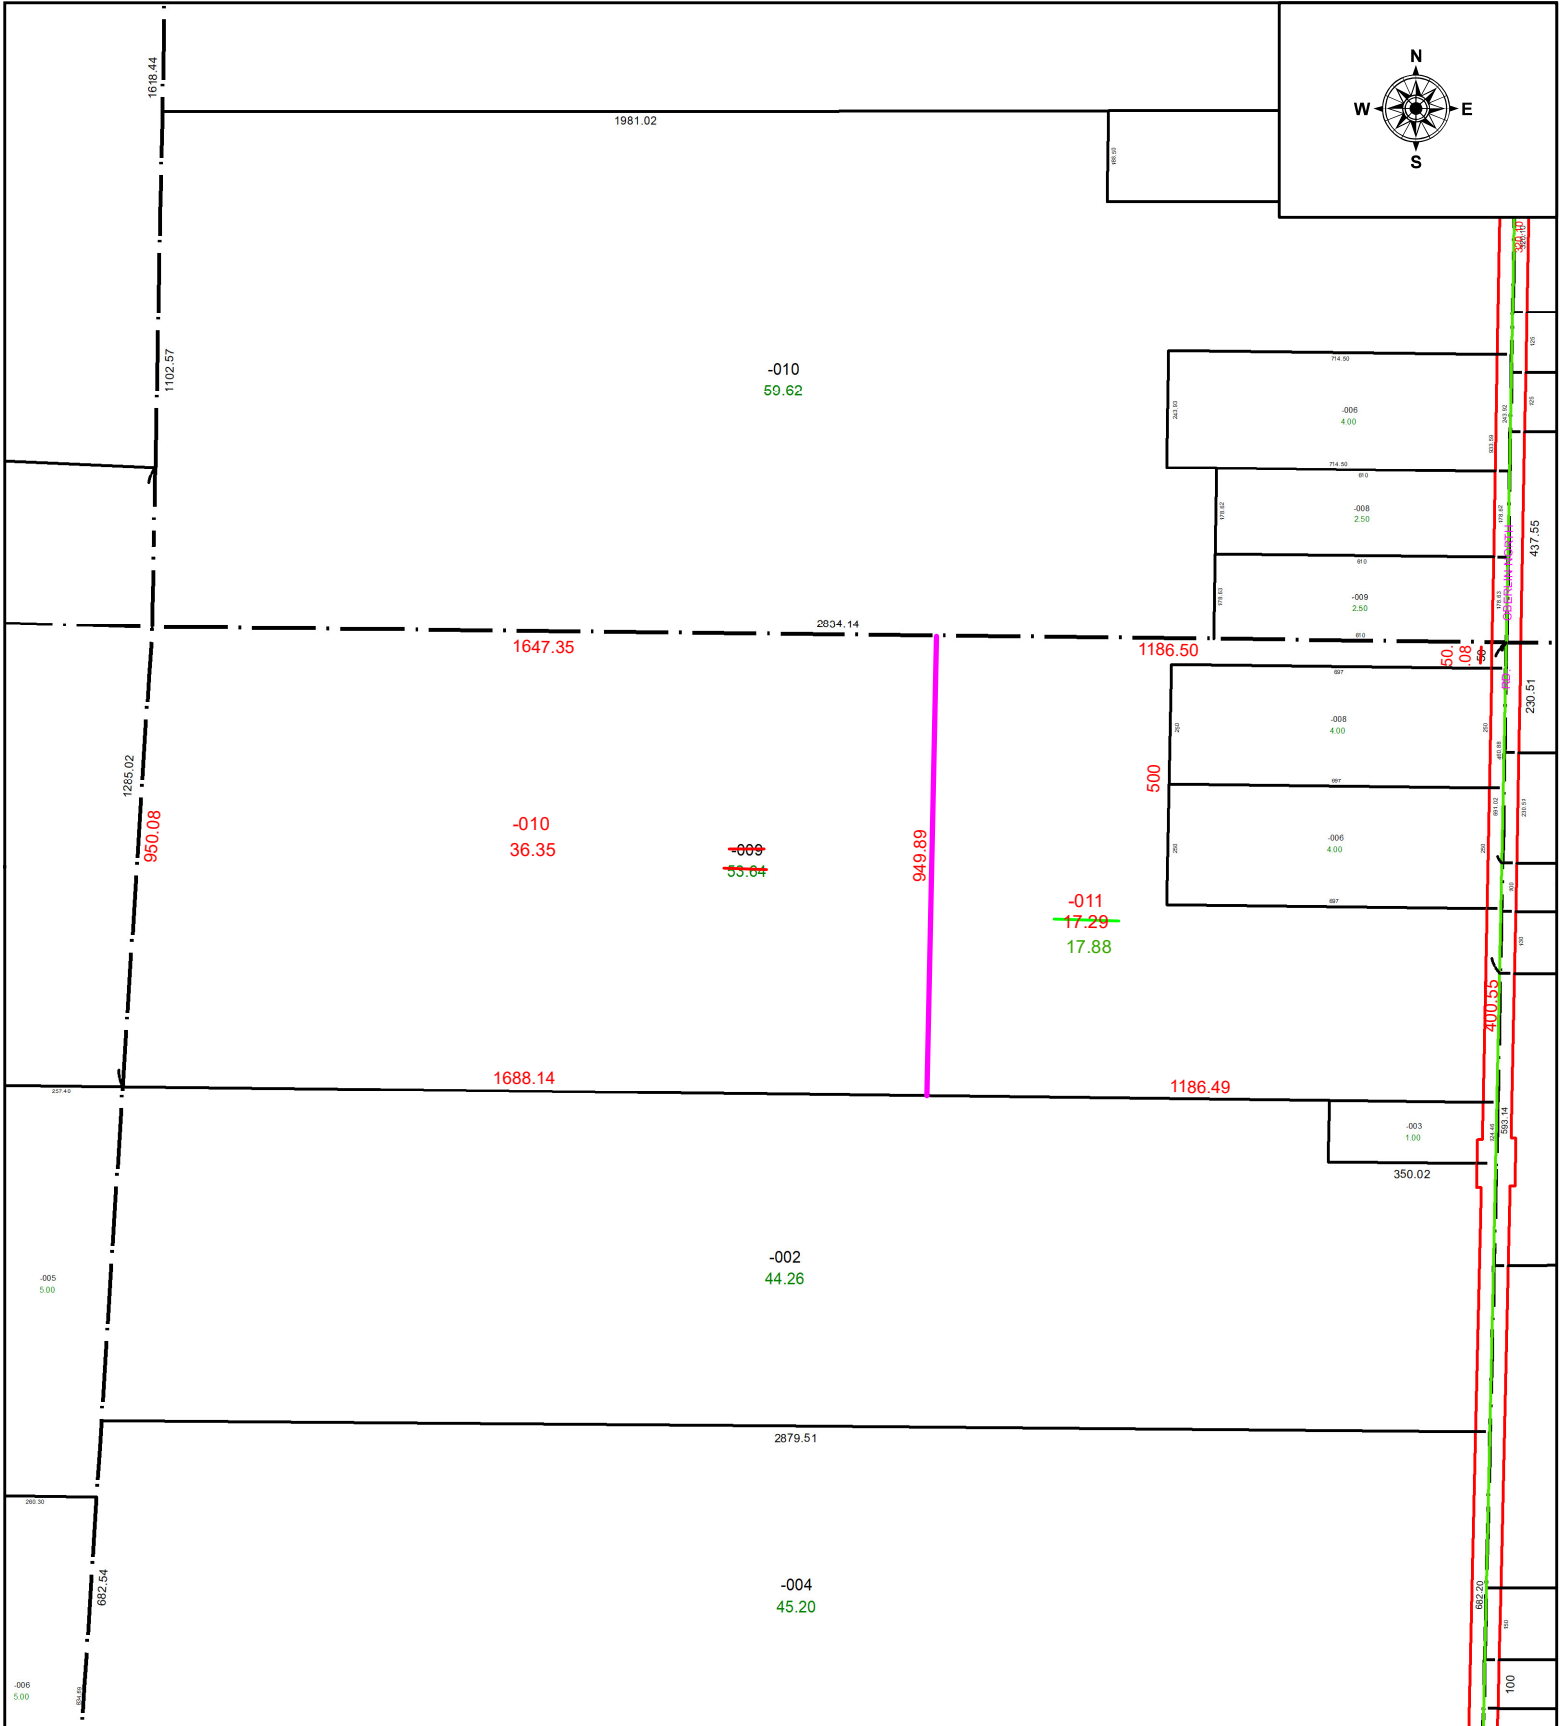

SPLITS/DEEDS PROCESSED
 LORAIN COUNTY TAX MAP DEPARTMENT
 226 MIDDLE AVE. ELYRIA, OH

SURVEYED BY: TIMOTHY HOZALSKI SURVEY #51036
 CLOSURE: 1: 535775
 MAP PAGE(S): 09-00-045
 APPROVED BY: WRZ DATE: 10/25/2023
 SCALE: 1" = 400 PRIOR INSTRUMENT: #2006-0127215