




PARENT PARCEL: 05-00-059-101-002 & -014

CHILD PARCEL: 05-00-059-101-023

AC CORR PER SURVEYOR THOMAS SIMON

23-04770

STARTING POINT: IRON PIPE @ NORTHWESTERLY CORNER OF O.L. 59

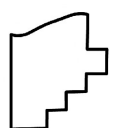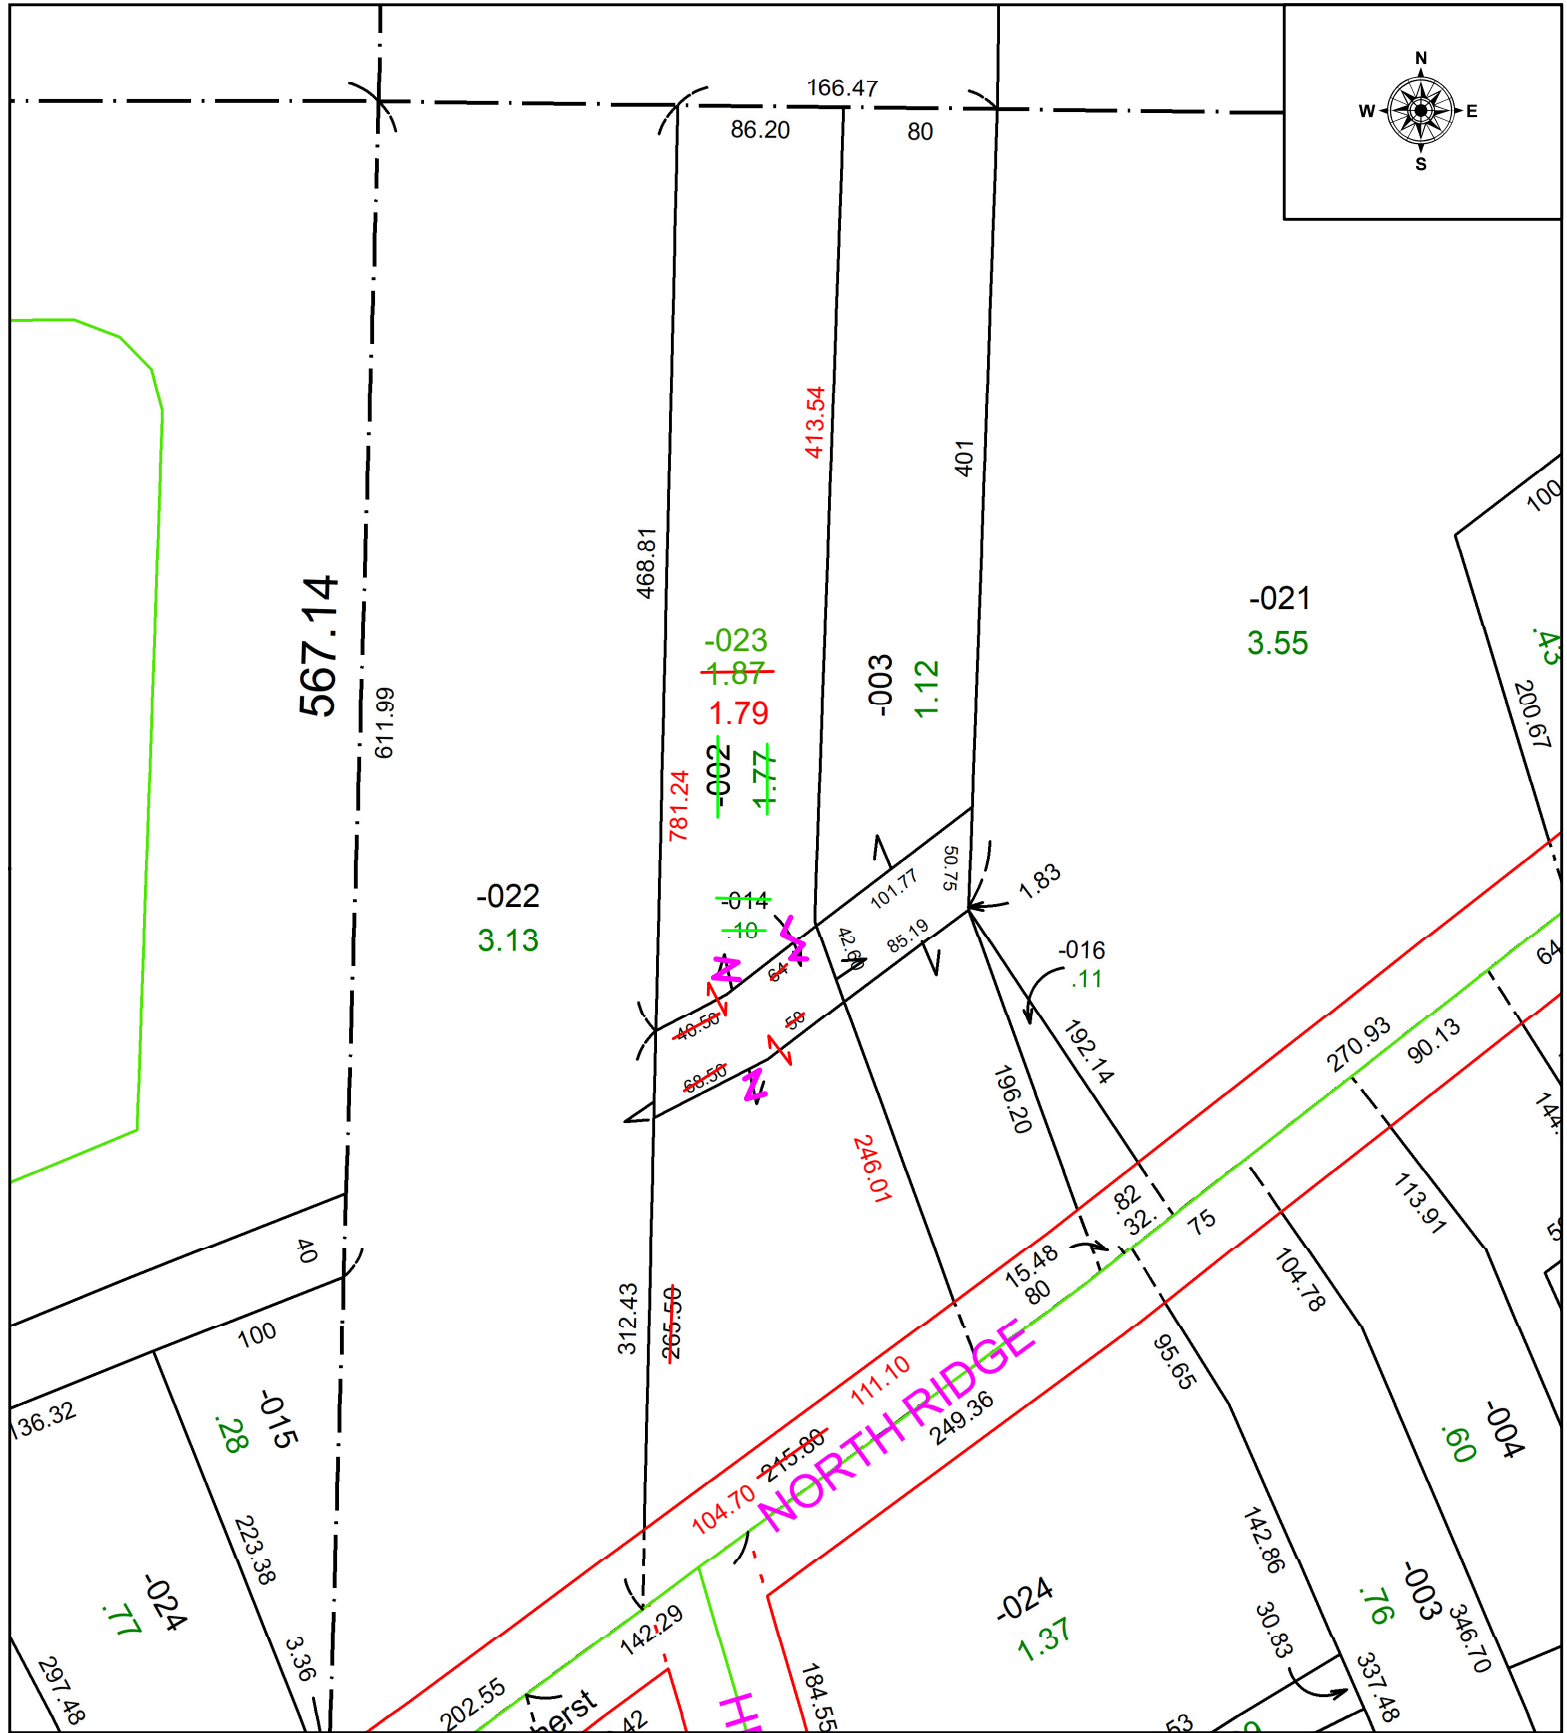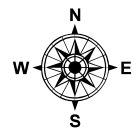

SPLITS/DEEDS PROCESSED
LORAIN COUNTY TAX MAP DEPARTMENT
226 MIDDLE AVE. ELYRIA, OH

SURVEYED BY: THOMAS SIMON SURVEY #51041
CLOSURE: 1: 643682
MAP PAGE(S): 05-00-059
APPROVED BY: WRZ DATE: 10/27/2023
SCALE: 1" = 100 PRIOR INSTRUMENT: #2016-0590549