
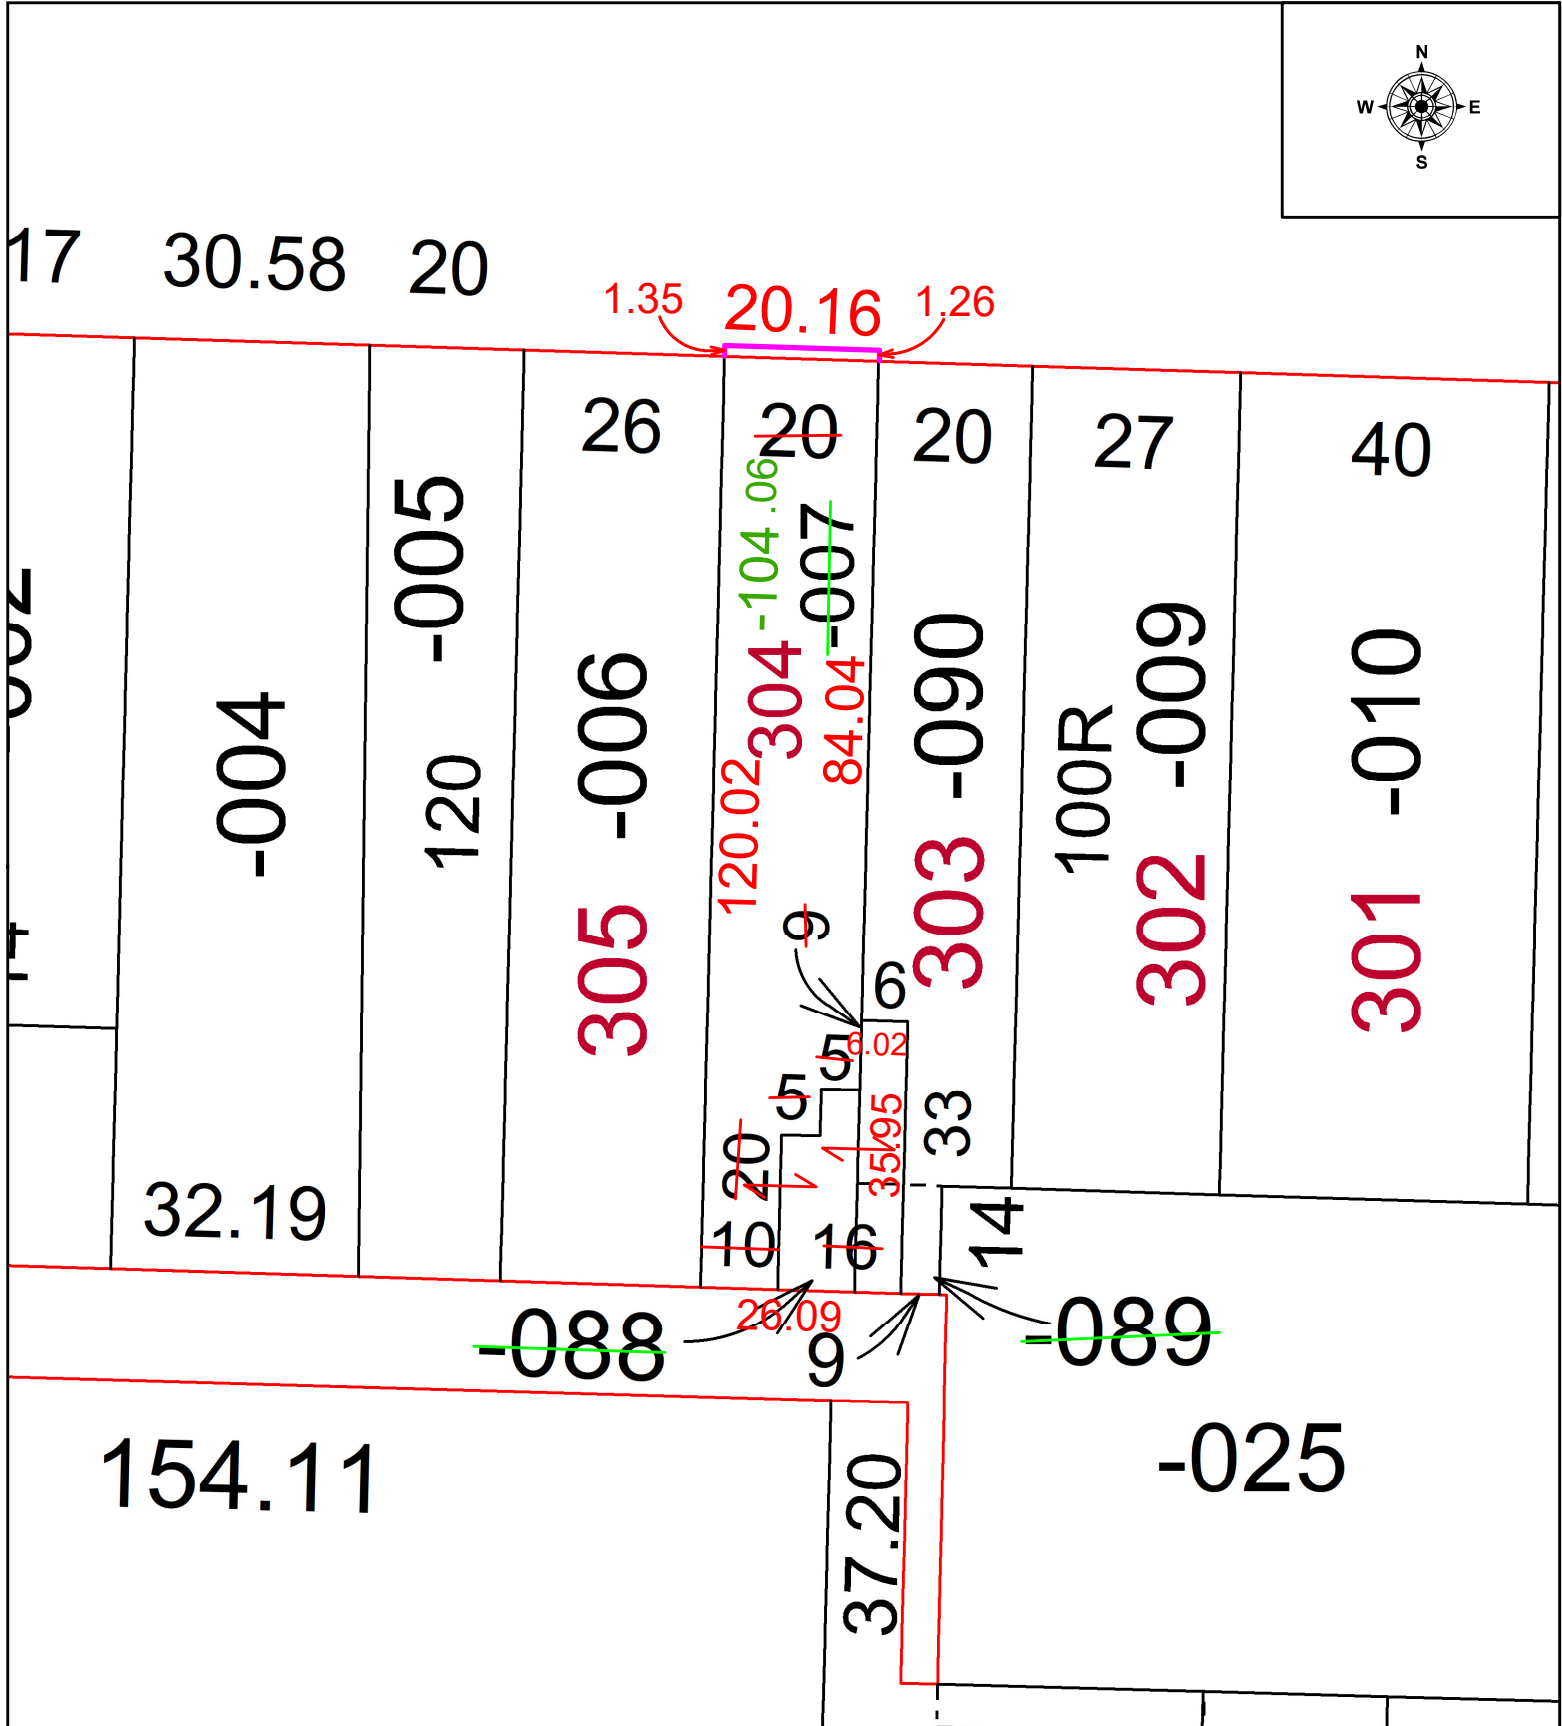


PARENT PARCEL: 09-00-085-112-007, -088, & -089

CHILD PARCEL: 09-00-085-112-104

STARTING POINT: INTERSECTION OF NORTH LINE OF OF AN EAST-WEST LANE & EAST LINE OF COLLEGE PLACE

22-04775-C

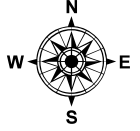

SPLITS/DEEDS PROCESSED
 LORAIN COUNTY TAX MAP DEPARTMENT
 226 MIDDLE AVE. ELYRIA, OH

SURVEYED BY: RICHARD A. FREDRICKSON
 CLOSURE: 1: 51442
 MAP PAGE(S): 09-00-085
 APPROVED BY: WRZ DATE: 1/21/2022
 SCALE: 1" = 25' PRIOR INSTRUMENT: 2019-0730096