


PARENT PARCEL: 09-00-074-104-023, -025, -026

CHILD PARCEL: 09-00-074-104-039, -040, -041

STARTING POINT: THE SOUTHWESTERLY CORNER OF ORIGINAL RUSSIA TOWNSHIP LOT NO. 74

23-04775

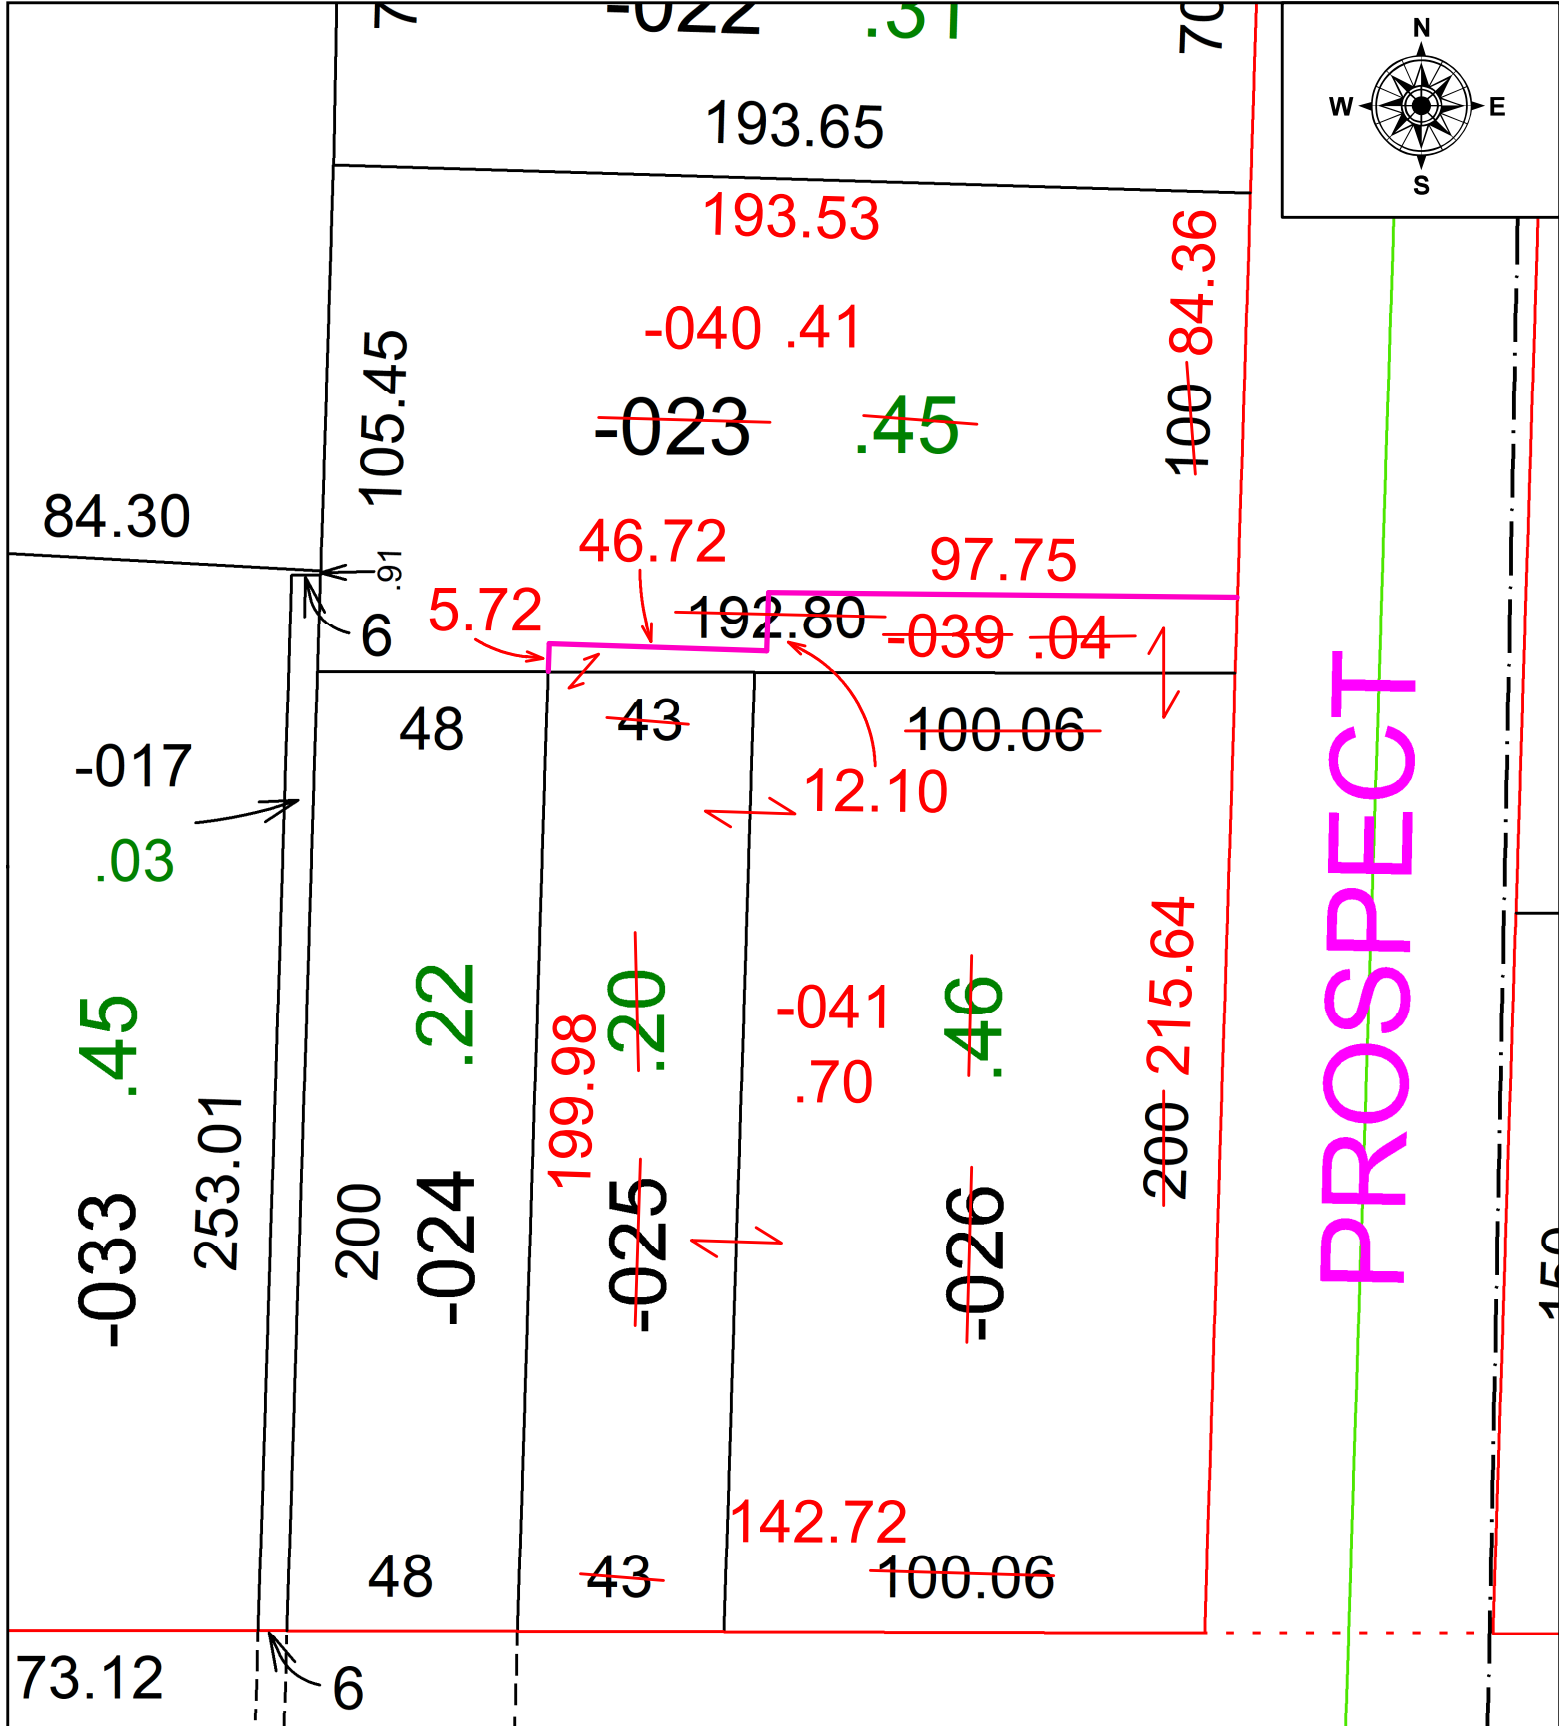

**SPLITS/DEEDS PROCESSED**  
 LORAIN COUNTY TAX MAP DEPARTMENT  
 226 MIDDLE AVE. ELYRIA, OH

SURVEYED BY: BRENT D. ANDERSON      SURVEY #: 51051  
 CLOSURE: 1: 77.670  
 MAP PAGE(S): 09-00-074  
 APPROVED BY: SP      DATE: 11/7/2023  
 SCALE: 1" = 40'      PRIOR INSTRUMENT: 1995-0353686