
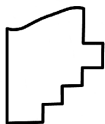


PARENT PARCEL: 03-00-048-109-024  
CHILD PARCEL: 03-00-047-106-024 & 03-00-048-109-026  
STARTING POINT: N/A

22-04777-U

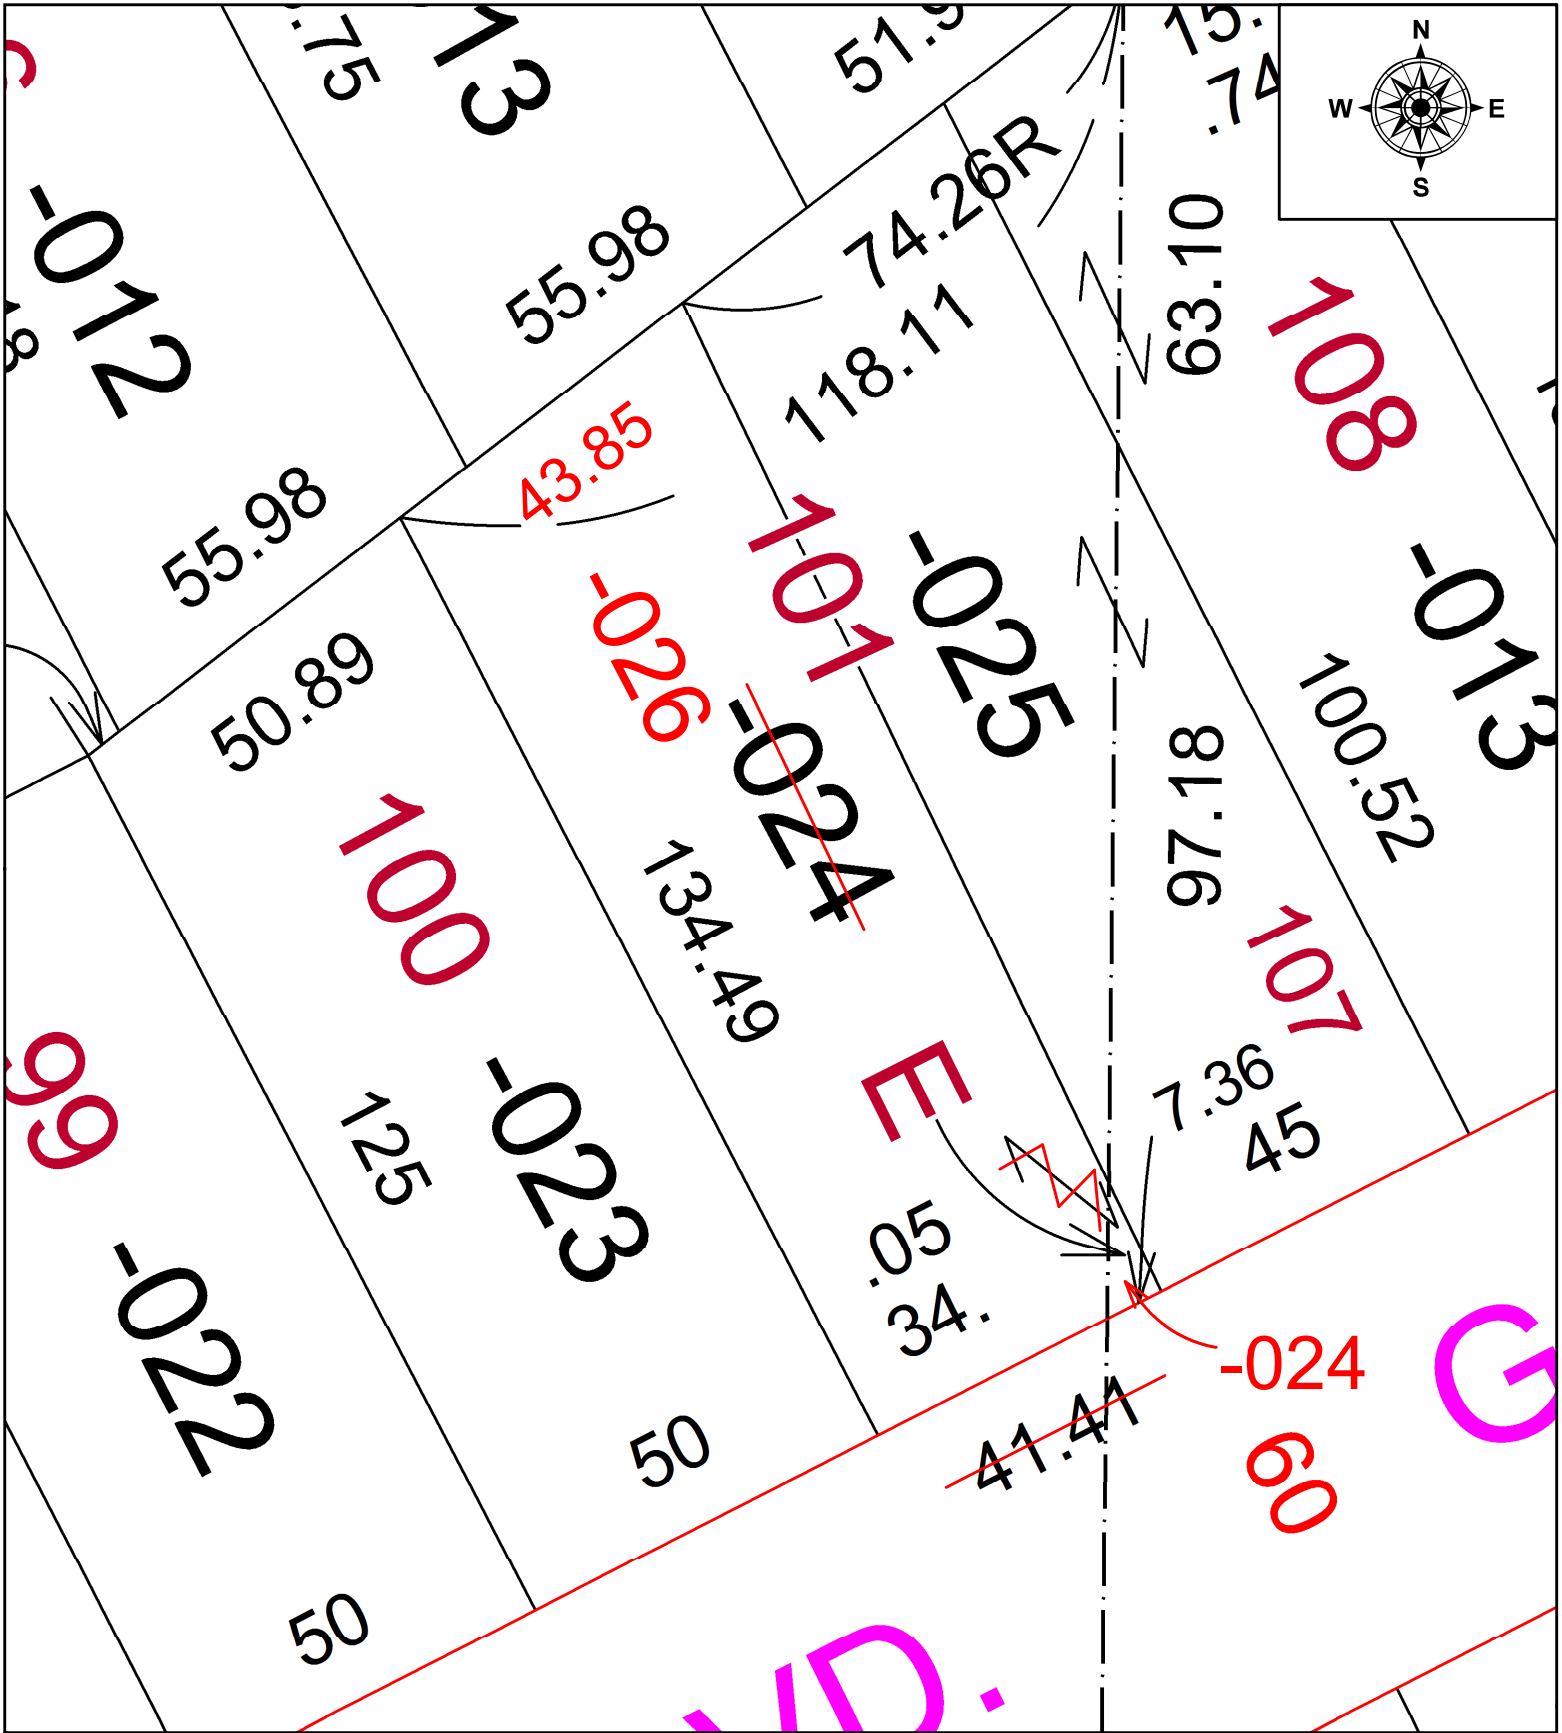

**SPLITS/DEEDS PROCESSED**  
LORAIN COUNTY TAX MAP DEPARTMENT  
226 MIDDLE AVE. ELYRIA, OH

SURVEYED BY: N/A  
CLOSURE: N/A  
MAP PAGE(S): 03-00-047 & -048  
APPROVED BY: DMA DATE: 1/26/2022  
SCALE: 1" = 25' PRIOR INSTRUMENT: 2021-0840977