


PARENT PARCEL: 12-00-070-000-004

CHILD PARCEL: 12-00-070-000-049, -050, -051, -052

AC CORR PER SURVEYOR LOUIS GIFFELS

23-04777

STARTING POINT: IRON PIPE @ NORTHEASTERLY CORNER OF S/L 12 OF ROLLING BROOK SUB.

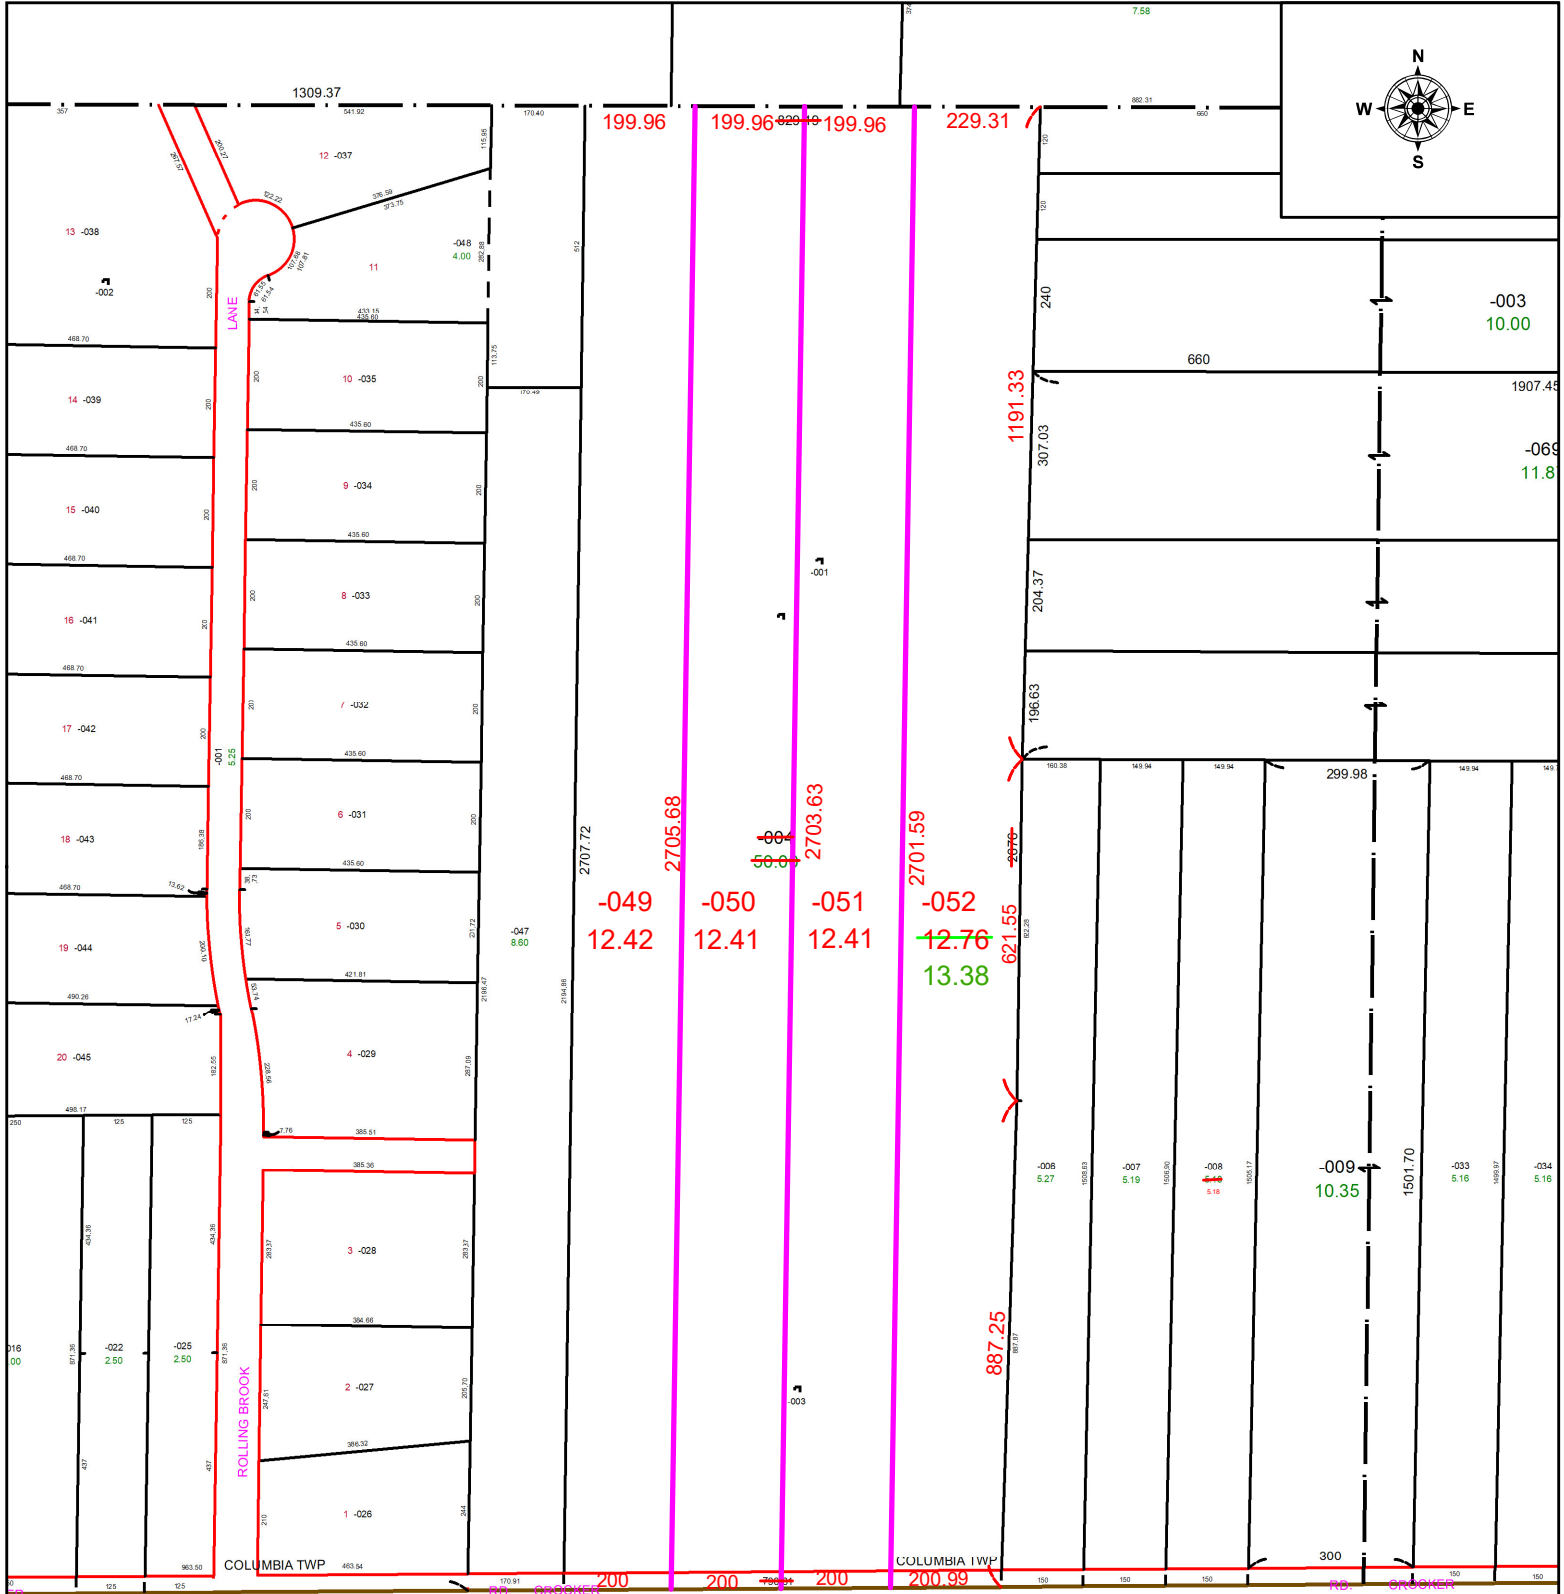


MEDINA CO

ROLLING BROOK

COLUMBIA TWP

MEDINA CO

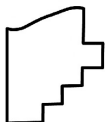

SPLITS/DEEDS PROCESSED
 LORAIN COUNTY TAX MAP DEPARTMENT
 226 MIDDLE AVE. ELYRIA, OH

SURVEYED BY: LOUIS GIFFELS SURVEY # 51053
 CLOSURE: 1: 1122632
 MAP PAGE(S): 12-00-070
 APPROVED BY: WRZ DATE: 11/8/2023
 SCALE: 1" = 350 PRIOR INSTRUMENT: #2009-0297641