
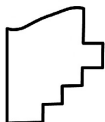
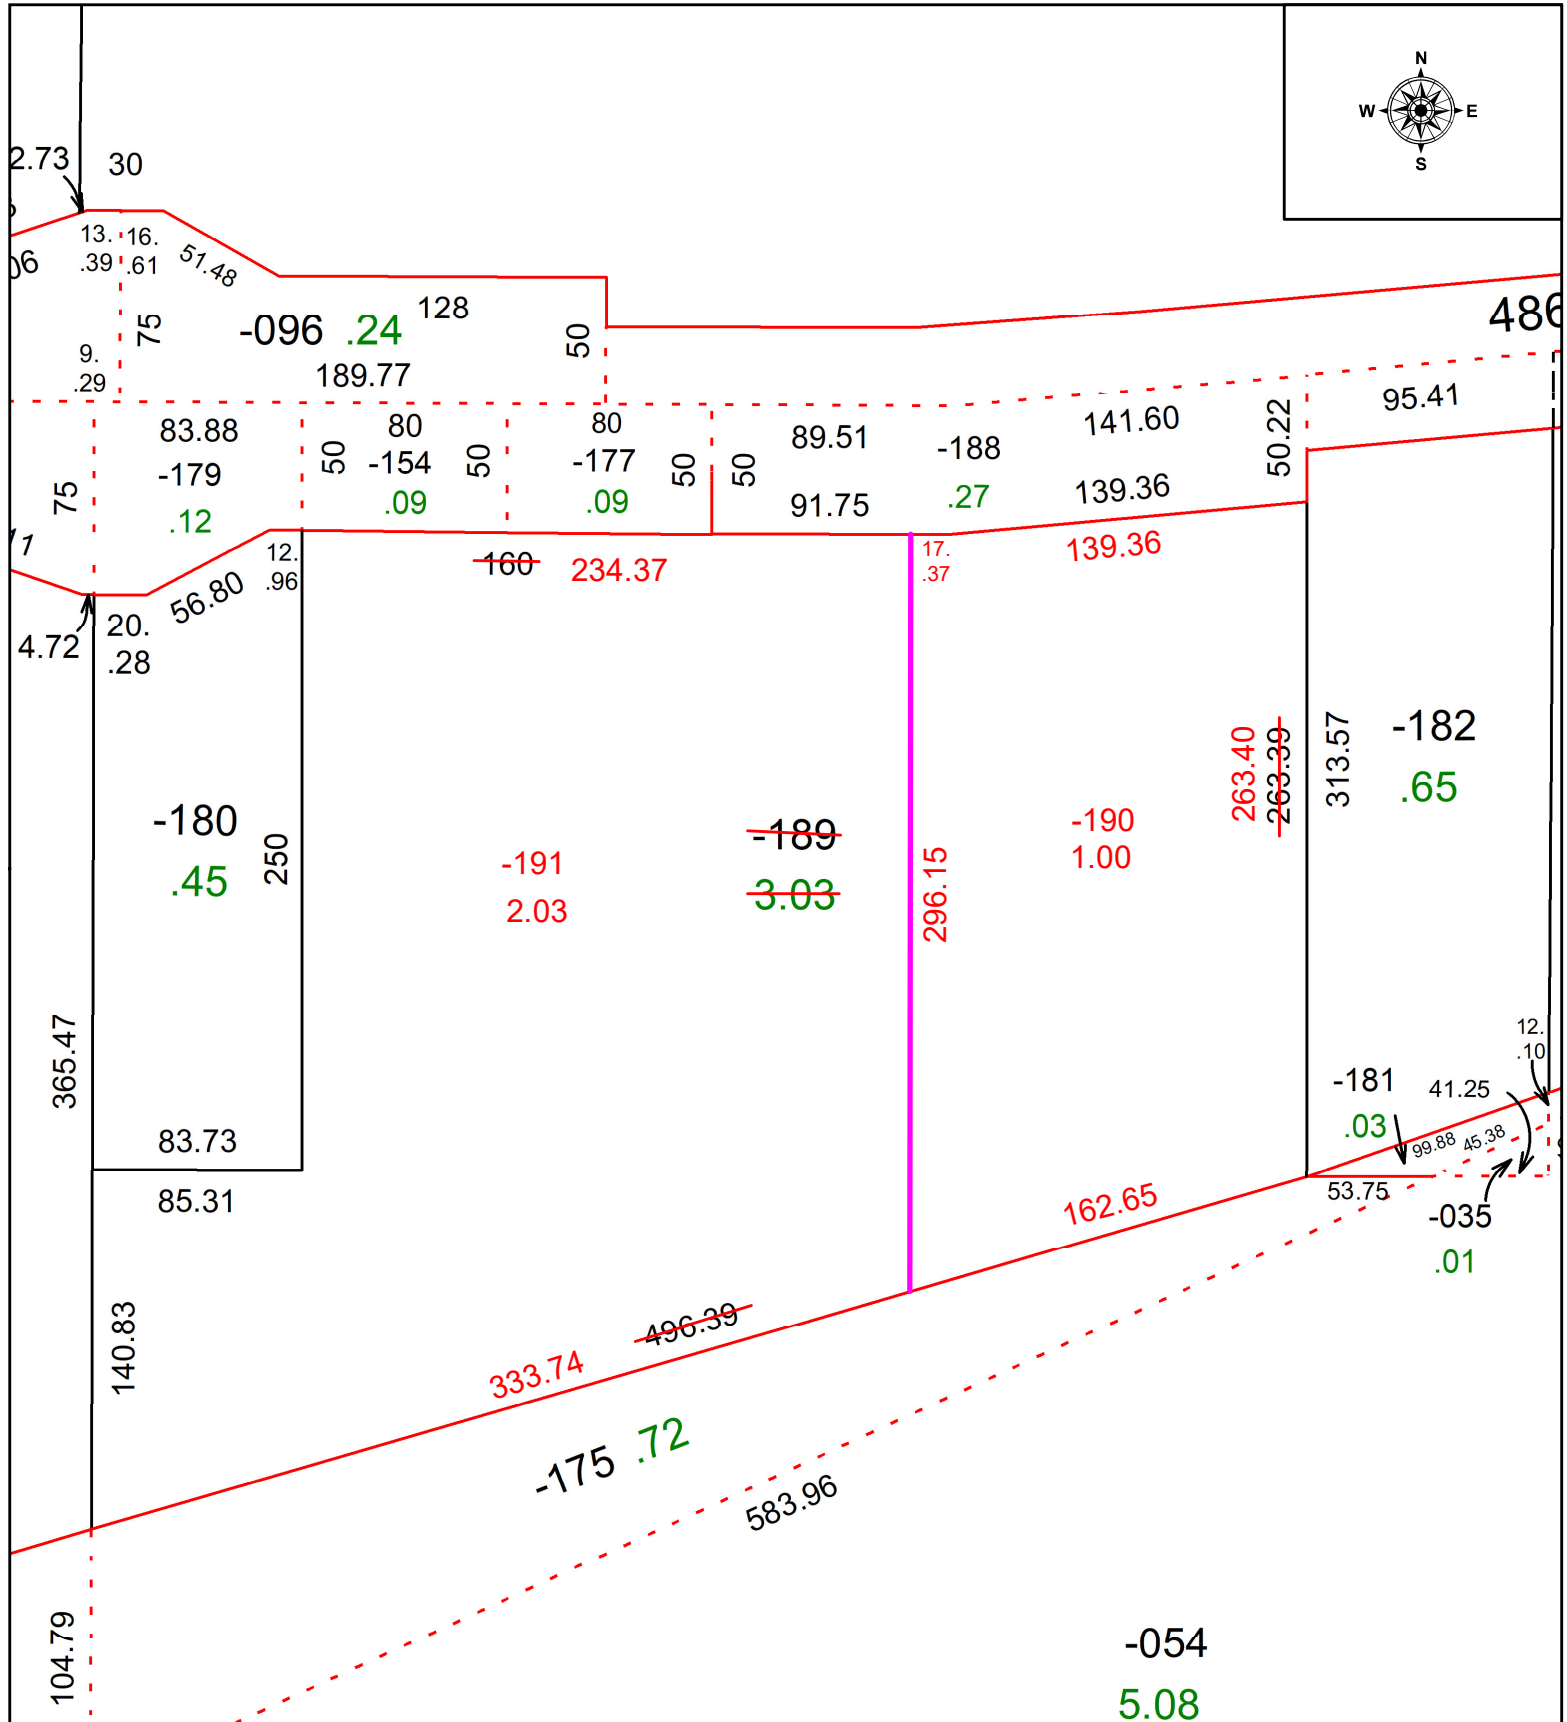


PARENT PARCEL: 04-00-028-102-189

CHILD PARCEL: 04-00-028-102-190 & -191

23-04780

STARTING POINT: INTERSECTION OF C/L'S OF JUST IMAGINE DR & NAGEL RD

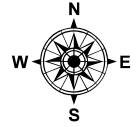

SPLITS/DEEDS PROCESSED
 LORAIN COUNTY TAX MAP DEPARTMENT
 226 MIDDLE AVE. ELYRIA, OH

SURVEYED BY: MICHAEL SPELLACY SURVEY # 51056
 CLOSURE: 1: 222113
 MAP PAGE(S): 04-00-028
 APPROVED BY: WRZ DATE: 11/14/2023
 SCALE: 1" = 75 PRIOR INSTRUMENT: #2022-093577