

PARENT PARCEL: 03-00-064-000-004, -018 THRU -021

CHILD PARCEL:




03-00-064-000-022

AC CORR PER SURVEYOR EDWARD NORTHROP

23-04784

STARTING POINT:

MAG NAIL @ INTERSECTION OF C/LS OF LAKE BREEZE RD & OLD COLORADO AVE

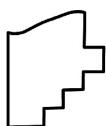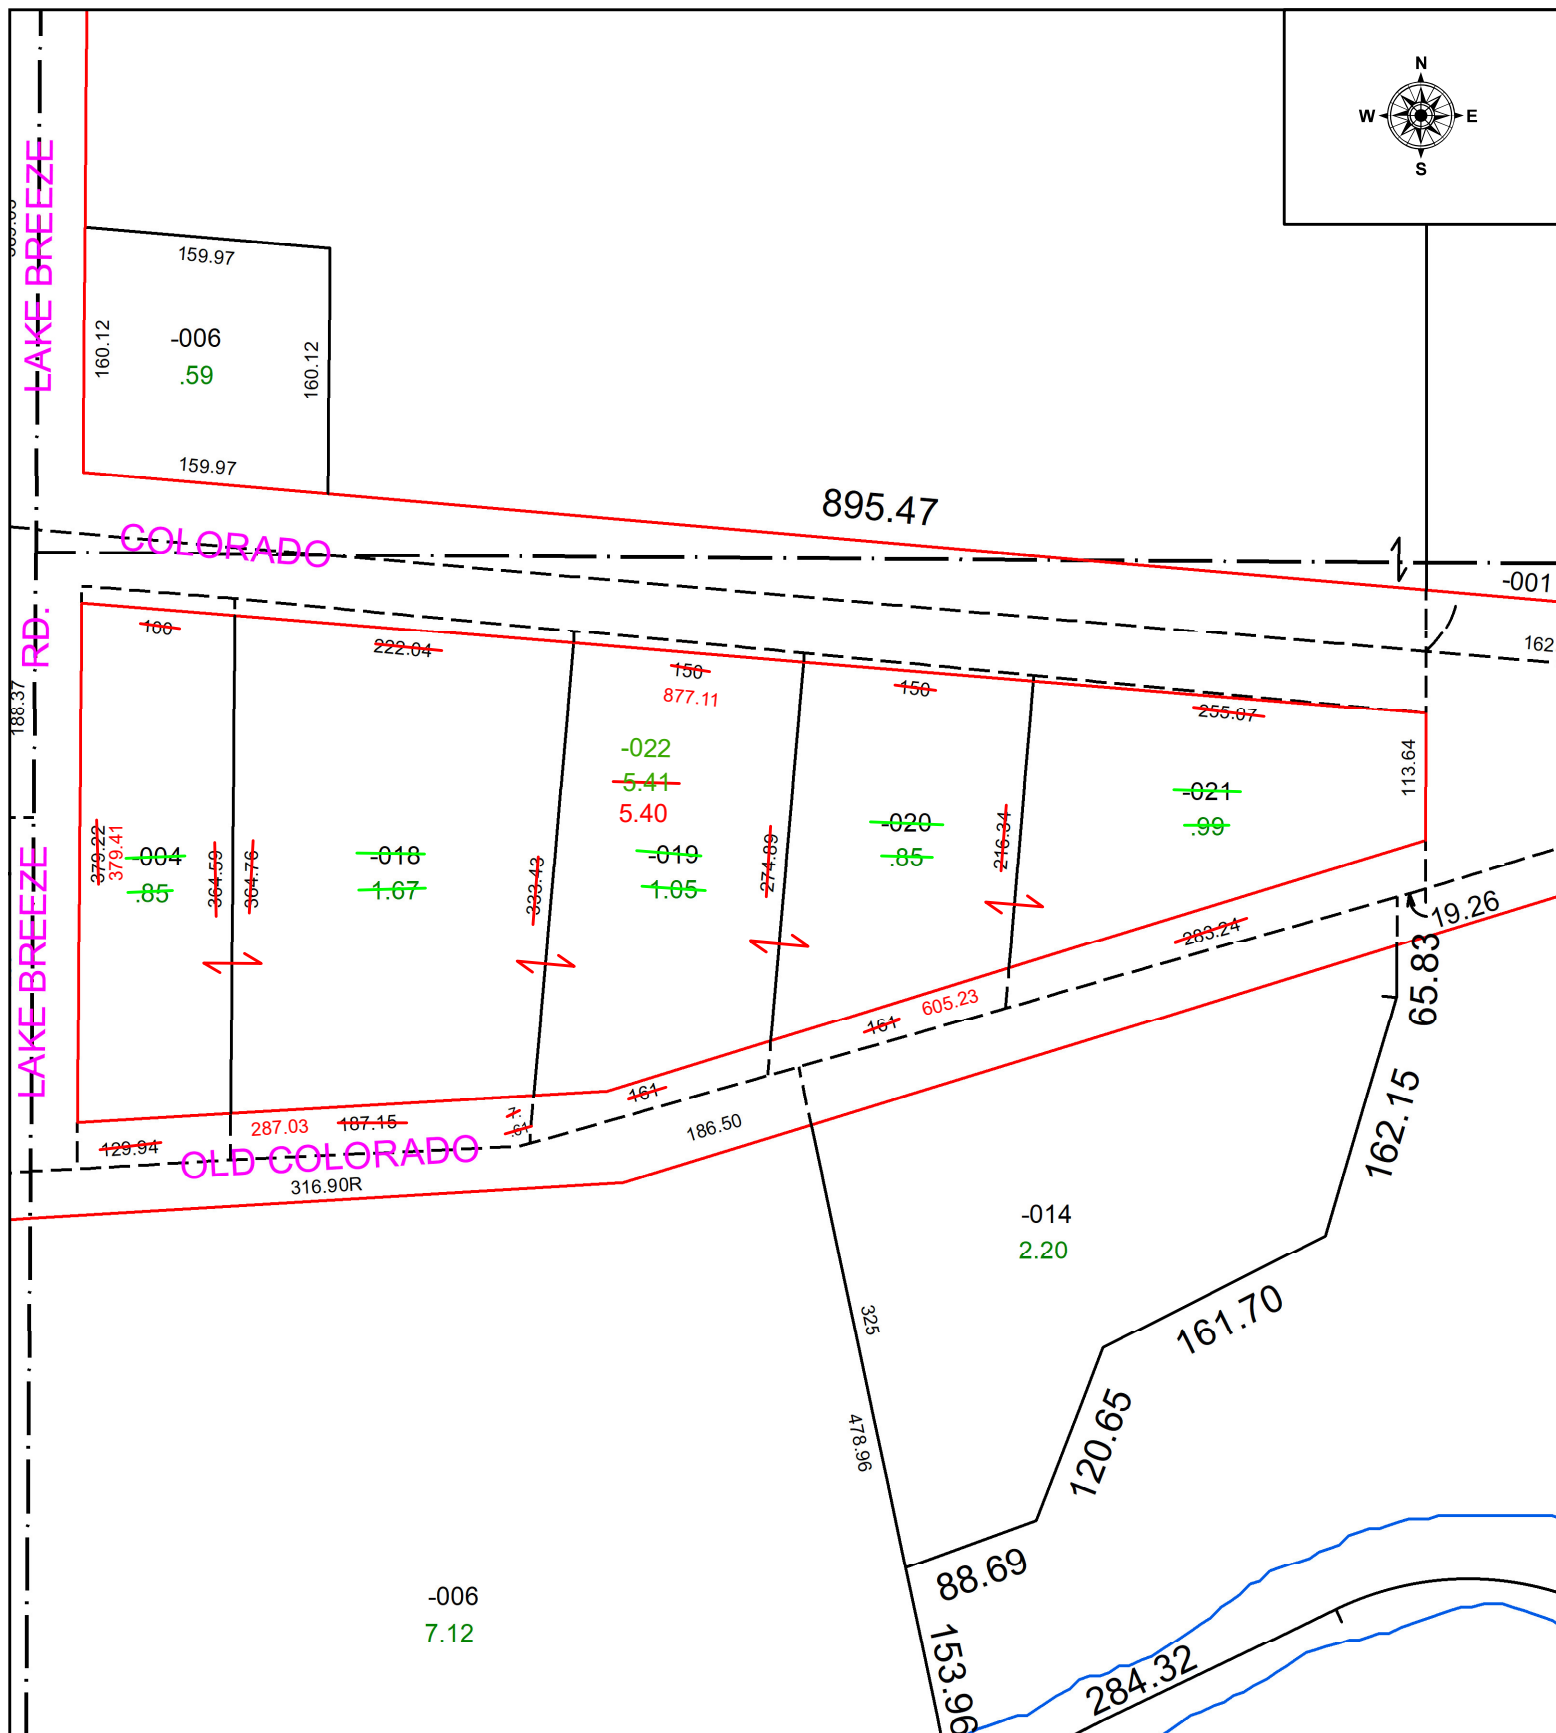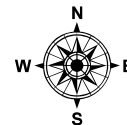

**SPLITS/DEEDS PROCESSED**  
LORAIN COUNTY TAX MAP DEPARTMENT  
226 MIDDLE AVE. ELYRIA, OH

SURVEYED BY: EDWARD NORTHROP SURVEY # 51064  
CLOSURE: 1: 709456  
MAP PAGE(S): 03-00-064  
APPROVED BY: WRZ DATE: 11/20/2023  
SCALE: 1" = 125 PRIOR INSTRUMENT: #2021-0797761