


PARENT PARCEL: 14-00-085-000-024 & -027

CHILD PARCEL: 14-00-085-000-058

STARTING POINT: C/L OF HALLAUER RD AND SR 303

23-04785

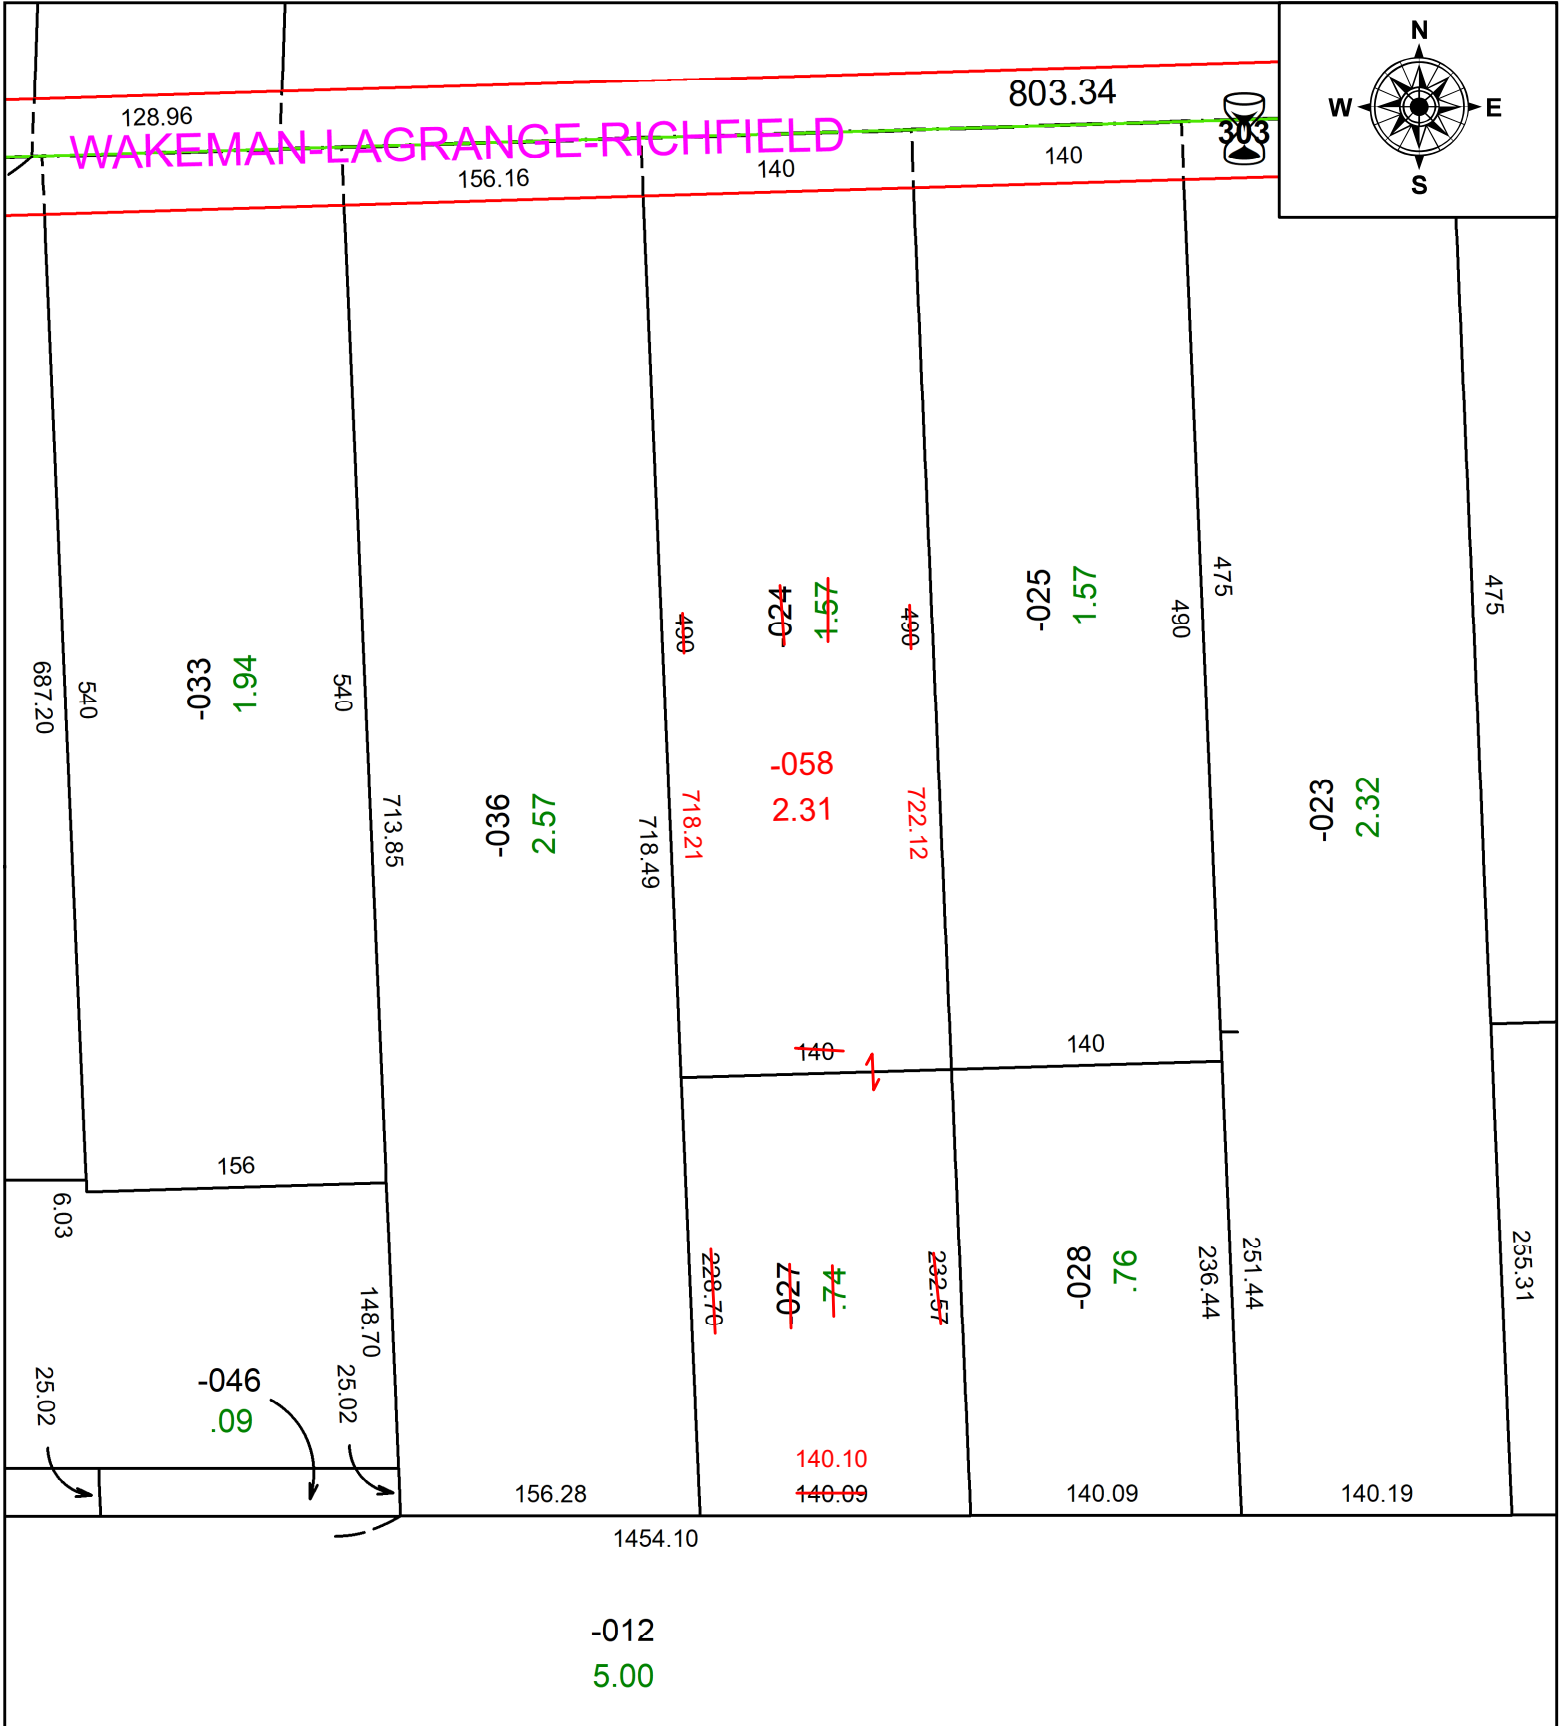

SPLITS/DEEDS PROCESSED
 LORAIN COUNTY TAX MAP DEPARTMENT
 226 MIDDLE AVE. ELYRIA, OH

SURVEYED BY: THOMAS A. SIMON **SURV # 51065**
CLOSURE: 1: 440131
MAP PAGE(S): 14-00-085
APPROVED BY: AC **DATE:** November 20, 2023
SCALE: 1 in = 100 ft **PRIOR INSTRUMENT:** 1993- 0260781