
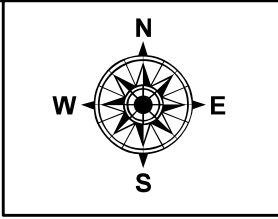


PARENT PARCEL: 07-00-018-101-088 & -261


CHILD PARCEL: **07-00-018-101-330**

STARTING POINT: NW CORNER OF S/L 34

23-04786

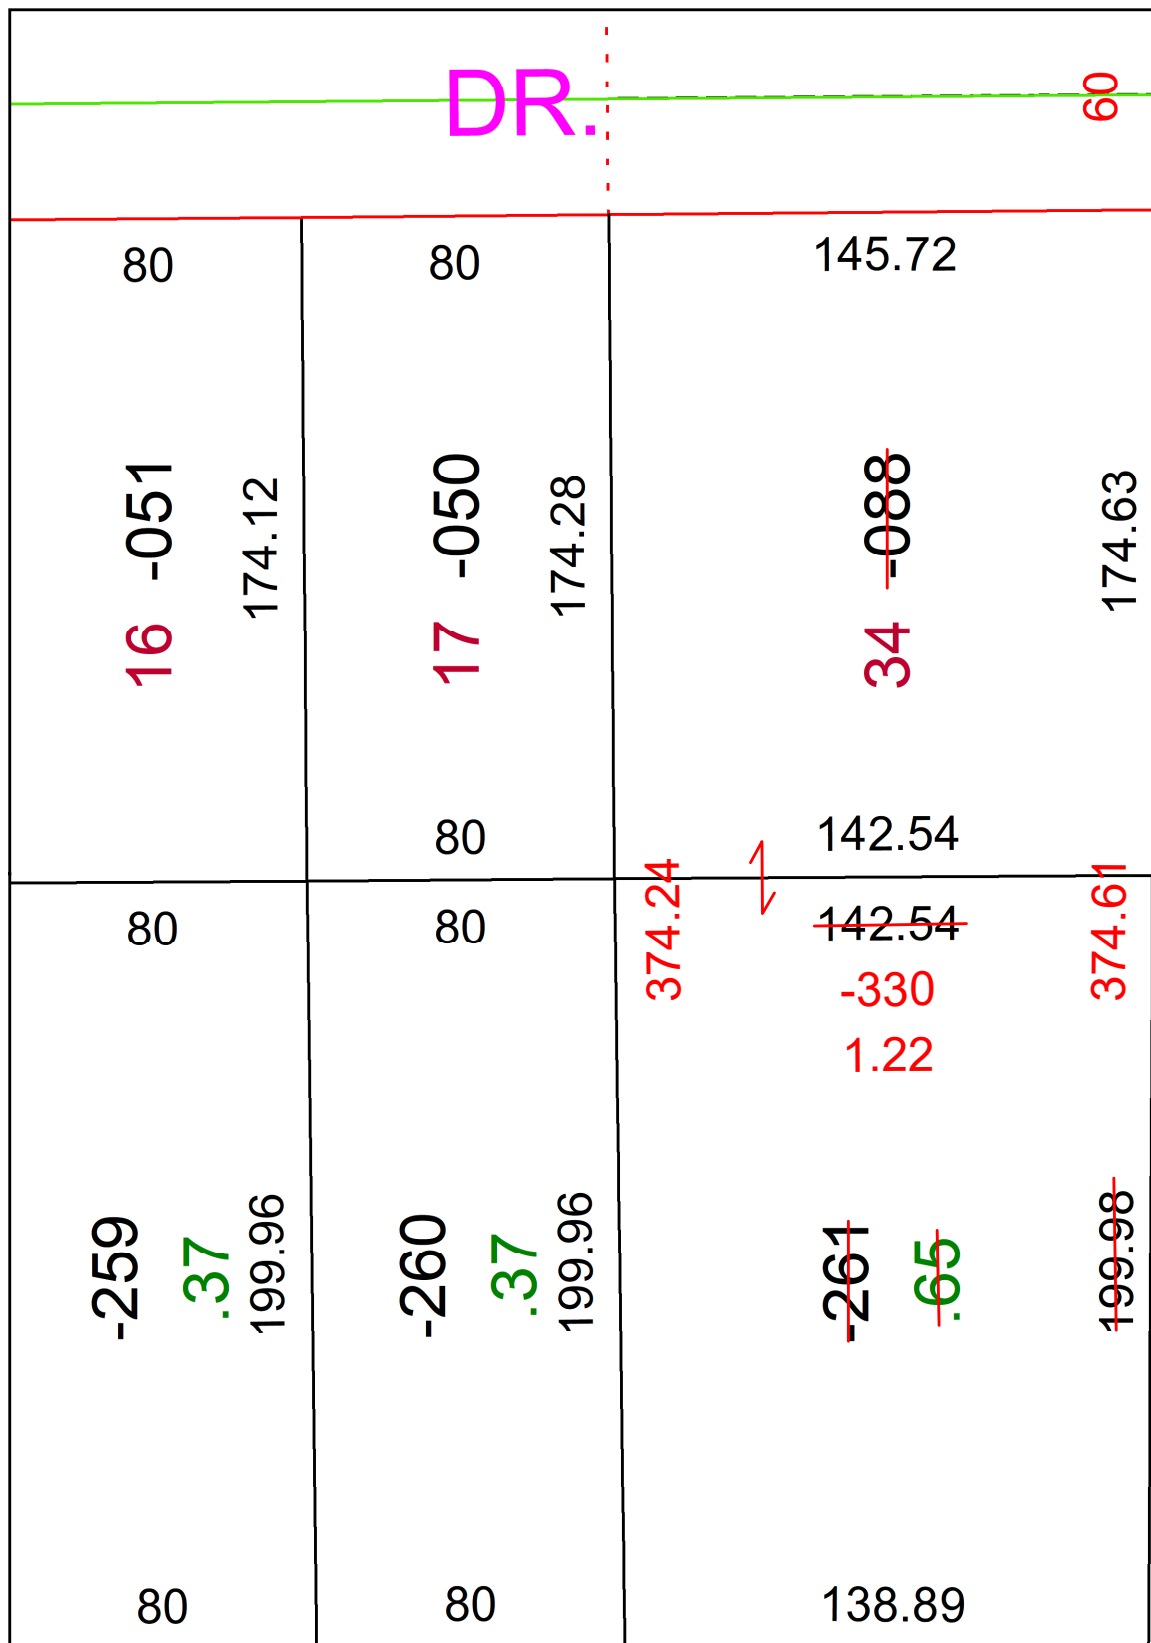

537

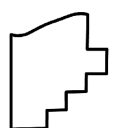

SPLITS/DEEDS PROCESSED
 LORAIN COUNTY TAX MAP DEPARTMENT
 226 MIDDLE AVE. ELYRIA, OH

SURVEYED BY: WILFREDO BARBOSA SURV # 51066
 CLOSURE: 1: 88747
 MAP PAGE(S): 07-00-018
 APPROVED BY: AC DATE: November 21, 2023
 SCALE: 1 in = 50 ft PRIOR INSTRUMENT: 2019- 0708537