


PARENT PARCEL: 05-00-016-101-182

CHILD PARCEL: 05-00-016-101-196 & -197

STARTING POINT: SW CORNER OF S/L 32 **AC CORR PER SURV BY JOSHUA S. RIEDY**

23-04788

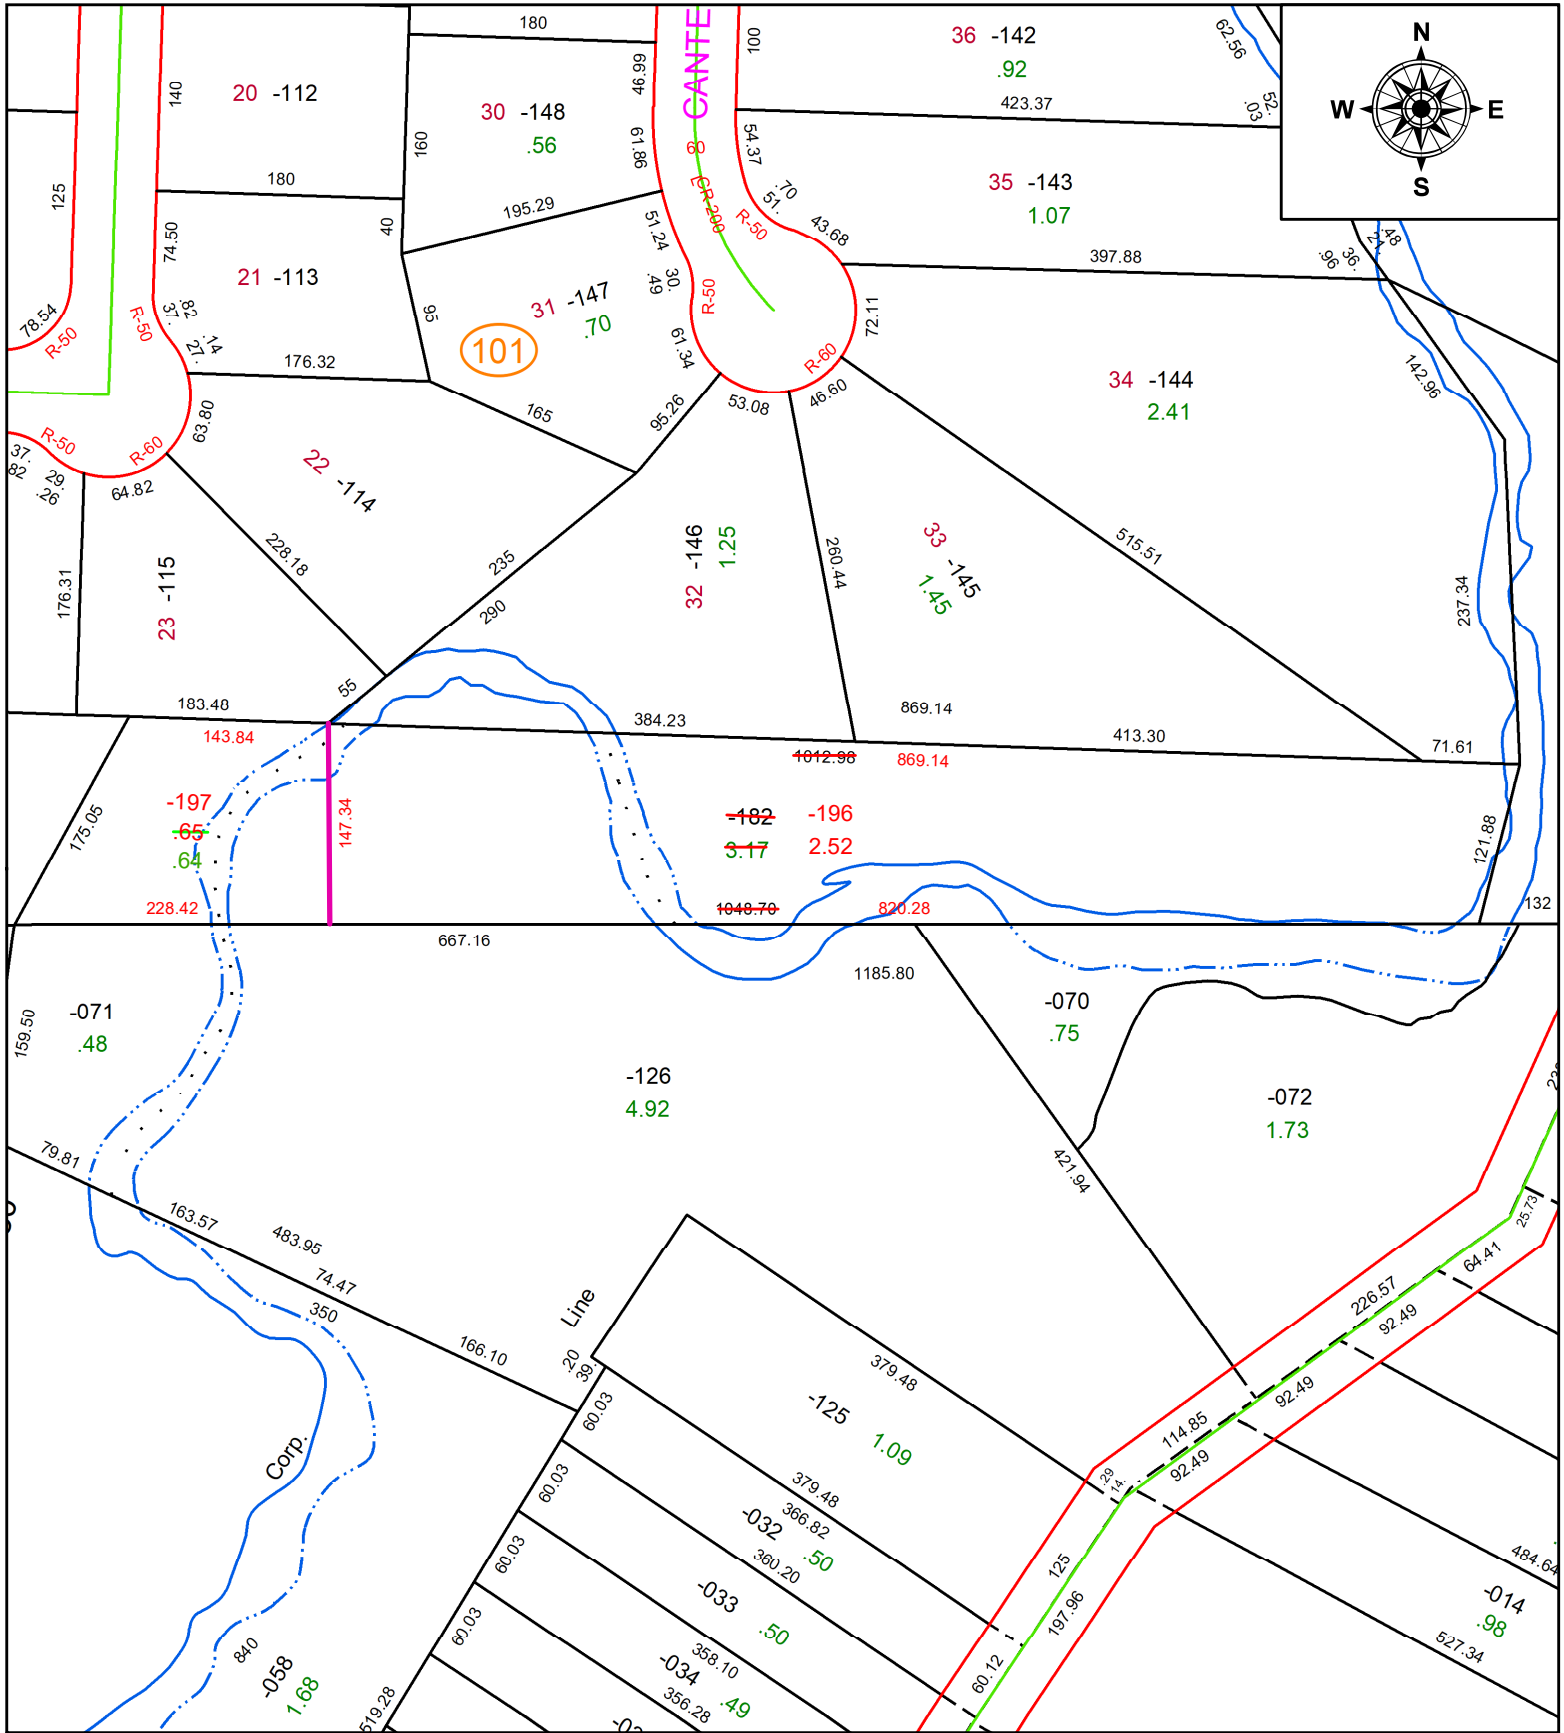

**SPLITS/DEEDS PROCESSED**  
 LORAIN COUNTY TAX MAP DEPARTMENT  
 226 MIDDLE AVE. ELYRIA, OH

**SURVEYED BY:** JOSHUA S. RIEDY **SURV # 51069**  
**CLOSURE:** 1: 310227  
**MAP PAGE(S):** 05-00-016  
**APPROVED BY:** AC **DATE:** November 27, 2023  
**SCALE:** 1 in = 140 ft **PRIOR INSTRUMENT:** 2022- 0872239