
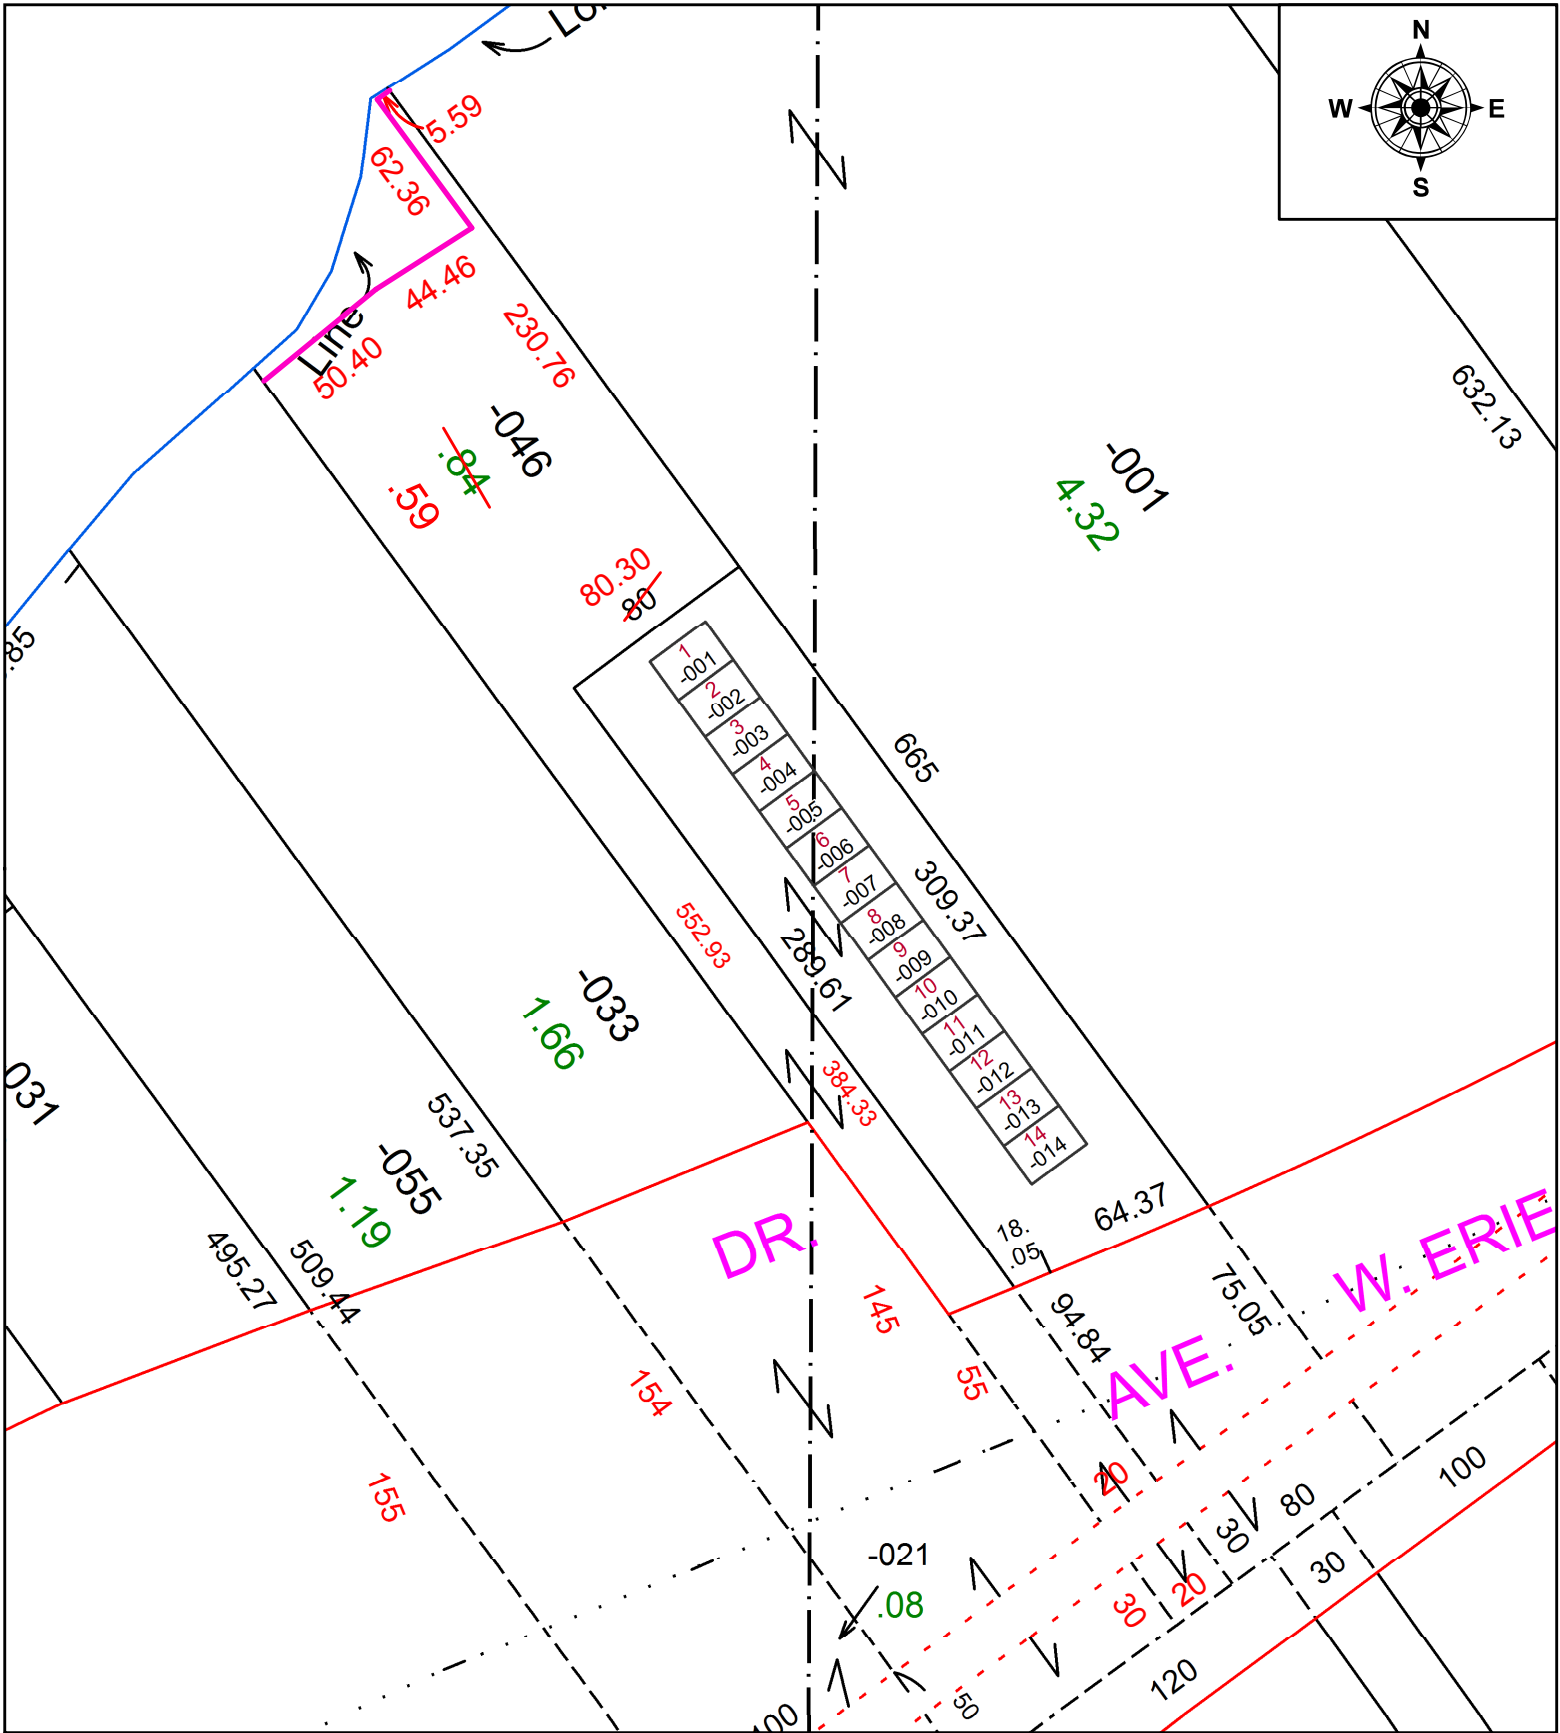


PARENT PARCEL: 02-02-021-101-046


CHILD PARCEL: **AC. CORR. PER SURVEY AMY KELLY**

STARTING POINT: CL OF PUEBLO DR. & LINE BETWEEN O.L 20 & 21

22-04794-A

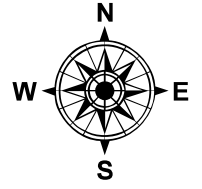

1	-001
2	-002
3	-003
4	-004
5	-005
6	-006
7	-007
8	-008
9	-009
10	-010
11	-011
12	-012
13	-013
14	-014

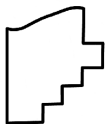

SPLITS/DEEDS PROCESSED
LORAIN COUNTY TAX MAP DEPARTMENT
226 MIDDLE AVE. ELYRIA, OH

SURVEYED BY: AMY KELLY

CLOSURE: 1: 2147483648

MAP PAGE(S): 02-02-021

APPROVED BY: DMA DATE: 2/23/2022

SCALE: 1" = 75' PRIOR INSTRUMENT: 2018-0667091