


PARENT PARCEL: 03-00-061-106-024 & -048

CHILD PARCEL: 03-00-061-106-053 THRU -055

STARTING POINT: **AC CORR PER SURV BY AMY M. KELLY**

23-04794

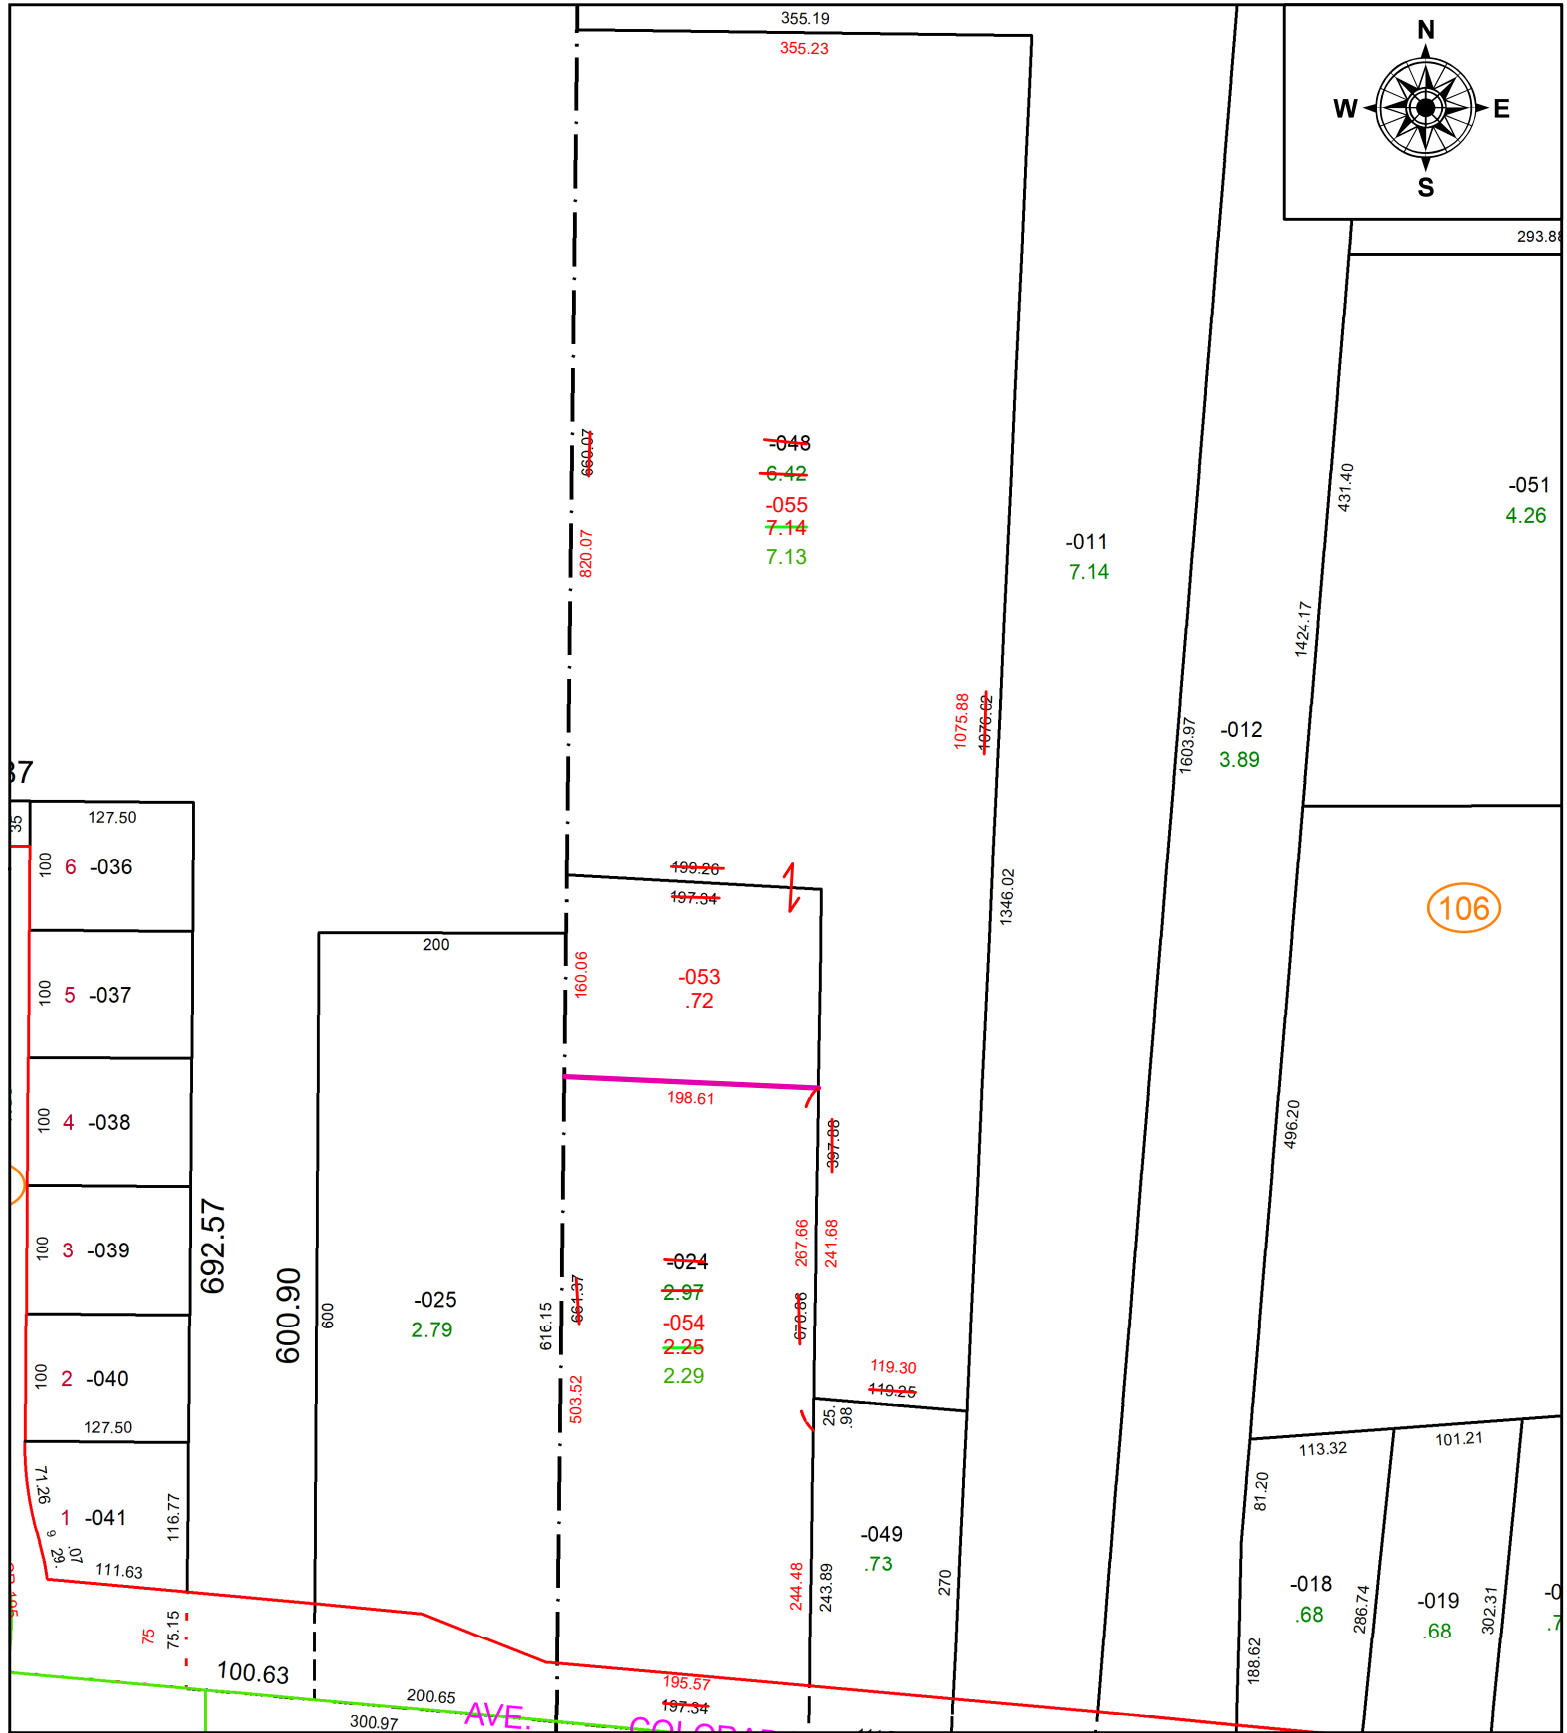

**SPLITS/DEEDS PROCESSED**  
 LORAIN COUNTY TAX MAP DEPARTMENT  
 226 MIDDLE AVE. ELYRIA, OH

**SURVEYED BY:** AMY M KELLY **SURV # 51077**  
**CLOSURE:** 1: 347309  
**MAP PAGE(S):** 03-00-061  
**APPROVED BY:** AC **DATE:** December 07, 2023  
**SCALE:** 1 in = 150 ft **PRIOR INSTRUMENT:** 2023- 0907105