
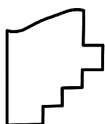


PARENT PARCEL: 06-24-044-101-057

CHILD PARCEL: **AC CORR PER PRIOR DEED**

STARTING POINT: C/L OF MURRAY RIDGE RD RD AND S LINE OF O/L 45

22-04796-A

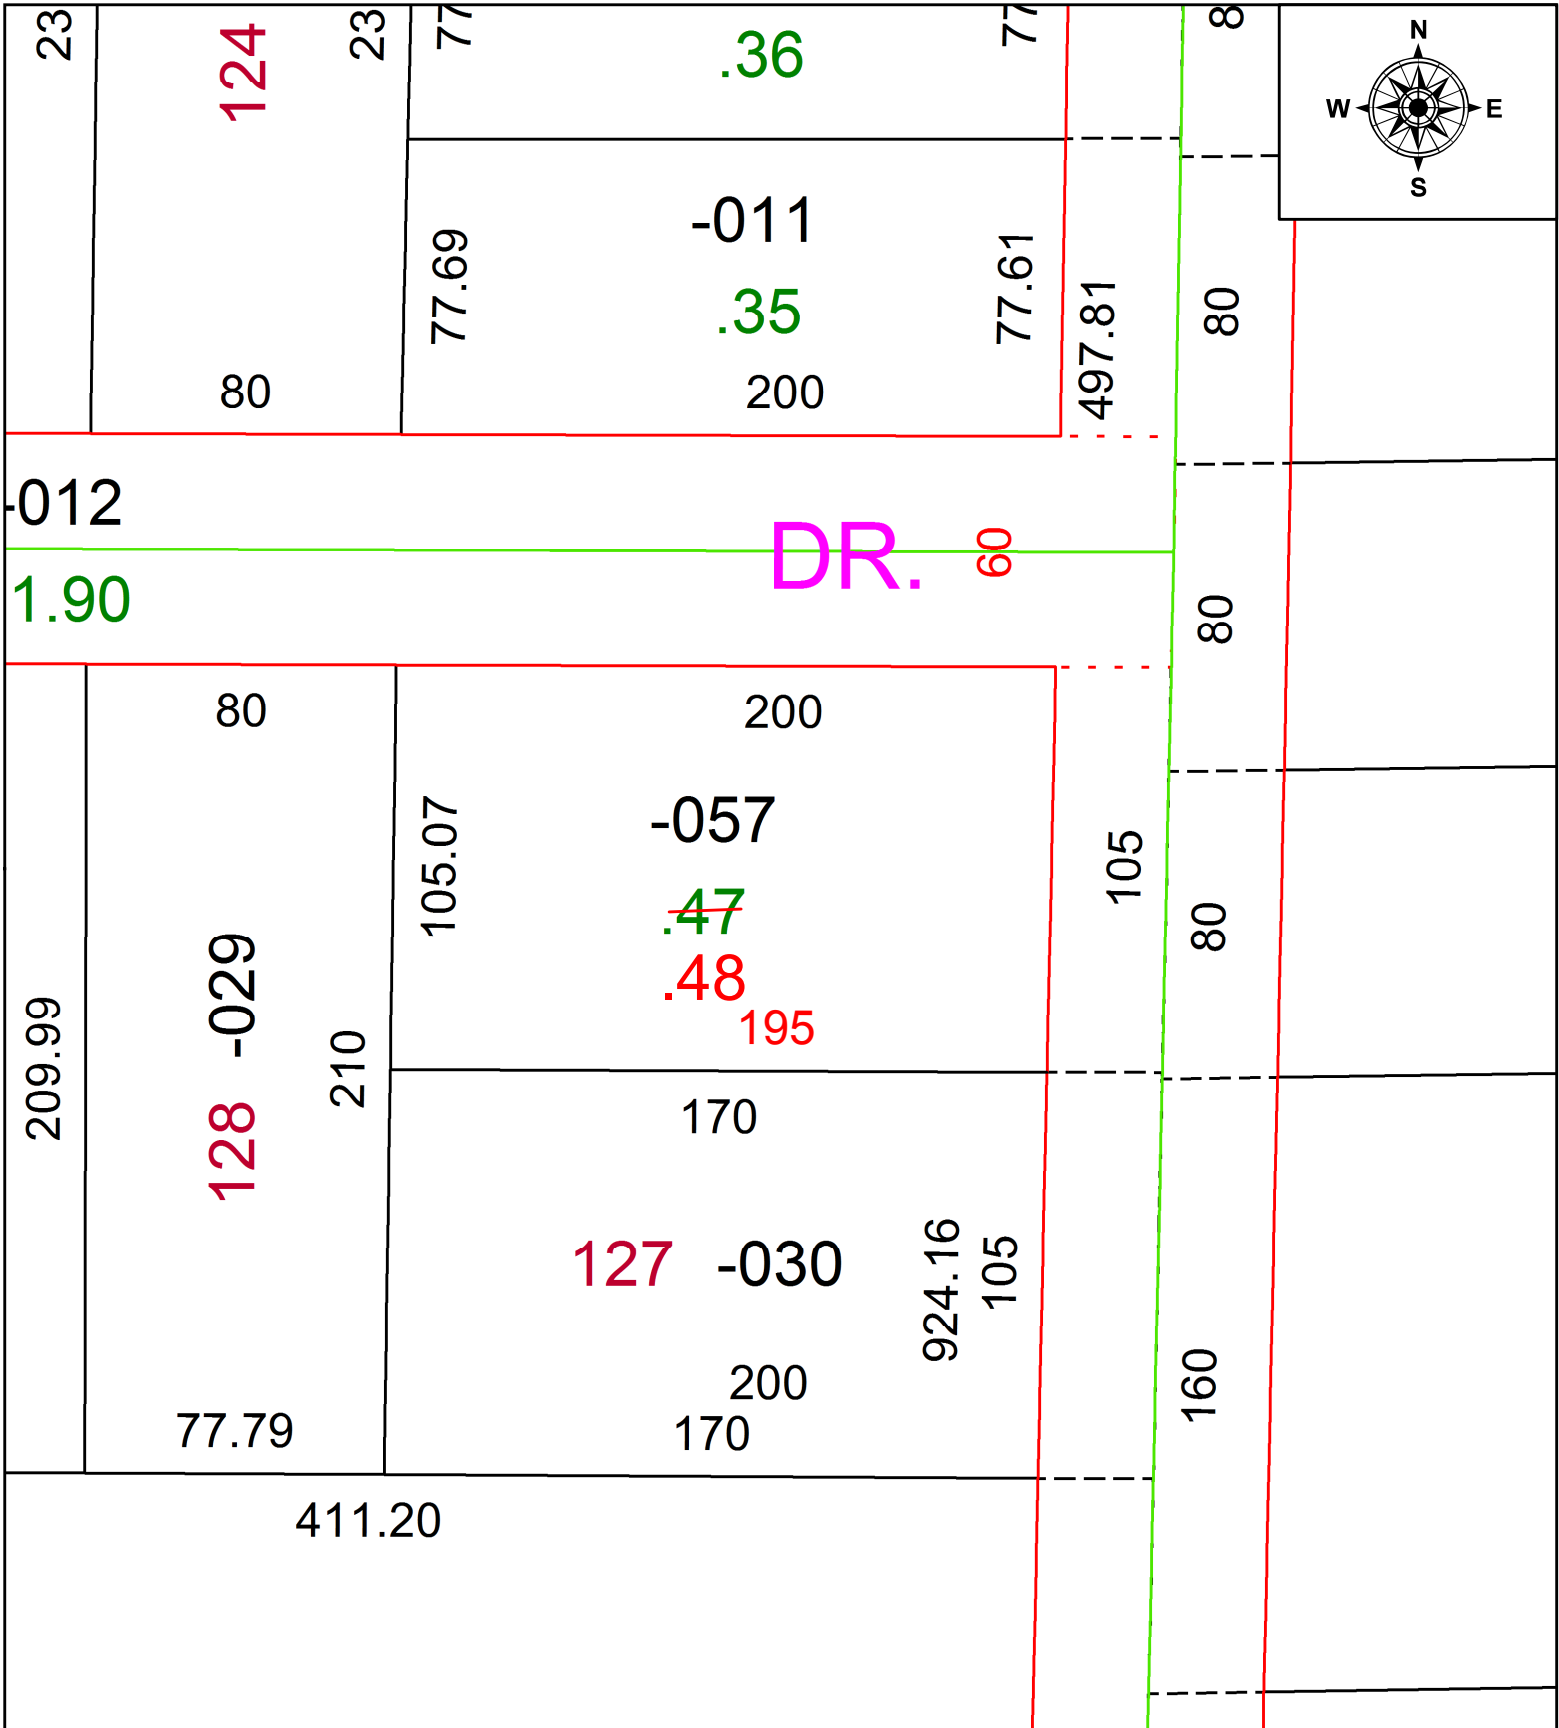

SPLITS/DEEDS PROCESSED
LORAIN COUNTY TAX MAP DEPARTMENT
226 MIDDLE AVE. ELYRIA, OH

SURVEYED BY:	N/A
CLOSURE:	1: 100789
MAP PAGE(S):	06-39
APPROVED BY:	AC DATE: 2/25/2022
SCALE:	1" = 50 PRIOR INSTRUMENT: 2016- 0574738