
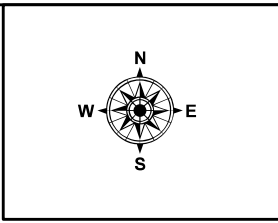


PARENT PARCEL: 10-00-013-000-128 & -231

CHILD PARCEL: 10-00-013-000-262, -263, & -264

STARTING POINT: MONUMENT BOX @ INTERSECTION OF C/LS OF LAGRANGE RD & DIAGONAL RD

23-04797

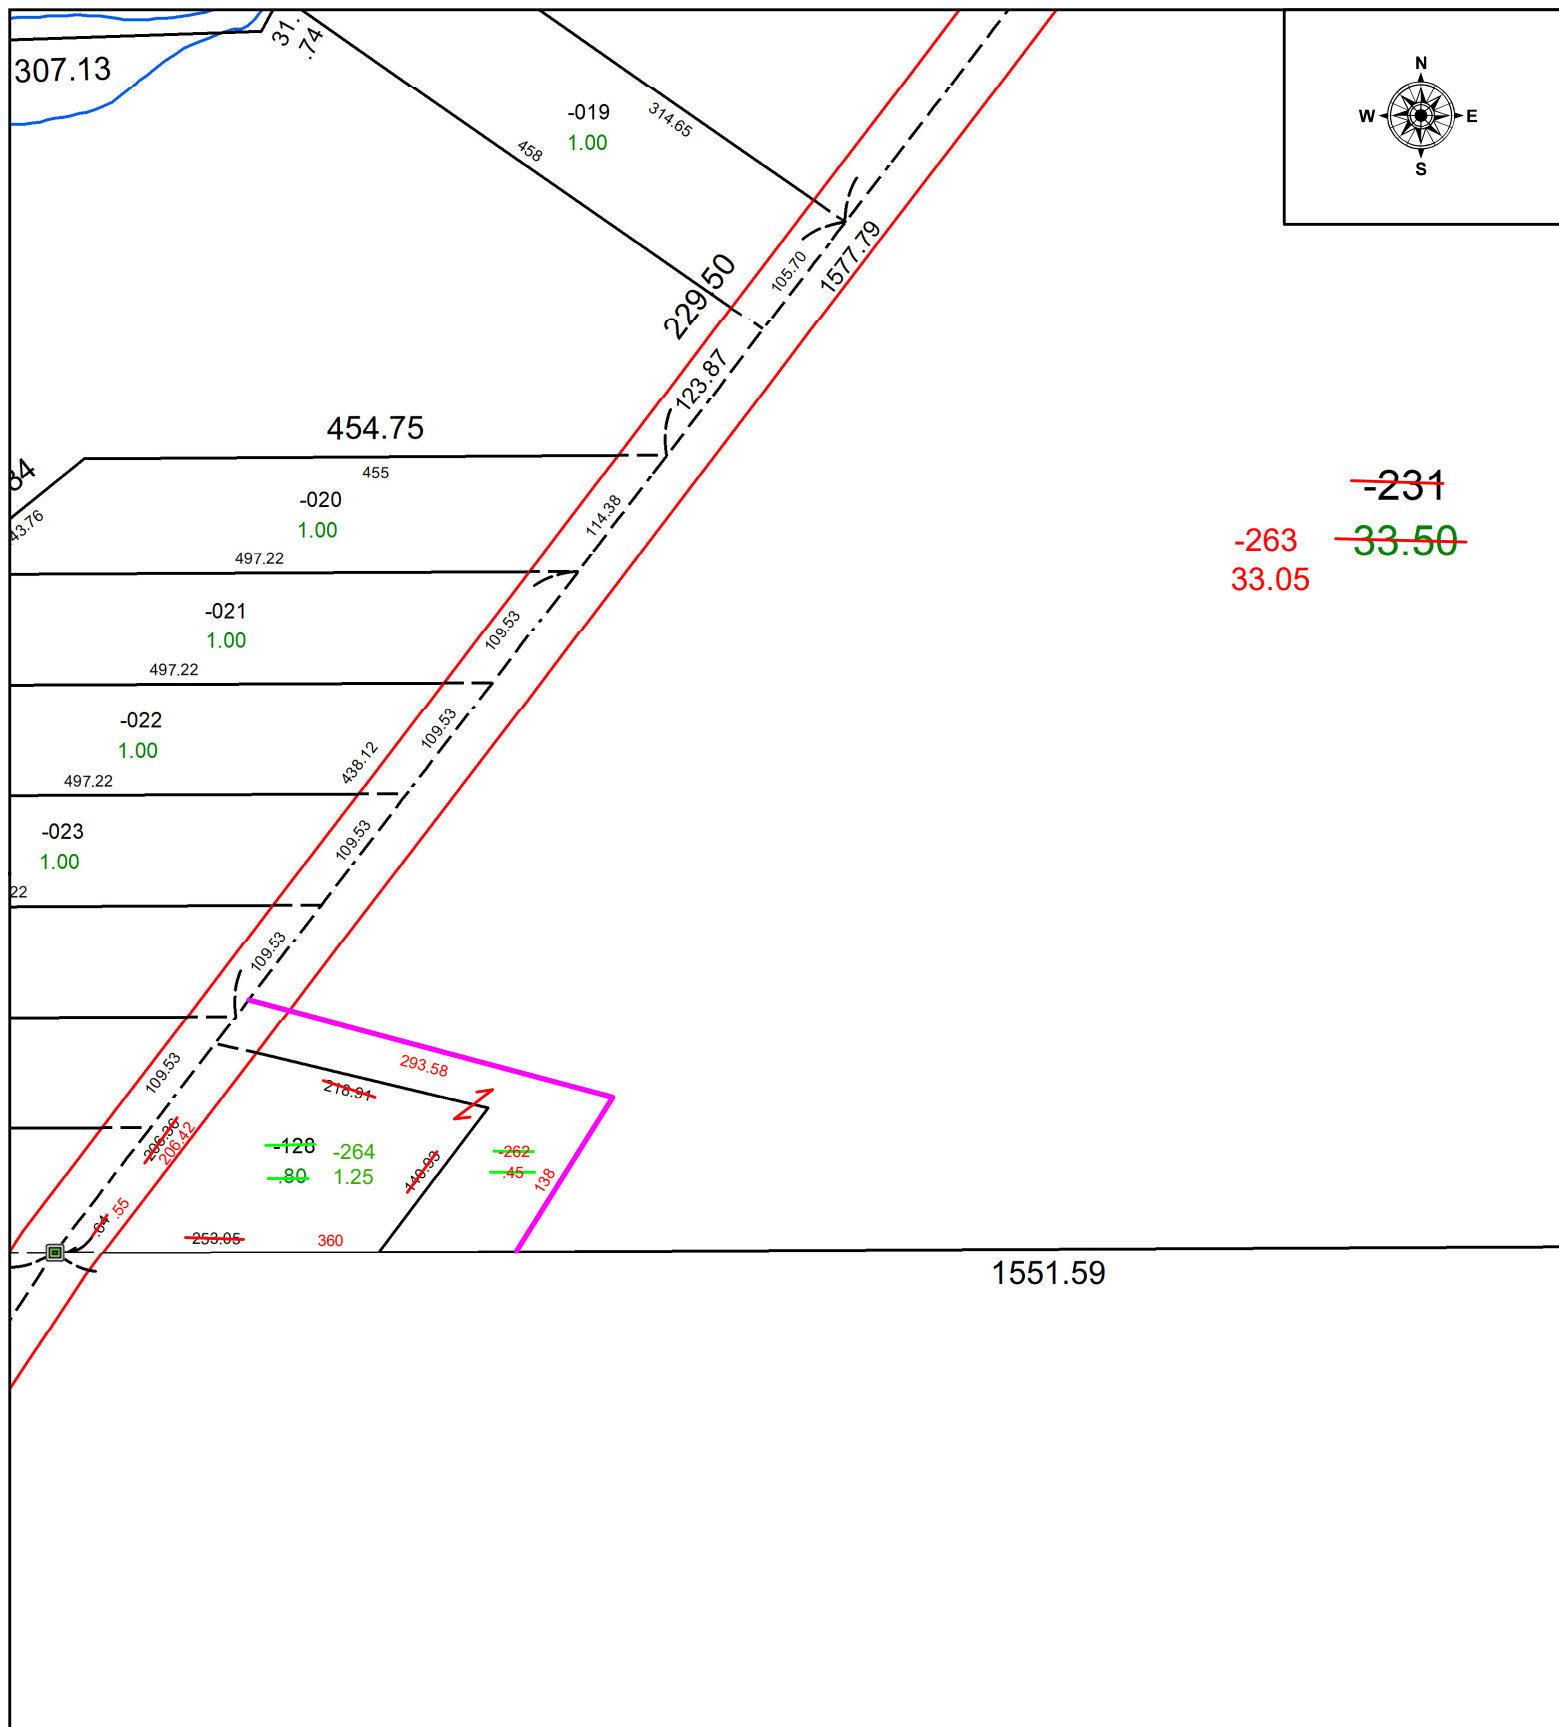

~~-231~~
 -263 33.05
 33.05

SPLITS/DEEDS PROCESSED
 LORAIN COUNTY TAX MAP DEPARTMENT
 226 MIDDLE AVE. ELYRIA, OH

SURVEYED BY: JOHN DECHANT JR. SURVEY # 51088
 CLOSURE: 1: 1125673
 MAP PAGE(S): 10-00-013
 APPROVED BY: WRZ DATE: 12/13/2023
 SCALE: 1" = 150 PRIOR INSTRUMENT: #2006-0141203