


PARENT PARCEL: 03-00-046-101-010

CHILD PARCEL: **AC. CORR. PER PRIOR INSTRUMENT # 2007-0197650**

STARTING POINT: CL OF E. ERIE AVE. & S.E. CORNER LAND TO GEORGE DAY VOL. 80 PG. 225

22-04801-A

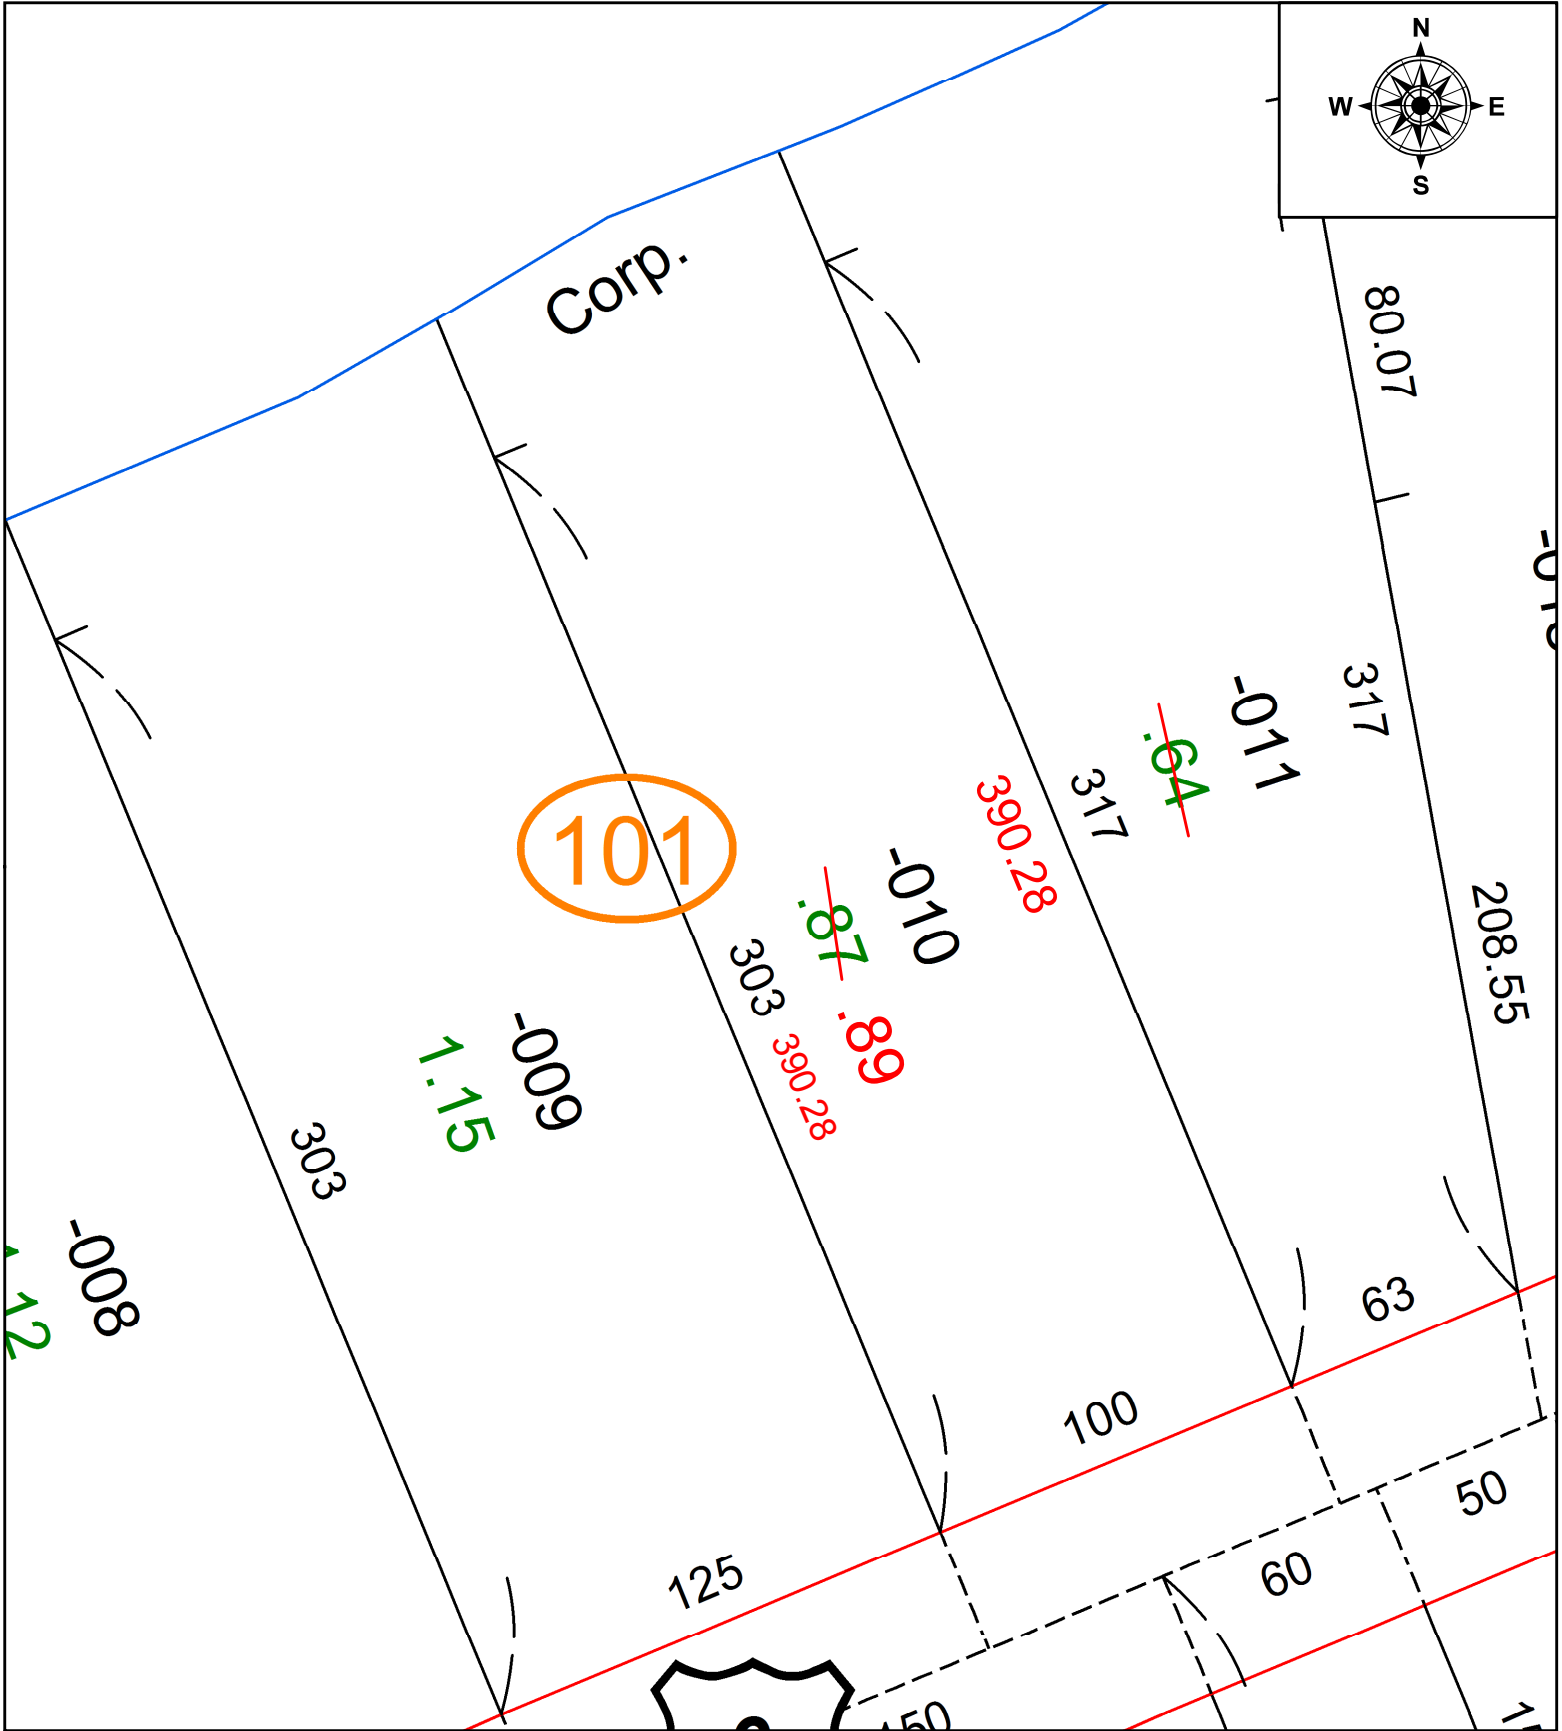

SPLITS/DEEDS PROCESSED
LORAIN COUNTY TAX MAP DEPARTMENT
226 MIDDLE AVE. ELYRIA, OH

SURVEYED BY:	N/A
CLOSURE:	N/A
MAP PAGE(S):	03-00-046
APPROVED BY:	DMA DATE: 3/4/2022
SCALE:	1" = 50' PRIOR INSTRUMENT: 2007-0197650