
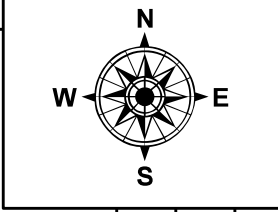
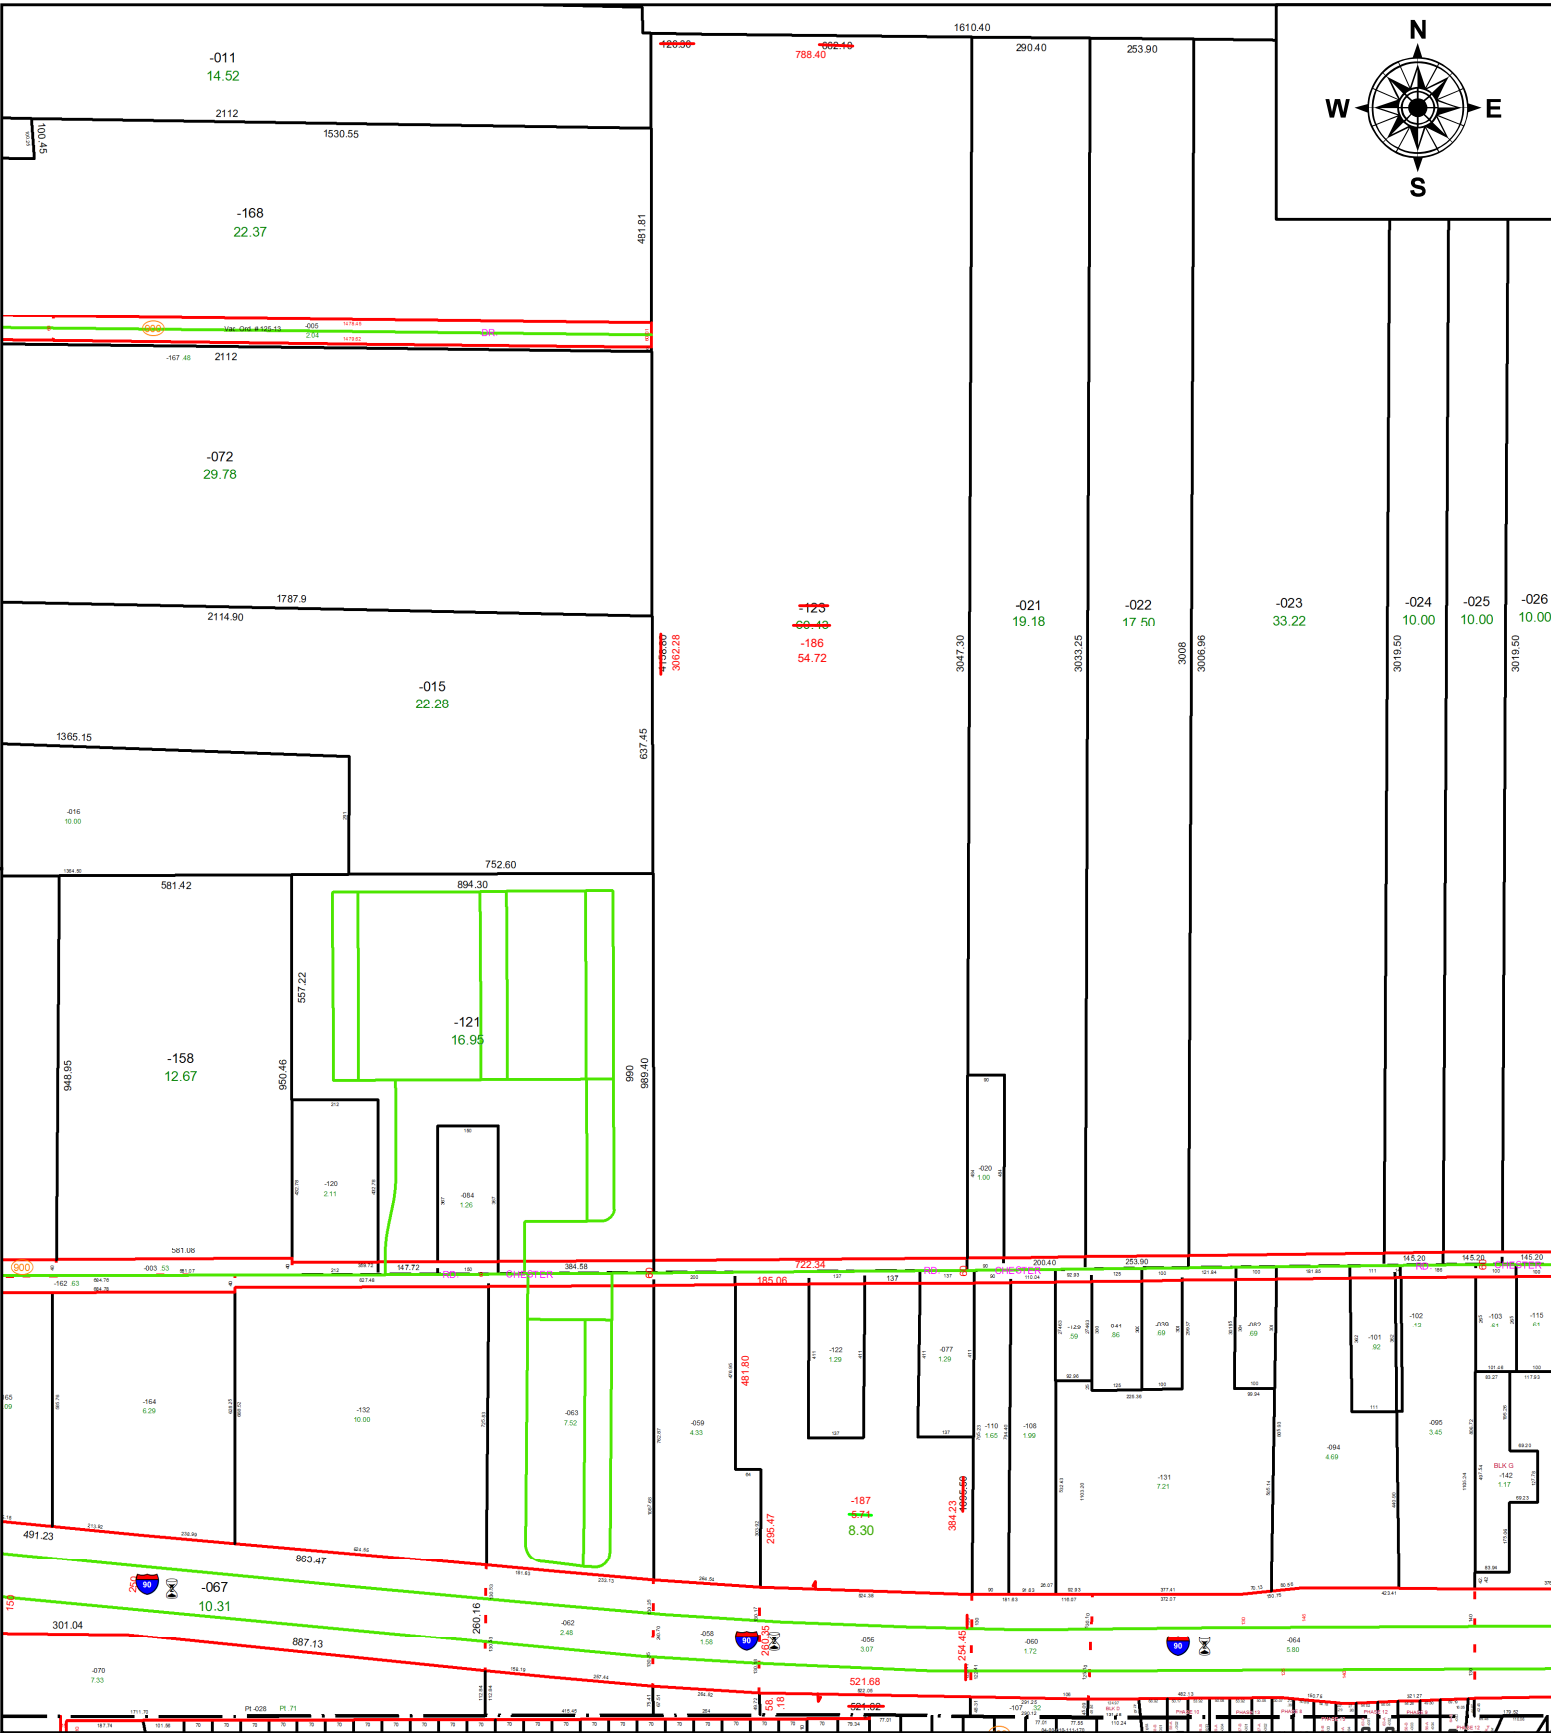


PARENT PARCEL: 04-00-009-000-123
CHILD PARCEL: 04-00-009-000-186 & -187
STARTING POINT: **AC CORR PER SURV BY MICHAEL A. ACKERMAN**

23-04803

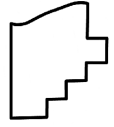

 **SPLITS/DEEDS PROCESSED**
LORAIN COUNTY TAX MAP DEPARTMENT
226 MIDDLE AVE. ELYRIA, OH

SURVEYED BY: MICHAEL A. ACKERMAN **SURV # 51096**
CLOSURE: 1: 640617
MAP PAGE(S): 04-00-009
APPROVED BY: AC **DATE:** January 04, 2024
SCALE: 1 in = 475 ft **PRIOR INSTRUMENT:** 2021- 0832543