


PARENT PARCEL: 05-00-085-000-001

CHILD PARCEL: **AC. CORR. PER PRIOR DEED O.R. VOL. 1422 PG. 418**

STARTING POINT: CL OF STANG RD & N.W. CORNER O.L. 85

22-04808-A

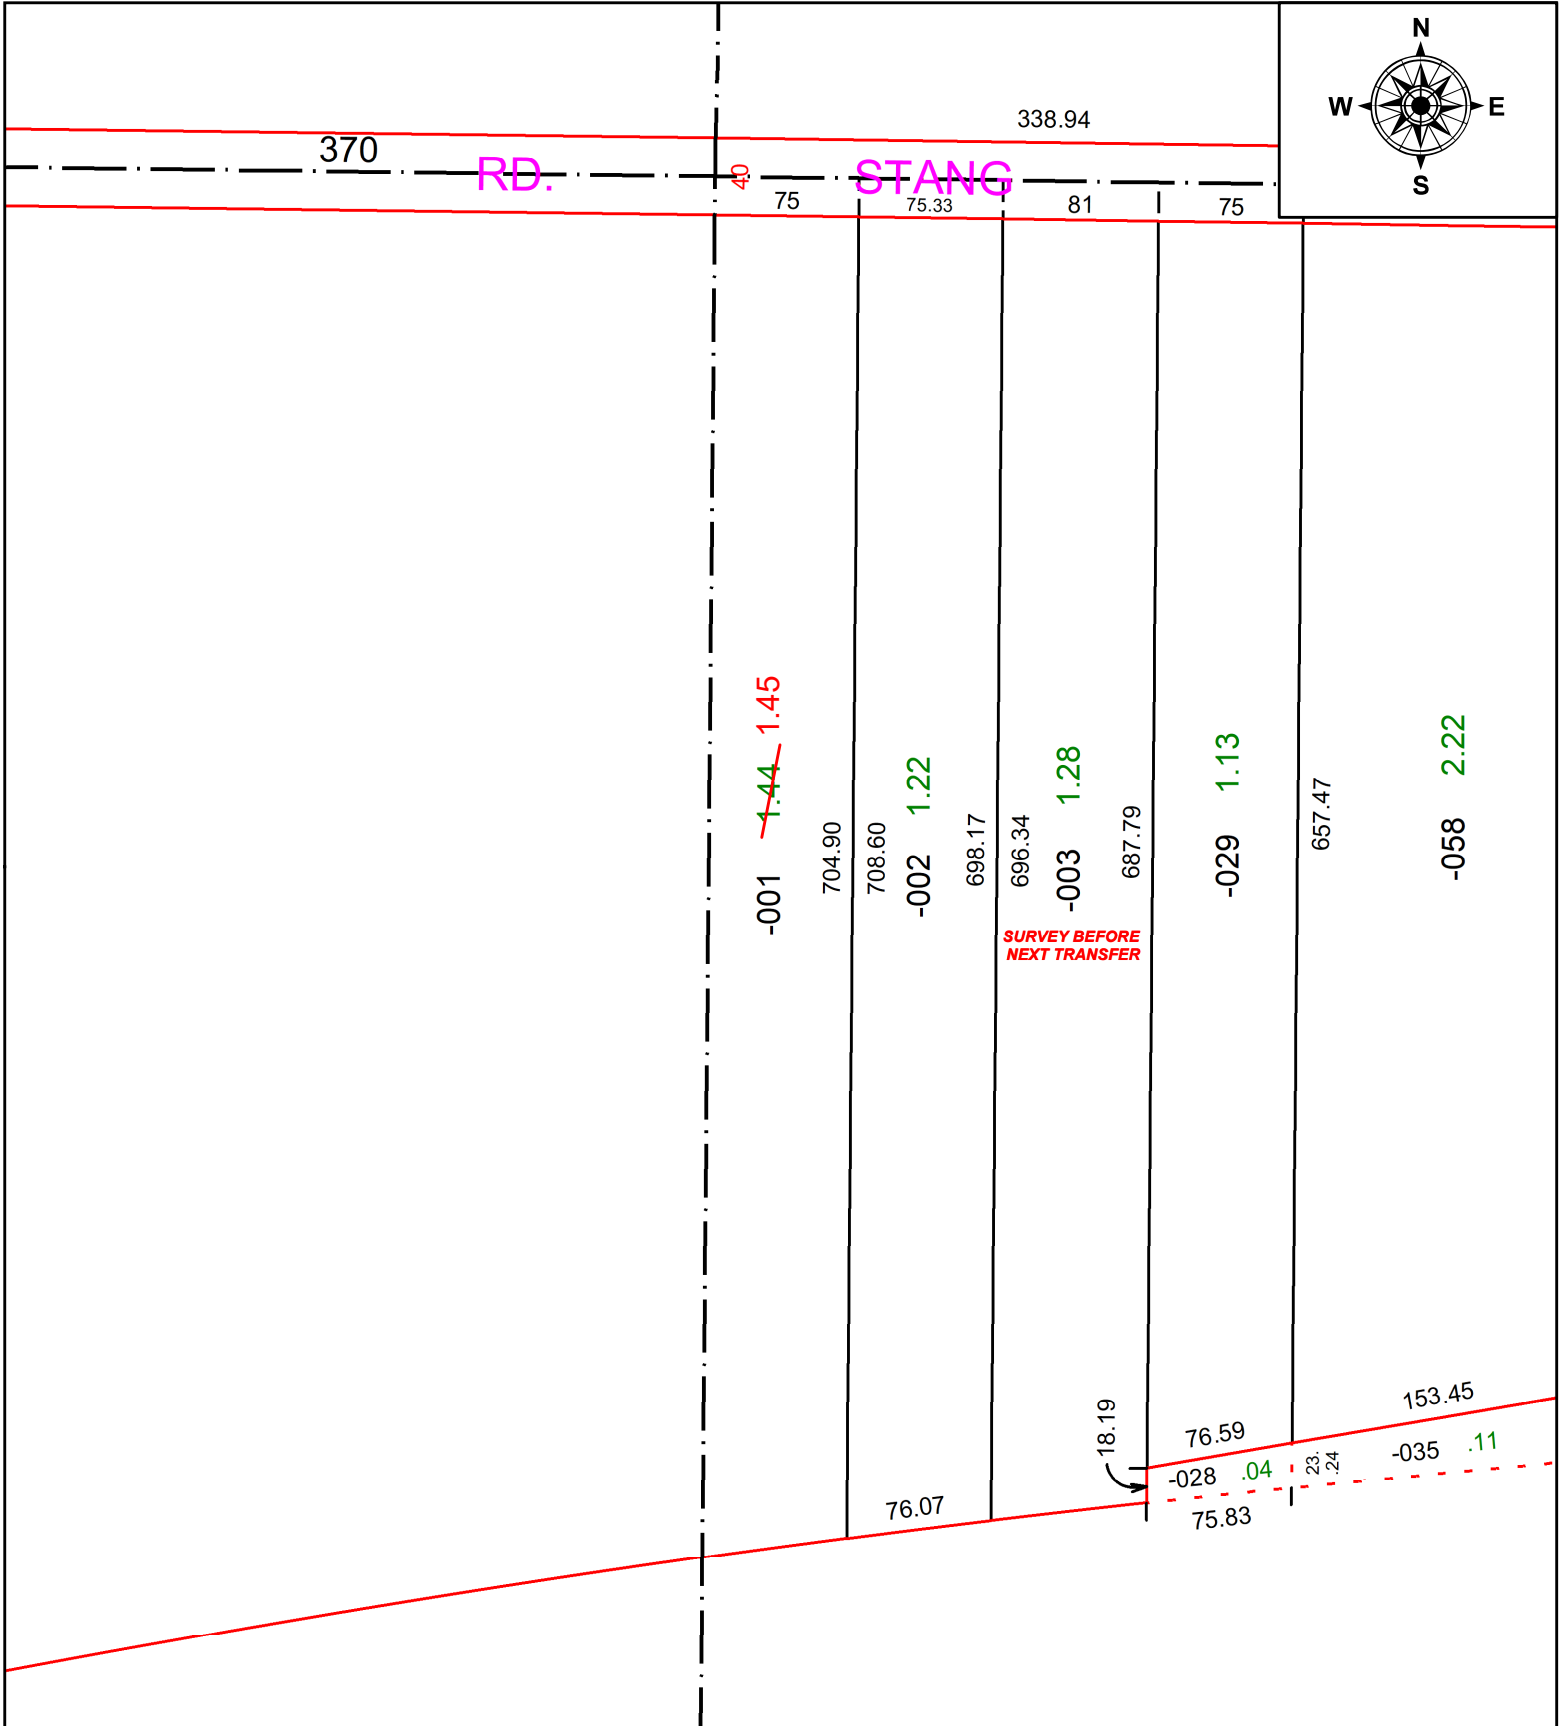

SPLITS/DEEDS PROCESSED
 LORAIN COUNTY TAX MAP DEPARTMENT
 226 MIDDLE AVE. ELYRIA, OH

SURVEYED BY: _____ N/A
 CLOSURE: _____ N/A
 MAP PAGE(S): _____ 05-00-085
 APPROVED BY: _____ DMA DATE: 3/14/2022
 SCALE: 1" = 100' PRIOR INSTRUMENT: O.R. VOL 1422 PG. 418