
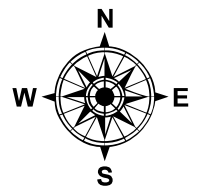


PARENT PARCEL: 04-00-014-104-038

CHILD PARCEL: **AC. CORR. PER PRIOR INSTRUMENT # 2015-0565833**

STARTING POINT: CL OF CENTER RD. & KINZEL RD.

22-04809-A

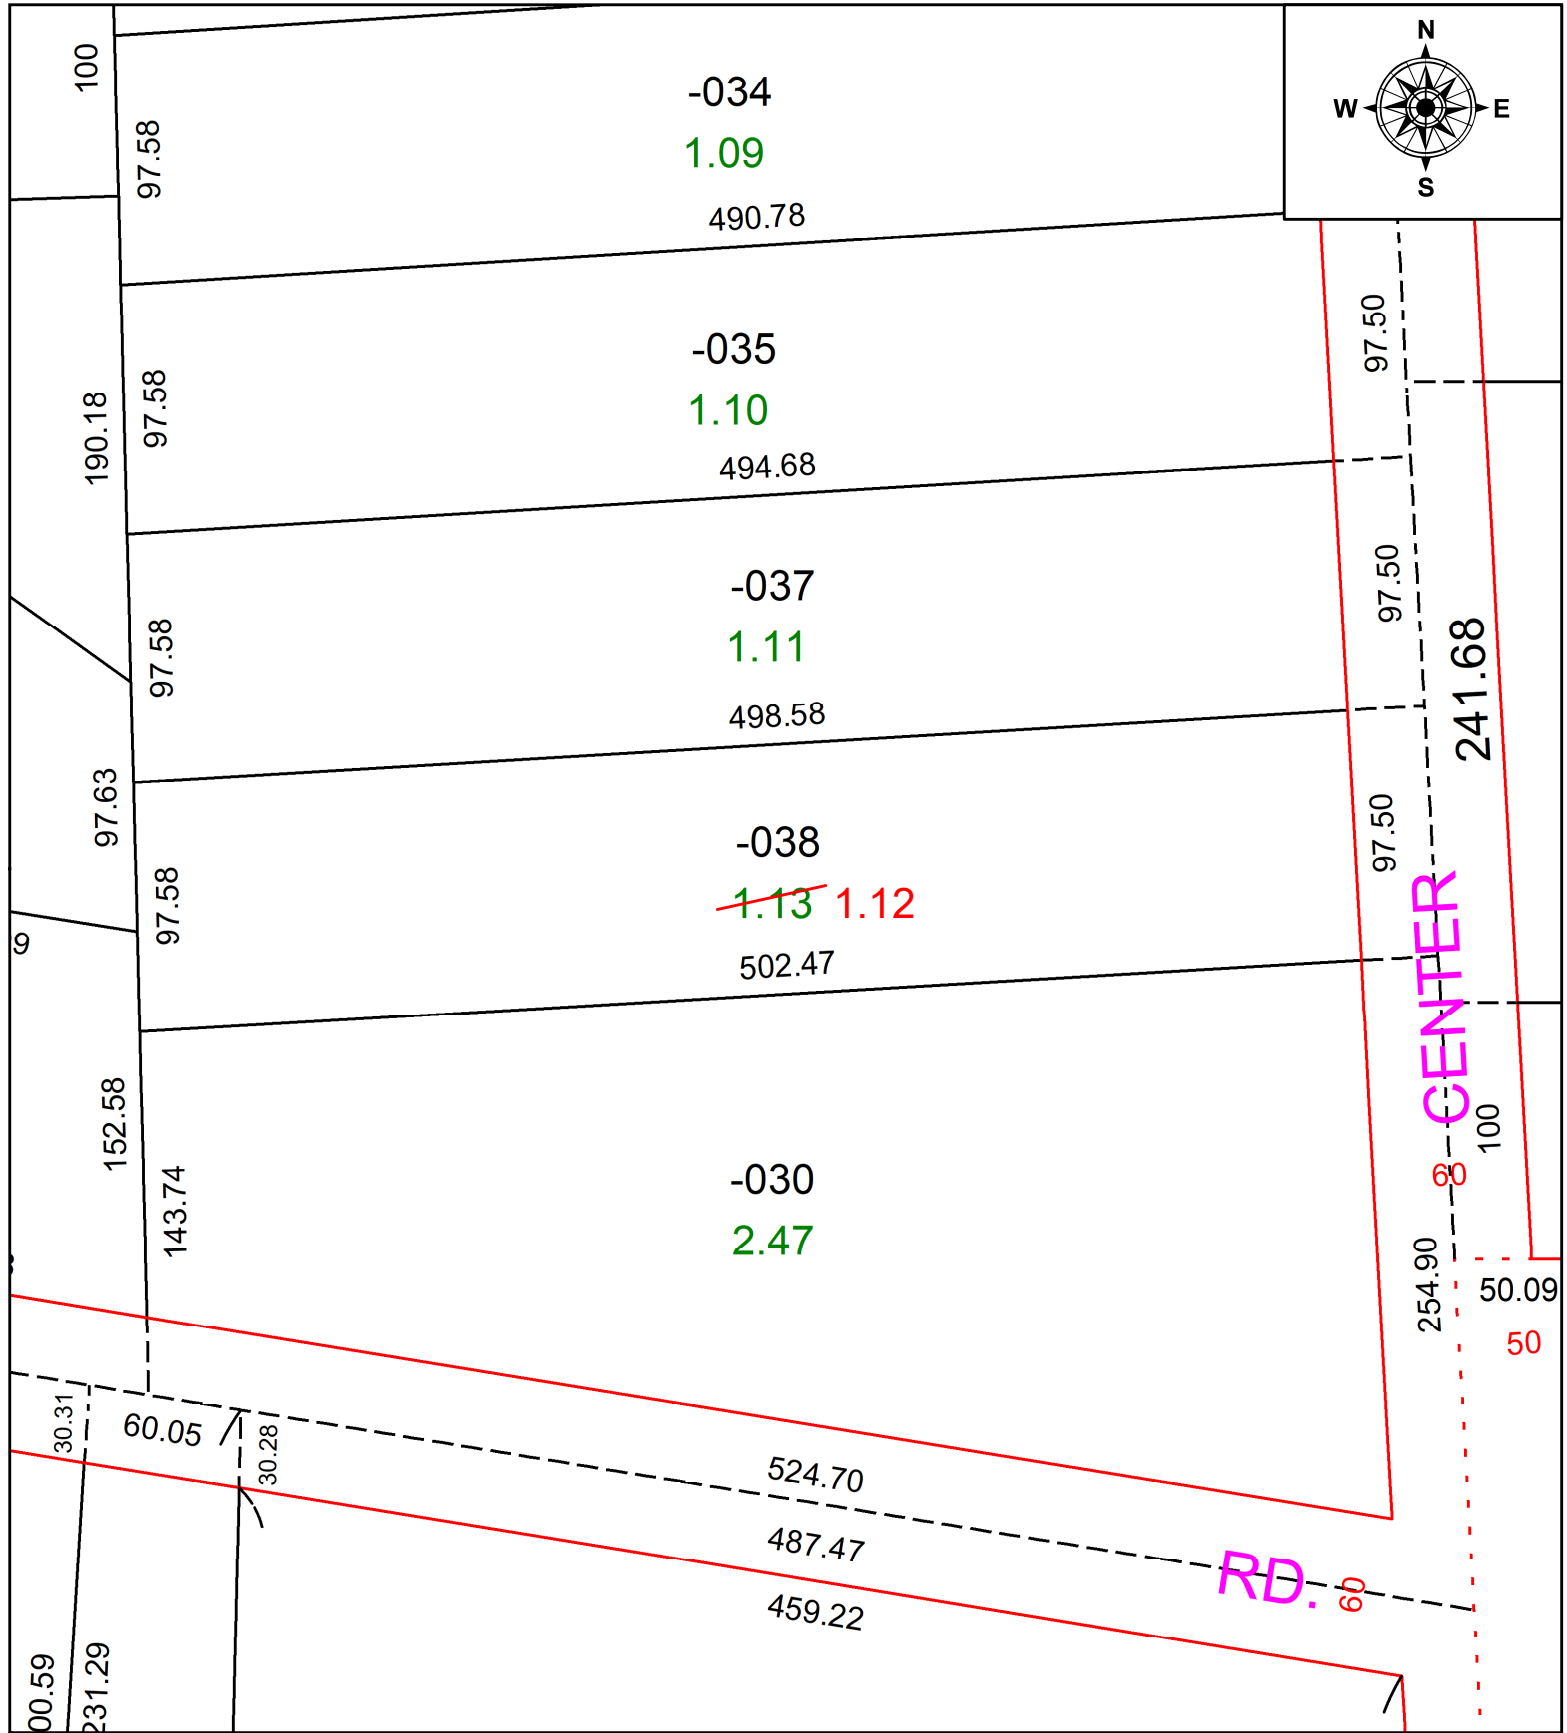

**SPLITS/DEEDS PROCESSED**  
 LORAIN COUNTY TAX MAP DEPARTMENT  
 226 MIDDLE AVE. ELYRIA, OH

SURVEYED BY: \_\_\_\_\_ N/A  
 CLOSURE: \_\_\_\_\_ N/A  
 MAP PAGE(S): \_\_\_\_\_ 04-00-014  
 APPROVED BY: \_\_\_\_\_ DMA DATE: 3/14/2022  
 SCALE: 1" = 75' PRIOR INSTRUMENT: 2015-0565833