
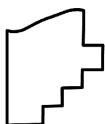


PARENT PARCEL: 15-00-079-000-018

CHILD PARCEL: **MAP CORRECTION ONLY**

STARTING POINT: C/L OF NICKLE-PLATE AND WHITNEY RD

22-04810-C

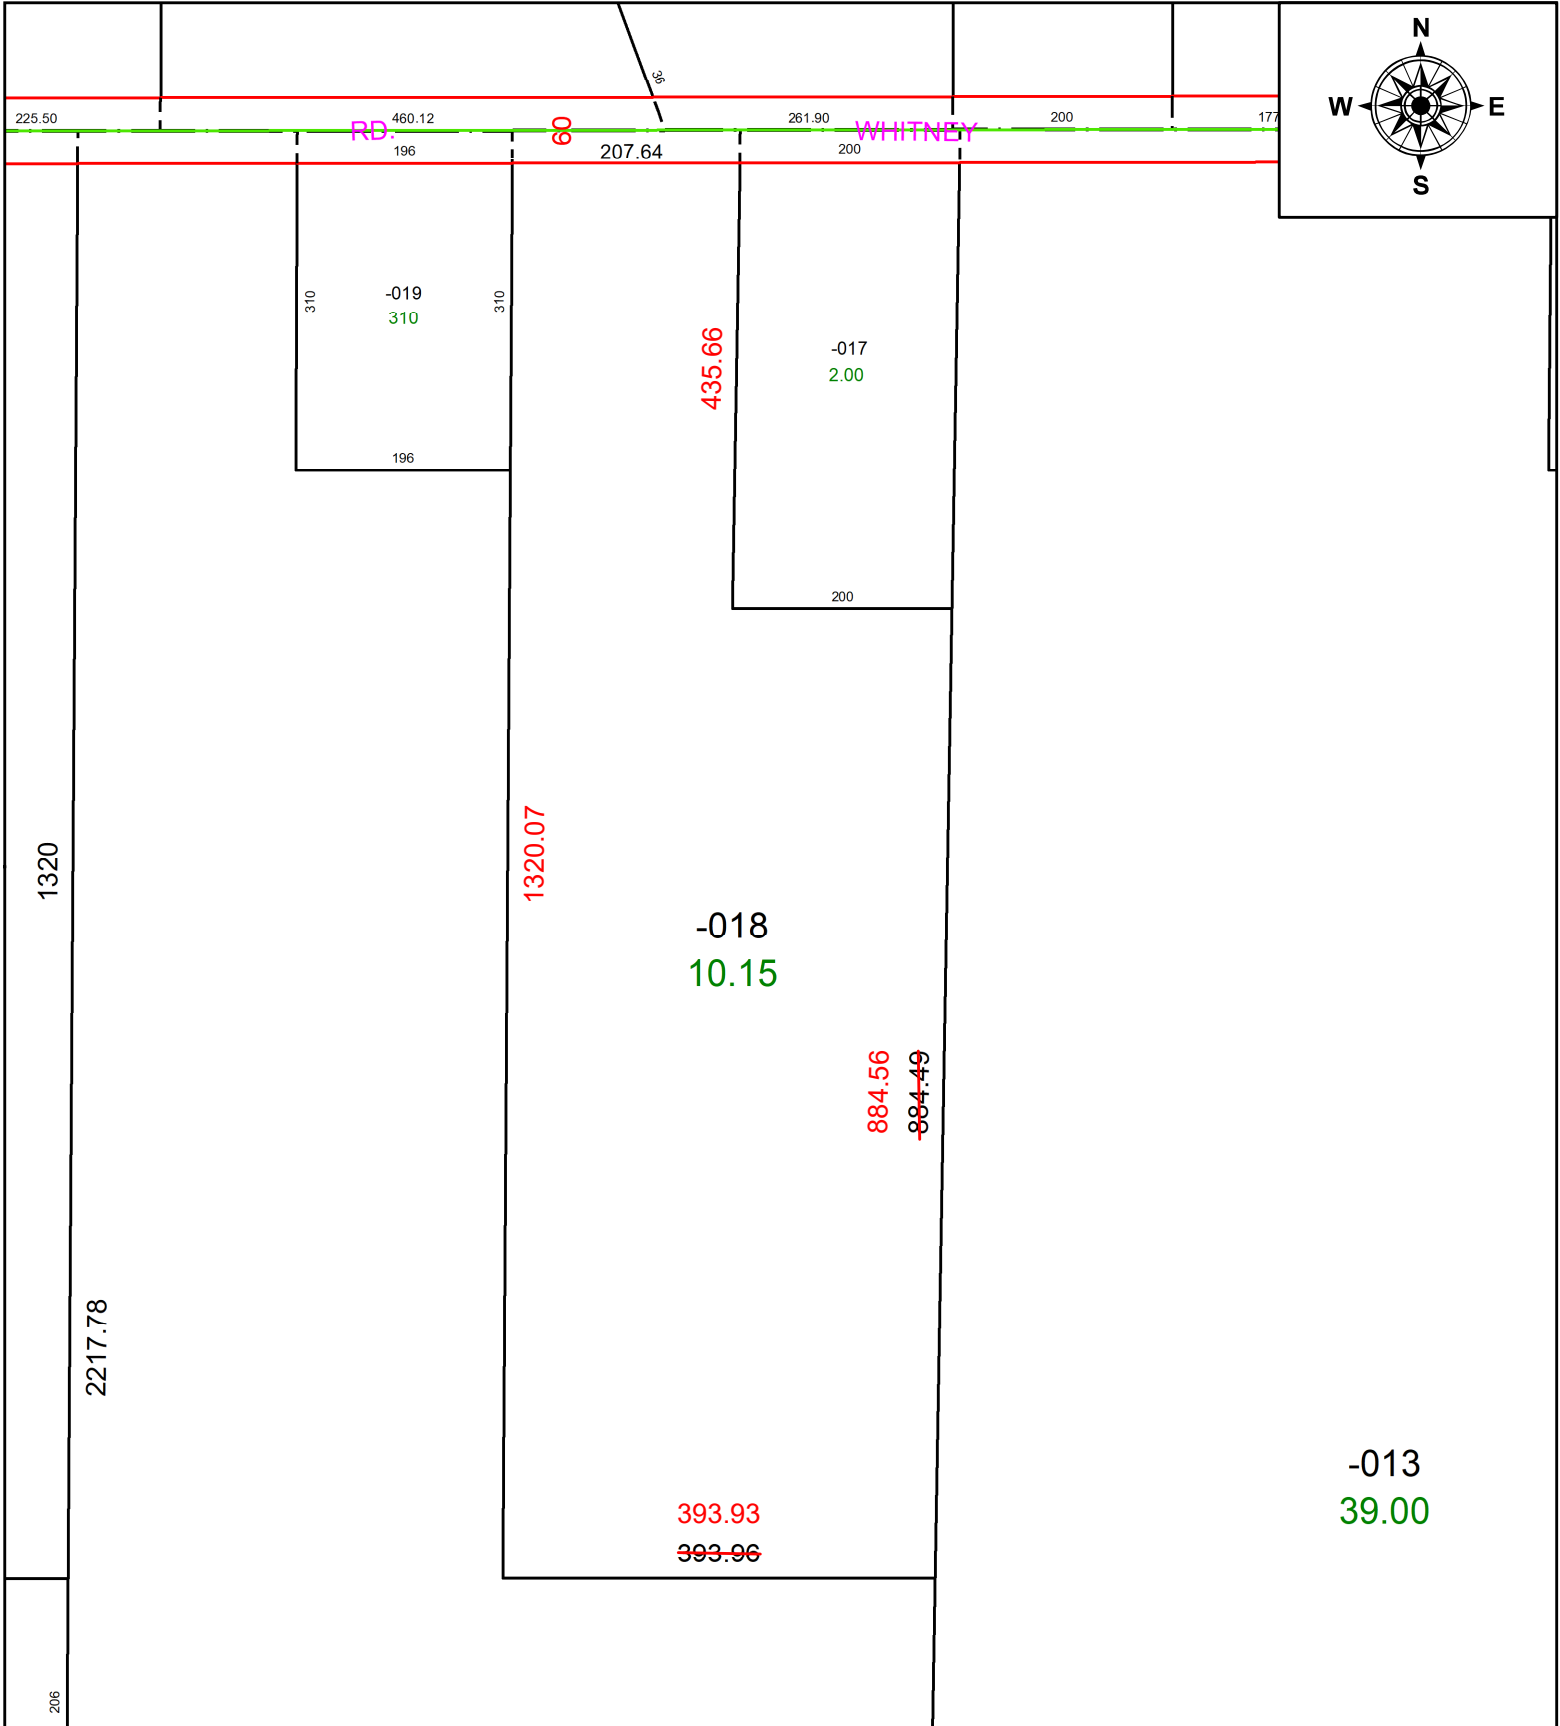

SPLITS/DEEDS PROCESSED
 LORAIN COUNTY TAX MAP DEPARTMENT
 226 MIDDLE AVE. ELYRIA, OH

SURVEYED BY: RICHARD A. FREDRICKSON
CLOSURE: 1: 678826
MAP PAGE(S): 15-00-079
APPROVED BY: AC **DATE:** 3/15/2022
SCALE: 1" = 175 **PRIOR INSTRUMENT:** 2018- 0691368