


PARENT PARCEL: 09-00-045-000-008 & -011

CHILD PARCEL: 09-00-045-000-012, -013, & -014

STARTING POINT: IRON PIN @ INTERSECTION OF C/L OF SR 58 & NORTHEAST CORNER OF O.L. 45

24-04813

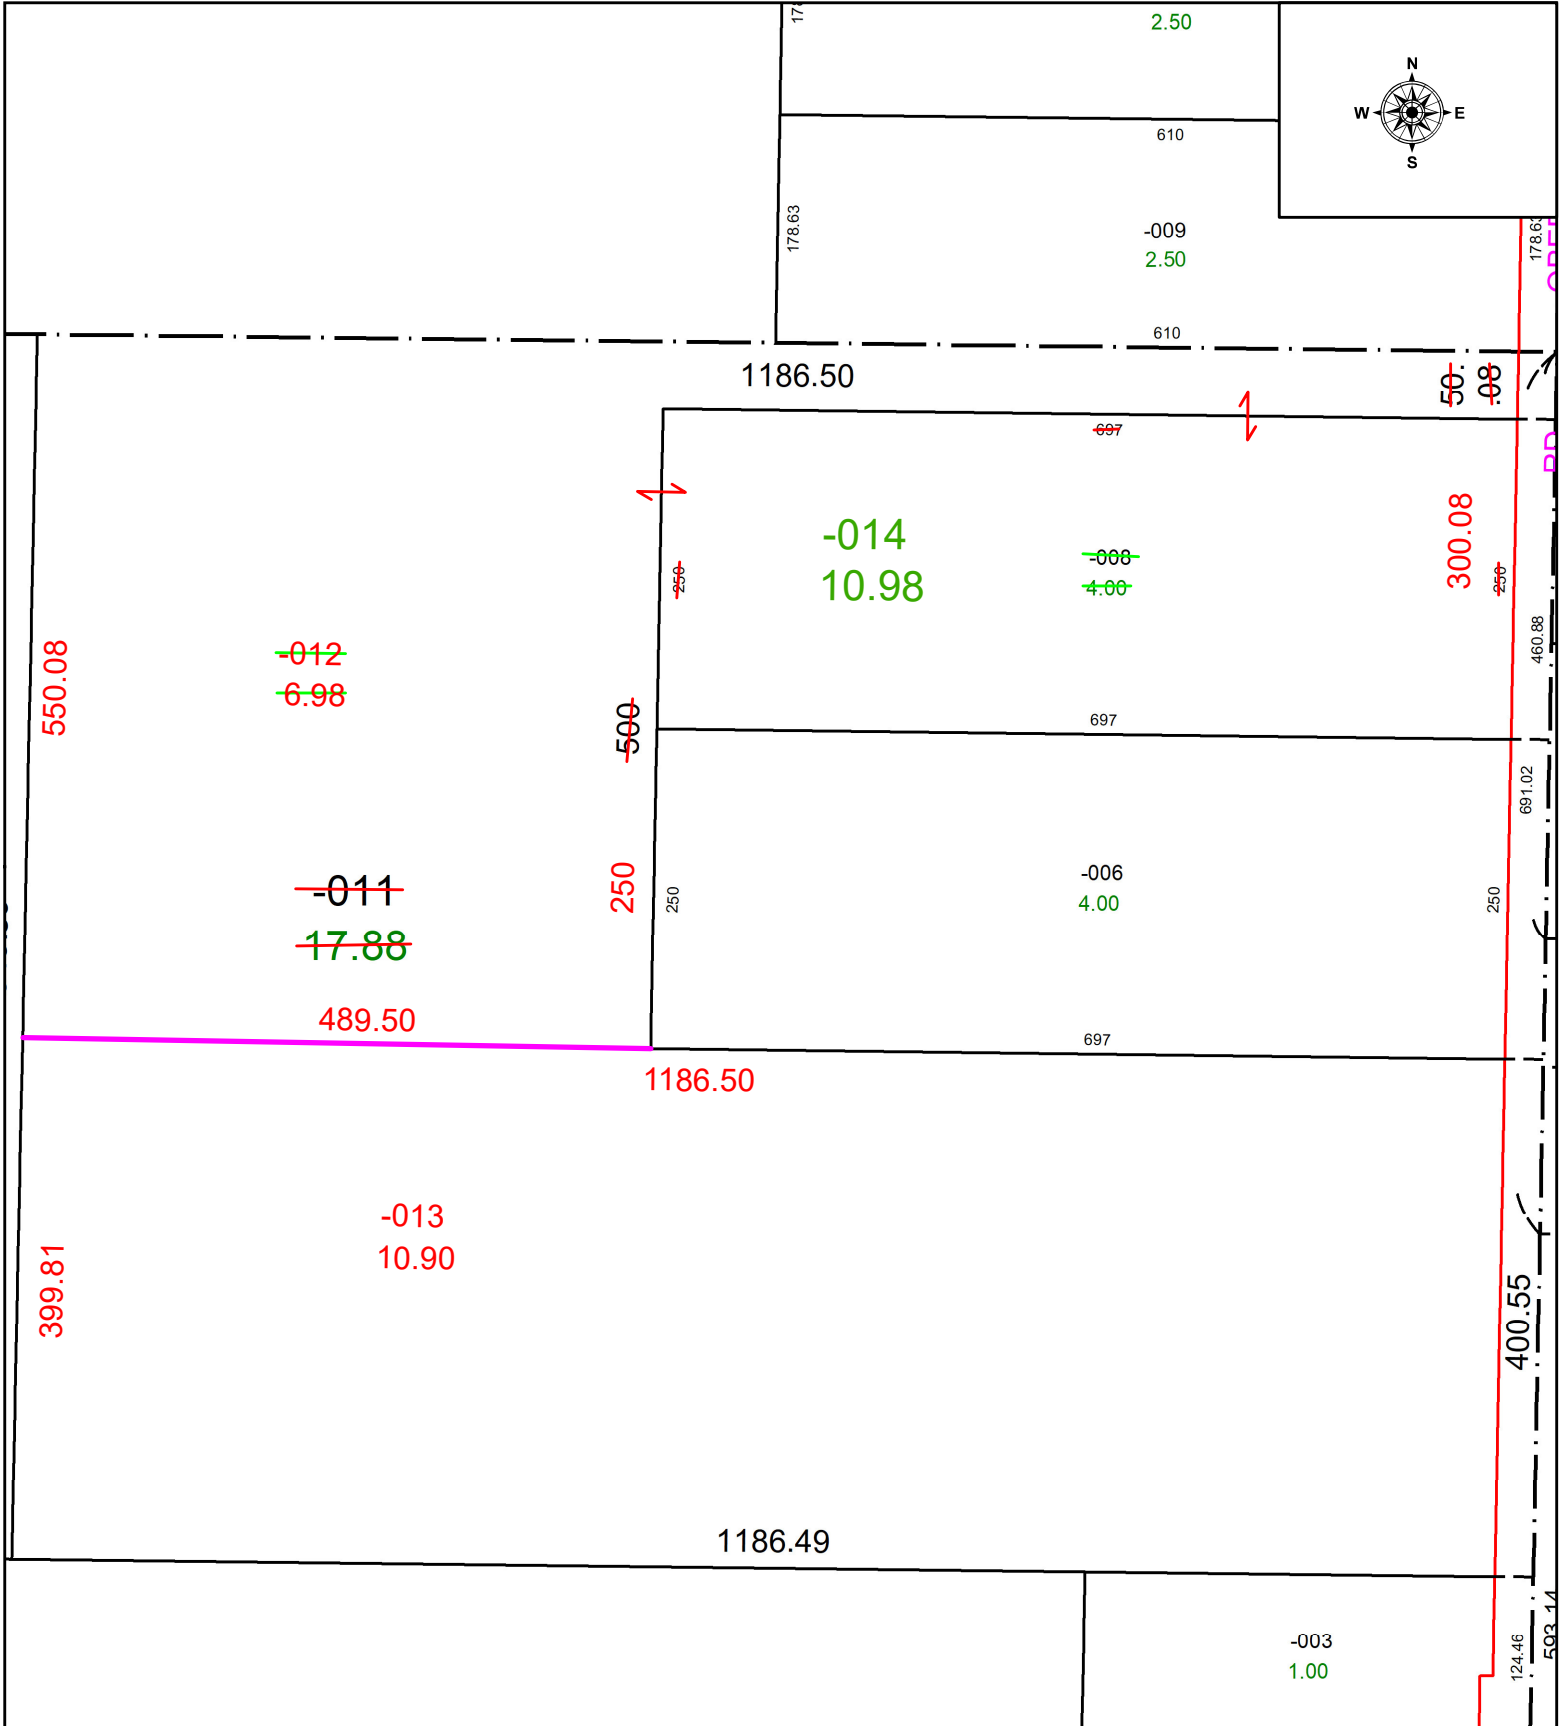

SPLITS/DEEDS PROCESSED
LORAIN COUNTY TAX MAP DEPARTMENT
226 MIDDLE AVE. ELYRIA, OH

SURVEYED BY: TIMOTHY HOZALSKI	SURVEY # 51036
CLOSURE: 1: INF	
MAP PAGE(S): 09-00-045	
APPROVED BY: WRZ	DATE: 2/1/2024
SCALE: 1" = 150	PRIOR INSTRUMENT: #2006-0127215