


PARENT PARCEL: 19-01-062-000-007



CHILD PARCEL: 19-01-062-000-008, -009, & -010

STARTING POINT: IRON PIN IN MONUMENT BOX @ INTERSECTION OF C/L FOSTER RD & SOUTH EAST CORNER OF O.L. 62

24-04816

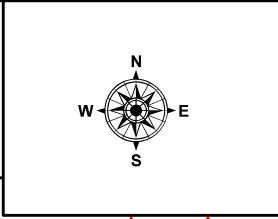

~~007~~ -010
~~4.18~~ 75.95

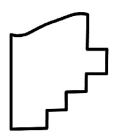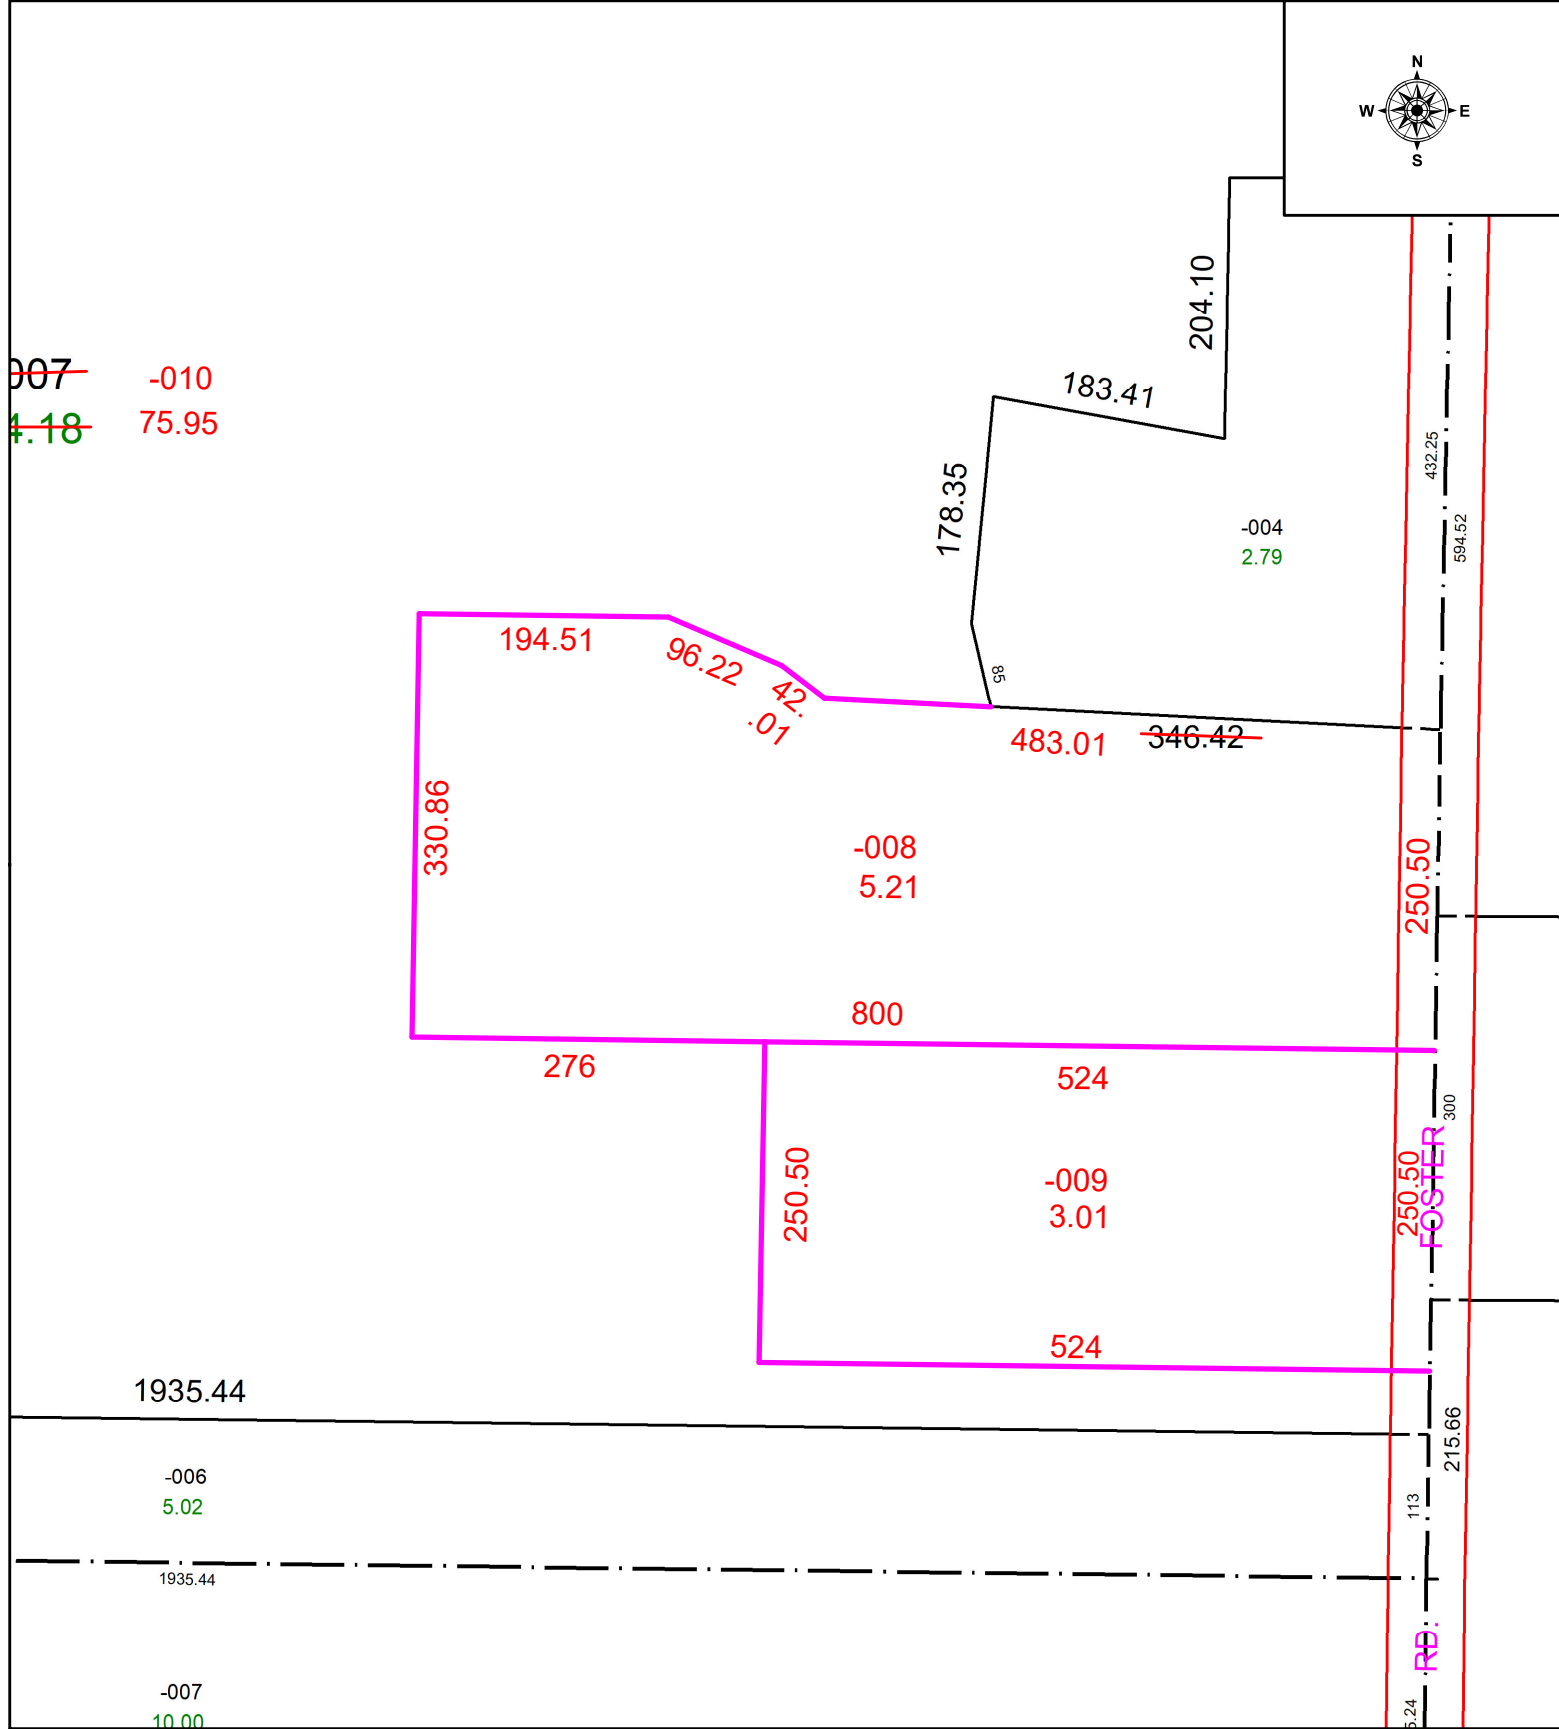

SPLITS/DEEDS PROCESSED
LORAIN COUNTY TAX MAP DEPARTMENT
226 MIDDLE AVE. ELYRIA, OH

SURVEYED BY: TIMOTHY HOZALSKI SURVEY # 51120
CLOSURE: 1: 146053
MAP PAGE(S): 19-01-062
APPROVED BY: WRZ DATE: 2/9/2024
SCALE: 1" = 150 PRIOR INSTRUMENT: DV 1110 PG 835