
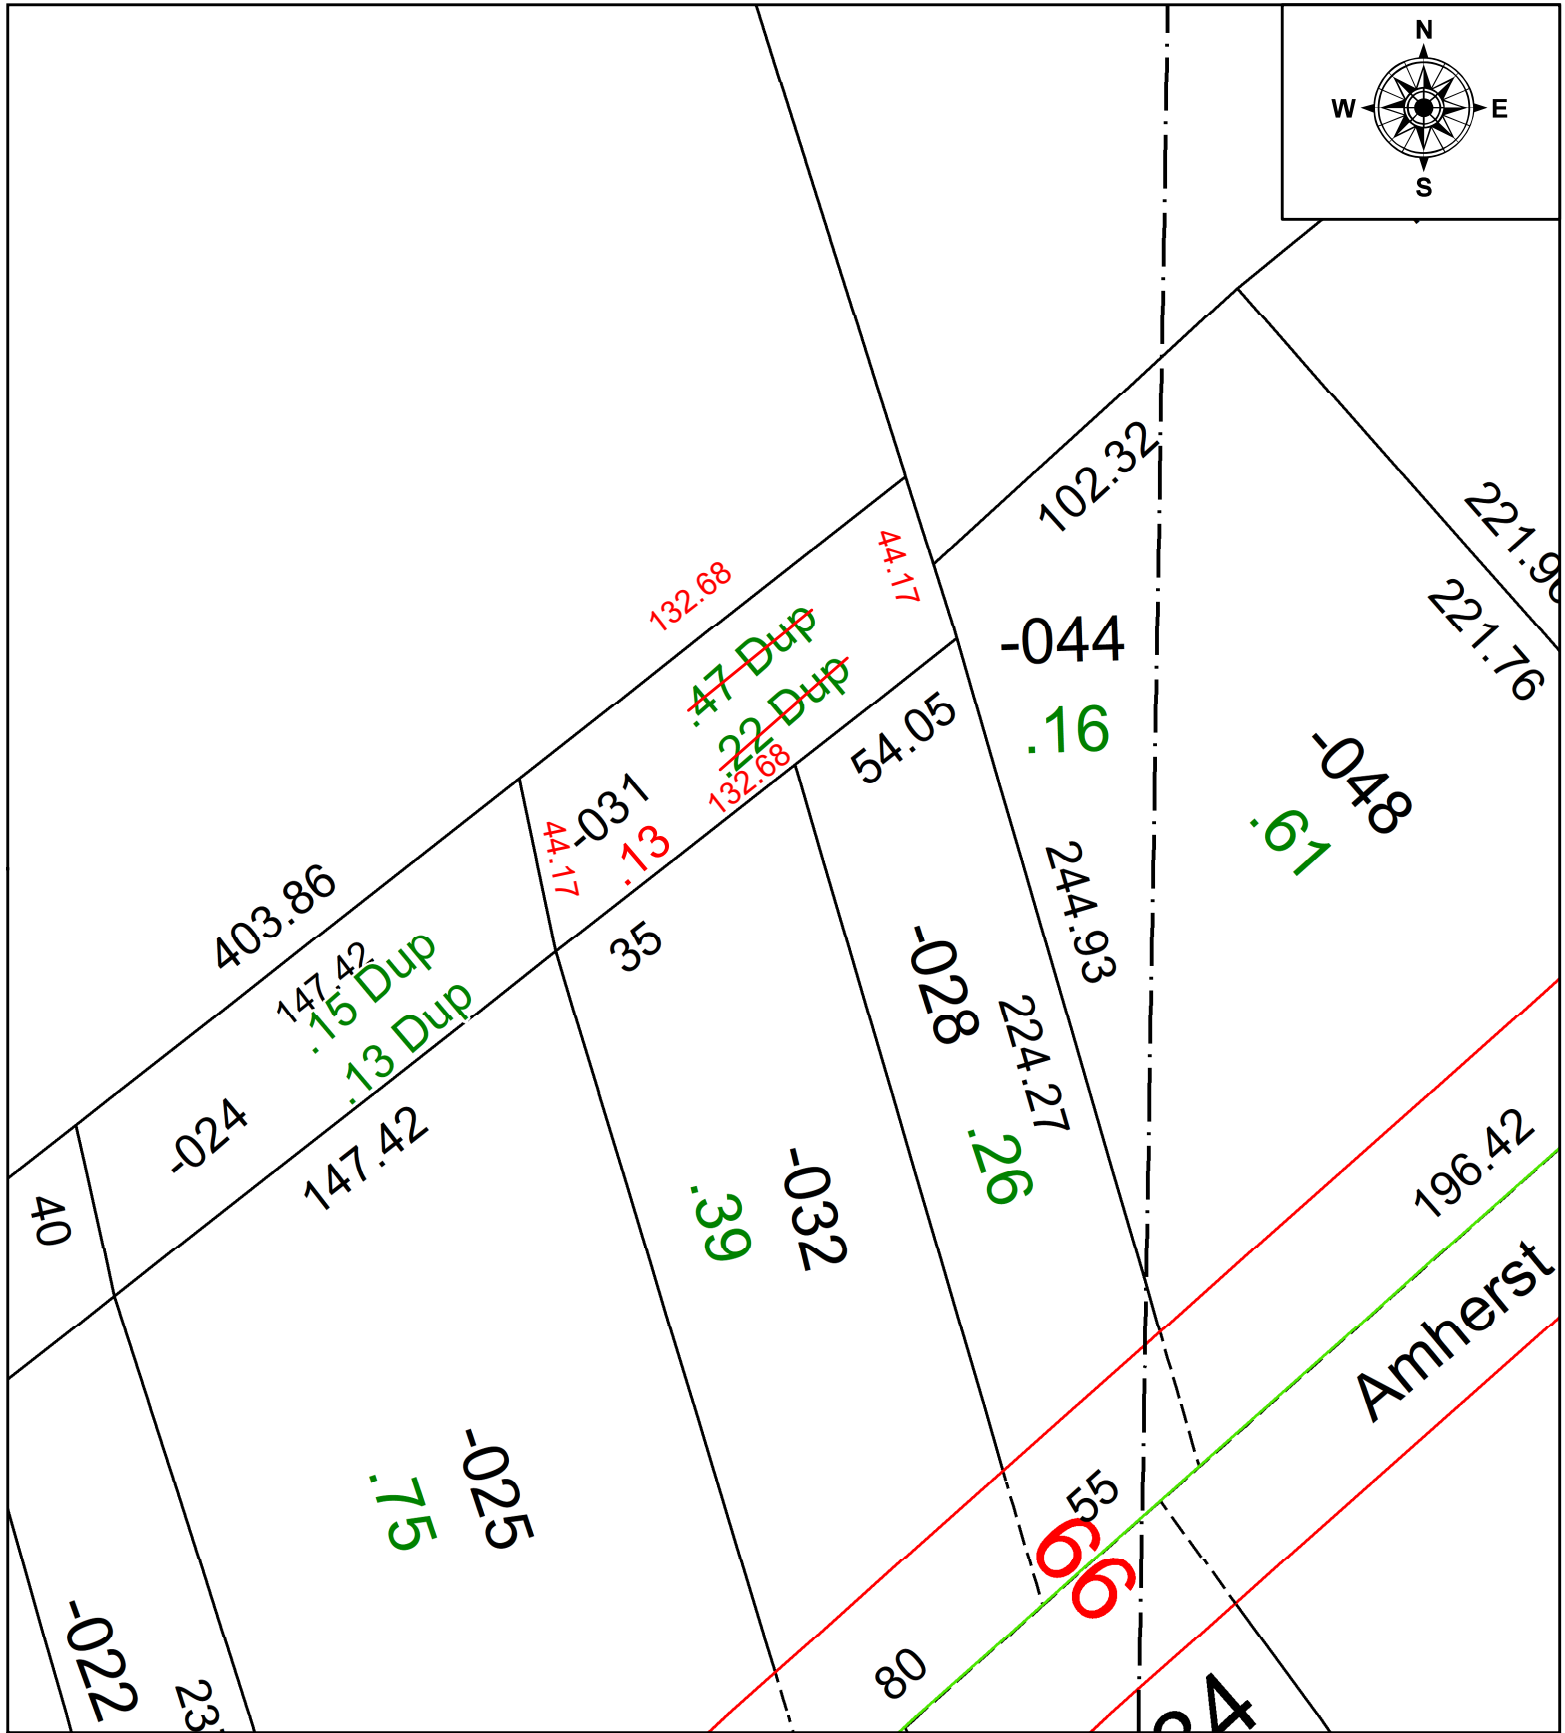


PARENT PARCEL: 05-00-060-103-031

CHILD PARCEL: **AC CORR PER PRIOR DEED VOL 826 PG 66**

STARTING POINT: C/L OF NORTH RIDGE RD AND W LINE MONDAMIN CORP

22-04820-A

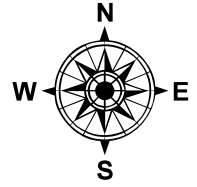

**SPLITS/DEEDS PROCESSED**  
LORAIN COUNTY TAX MAP DEPARTMENT  
226 MIDDLE AVE. ELYRIA, OH

SURVEYED BY: \_\_\_\_\_ N/A  
CLOSURE: \_\_\_\_\_ N/A  
MAP PAGE(S): 05-00-060-B  
APPROVED BY: AC DATE: 3/18/2022  
SCALE: 1" = 50' PRIOR INSTRUMENT: VOL 826 PG 66