
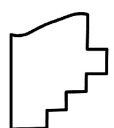


PARENT PARCEL: 15-00-082-000-113 & -265

CHILD PARCEL: 15-00-082-000-267, -268, & -269

STARTING POINT: REBAR @ SOUTHEAST CORNER OF S/L 710 IN PHEASANT RUN VILLAGE PH. 2

24-04820

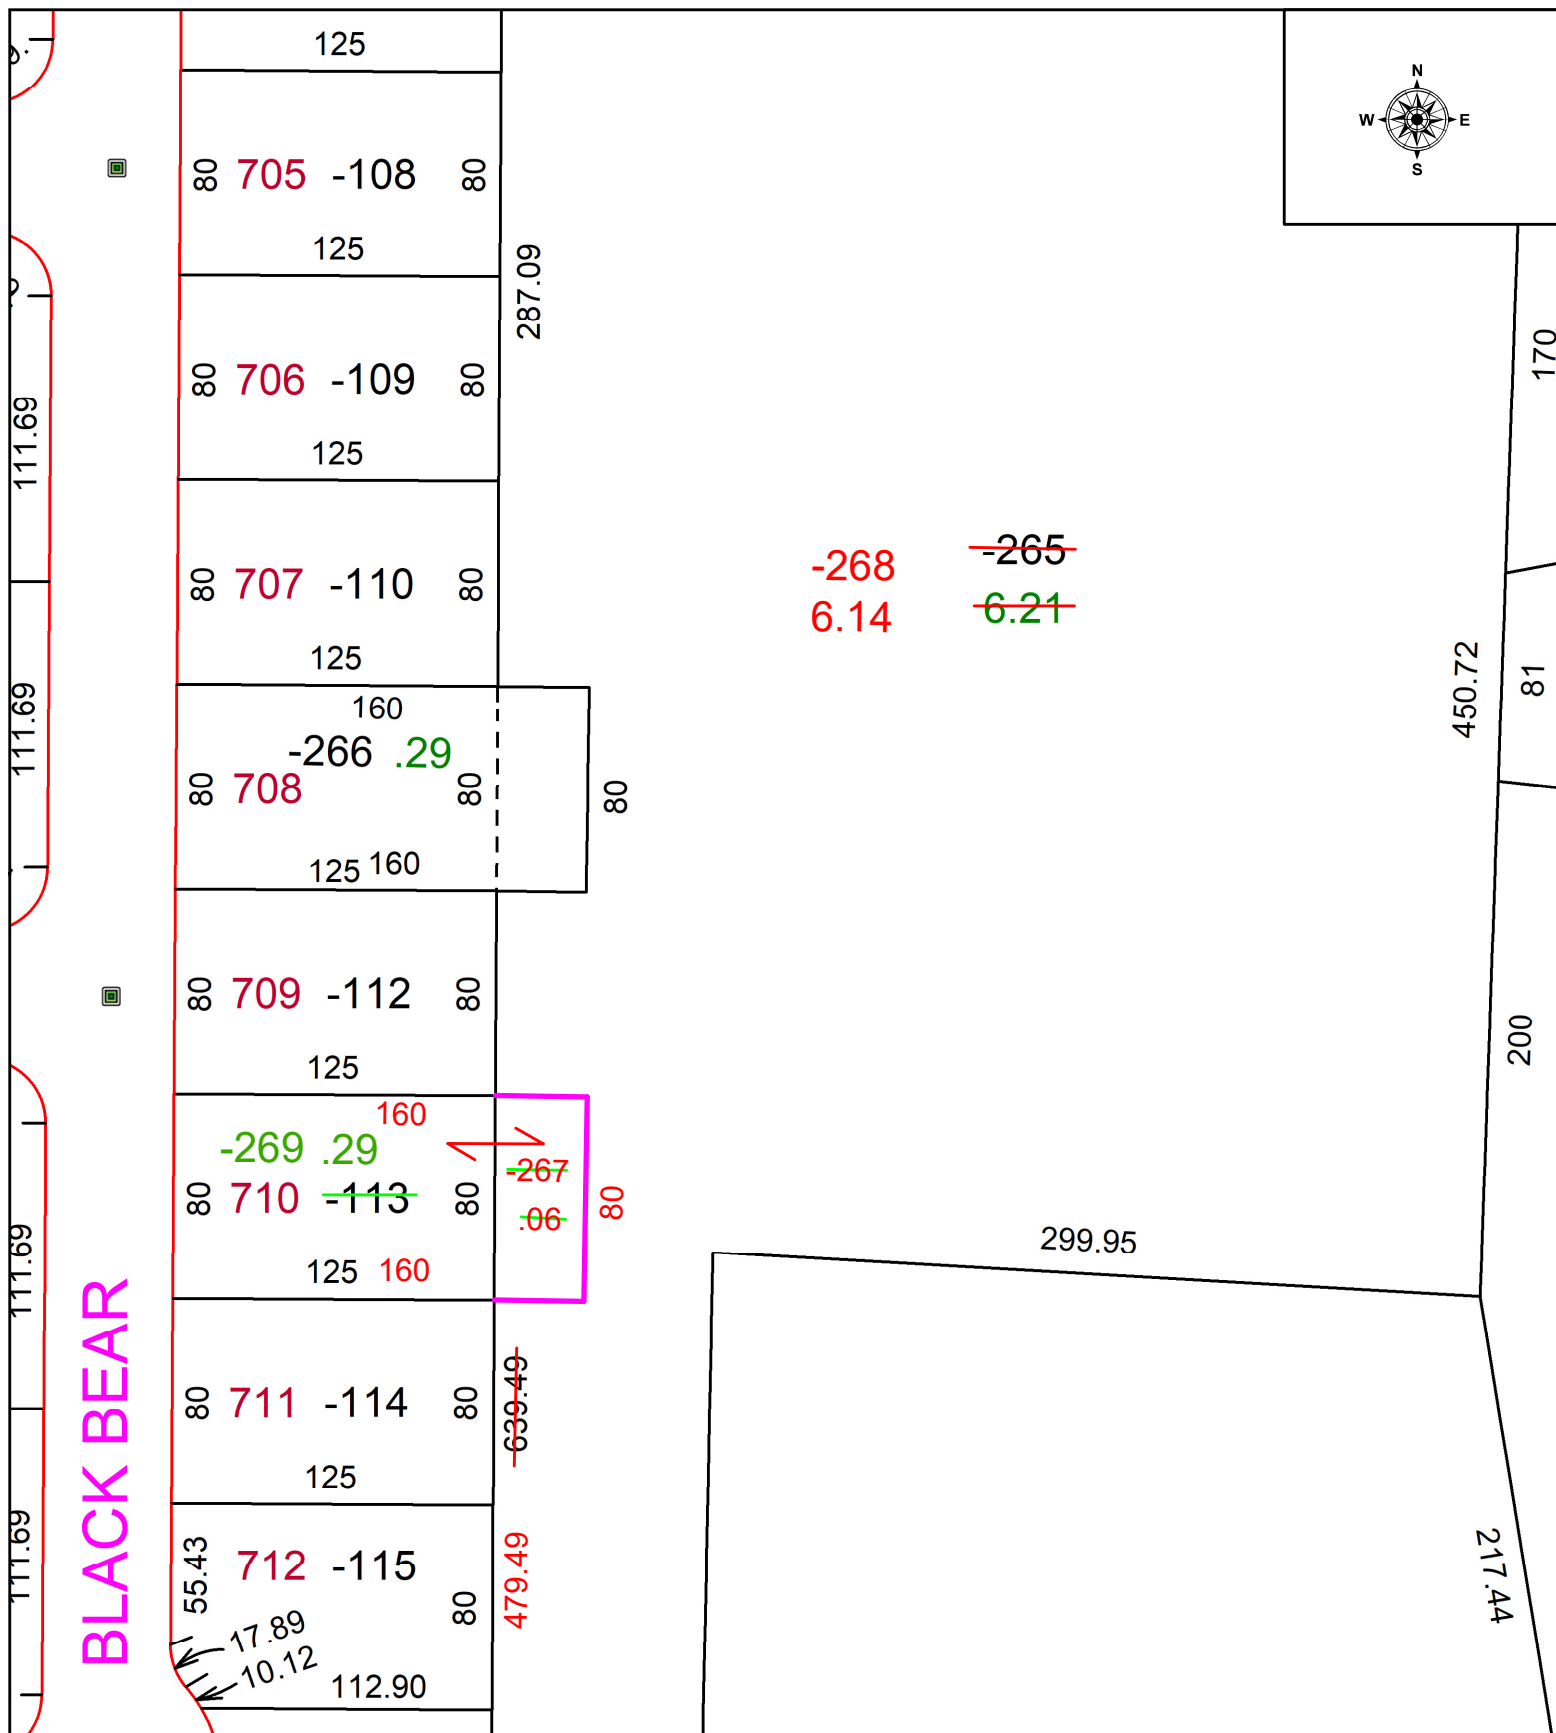

SPLITS/DEEDS PROCESSED
 LORAIN COUNTY TAX MAP DEPARTMENT
 226 MIDDLE AVE. ELYRIA, OH

SURVEYED BY: THEODORE SPILLMAN SURVEY # 51124
 CLOSURE: 1: INF
 MAP PAGE(S): 15-00-082
 APPROVED BY: WRZ DATE: 2/20/2024
 SCALE: 1" = 75' PRIOR INSTRUMENT: #2023-0921583