



PARENT PARCEL: 07-00-021-119-139

CHILD PARCEL: **AC CORR PER SURV BY MICHAEL A. STRAUB**

22-04821-A

STARTING POINT: C/L OF CROSSE RD AND NORTH RIDGE RD

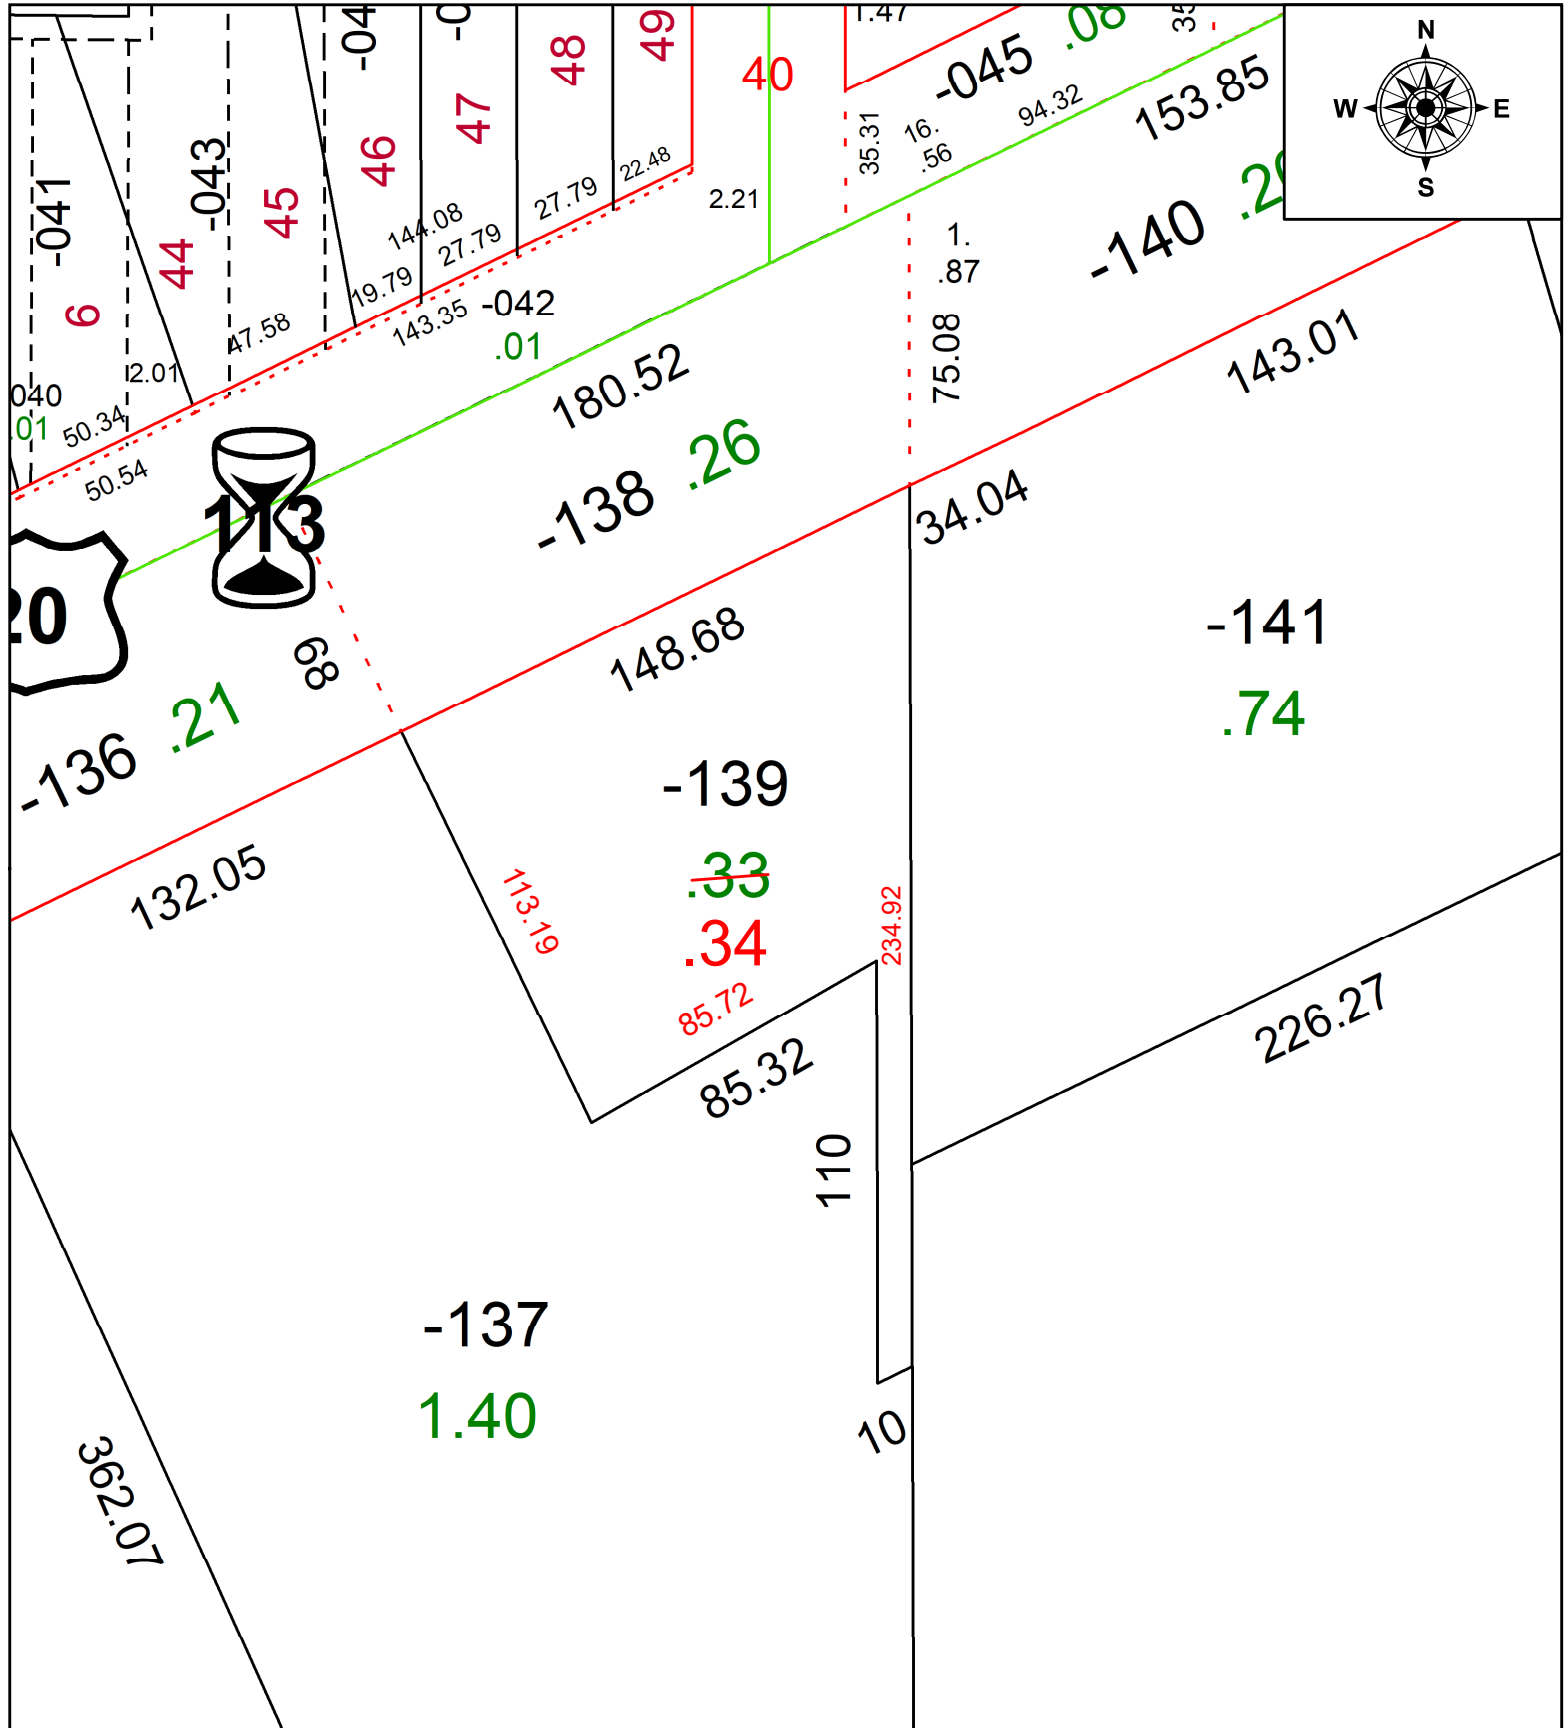

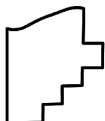 **SPLITS/DEEDS PROCESSED**  
 LORAIN COUNTY TAX MAP DEPARTMENT  
 226 MIDDLE AVE. ELYRIA, OH

SURVEYED BY: MICHAEL A. STRAUB  
 CLOSURE: 1: 195357  
 MAP PAGE(S): 07-00-021-D  
 APPROVED BY: AC DATE: 3/29/2022  
 SCALE: 1" = 50 PRIOR INSTRUMENT: 2014- 0528224