


PARENT PARCEL: 07-00-046-107-017

CHILD PARCEL: 07-00-046-107-021 & -022 **AC CORR PER SURV BY ROBERT M. RUFFING**

STARTING POINT: C/L OF FLOWLER'S RUN AND N ROF OF CENTER RIDGE RD

24-04822

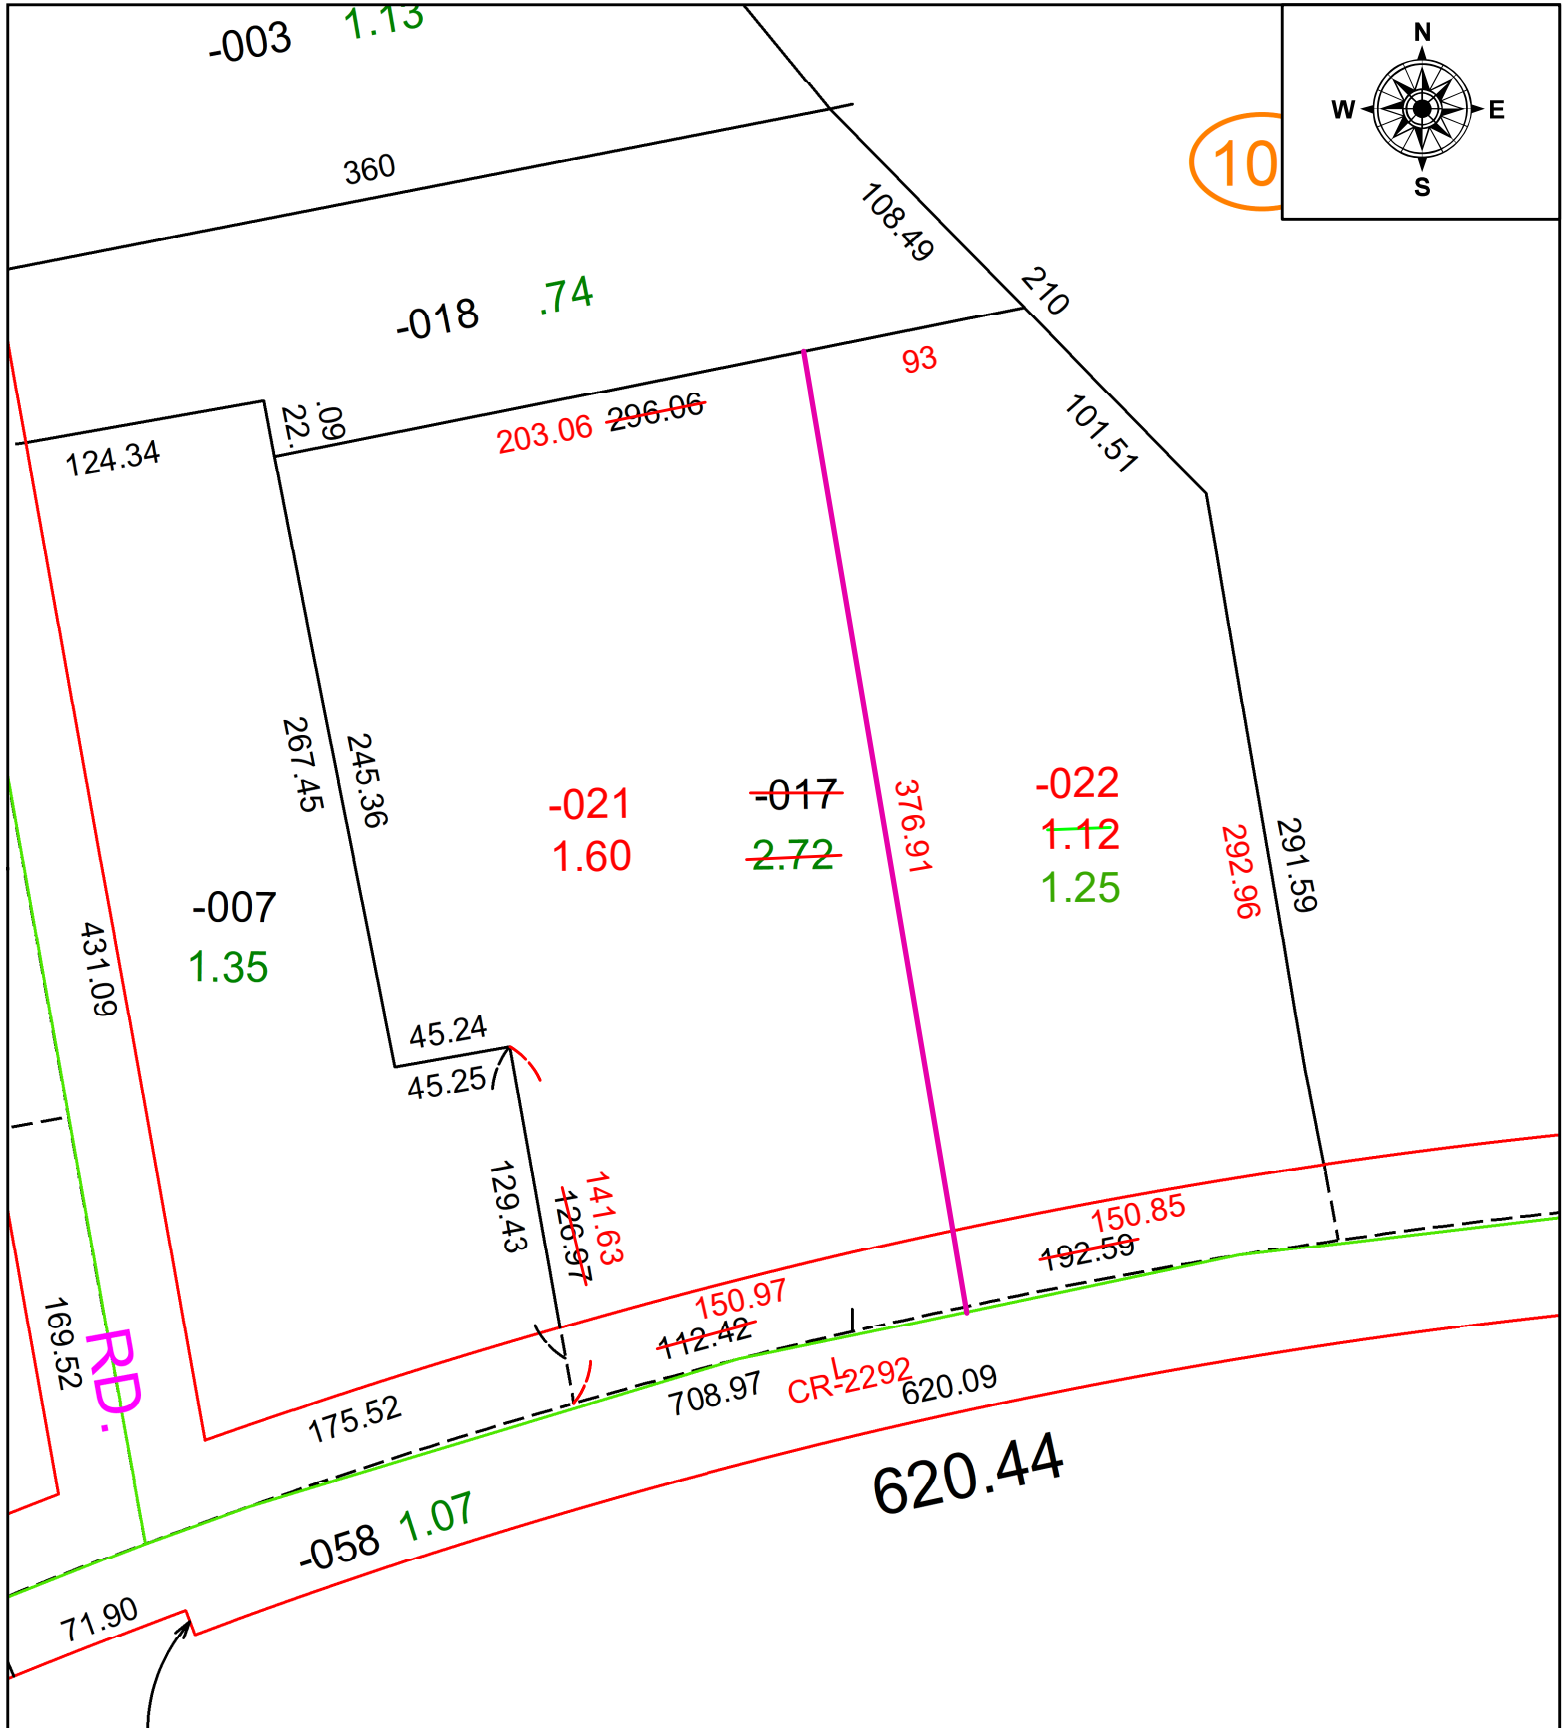

SPLITS/DEEDS PROCESSED
 LORAIN COUNTY TAX MAP DEPARTMENT
 226 MIDDLE AVE. ELYRIA, OH

SURVEYED BY: ROBERT M. RUFFING **SURV # 51126**
CLOSURE: 1: 146957
MAP PAGE(S): 07-00-046
APPROVED BY: AC **DATE:** February 26, 2024
SCALE: 1 in = 75 ft **PRIOR INSTRUMENT:** 2023- 0938632