
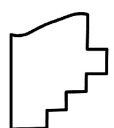


PARENT PARCEL: 03-00-015-000-104

CHILD PARCEL: 03-00-015-000-105, -106, & -107

STARTING POINT: MONUMENT BOX @ INTERSECTION OF ABBE RD & FRENCH CREEK RD

24-04823

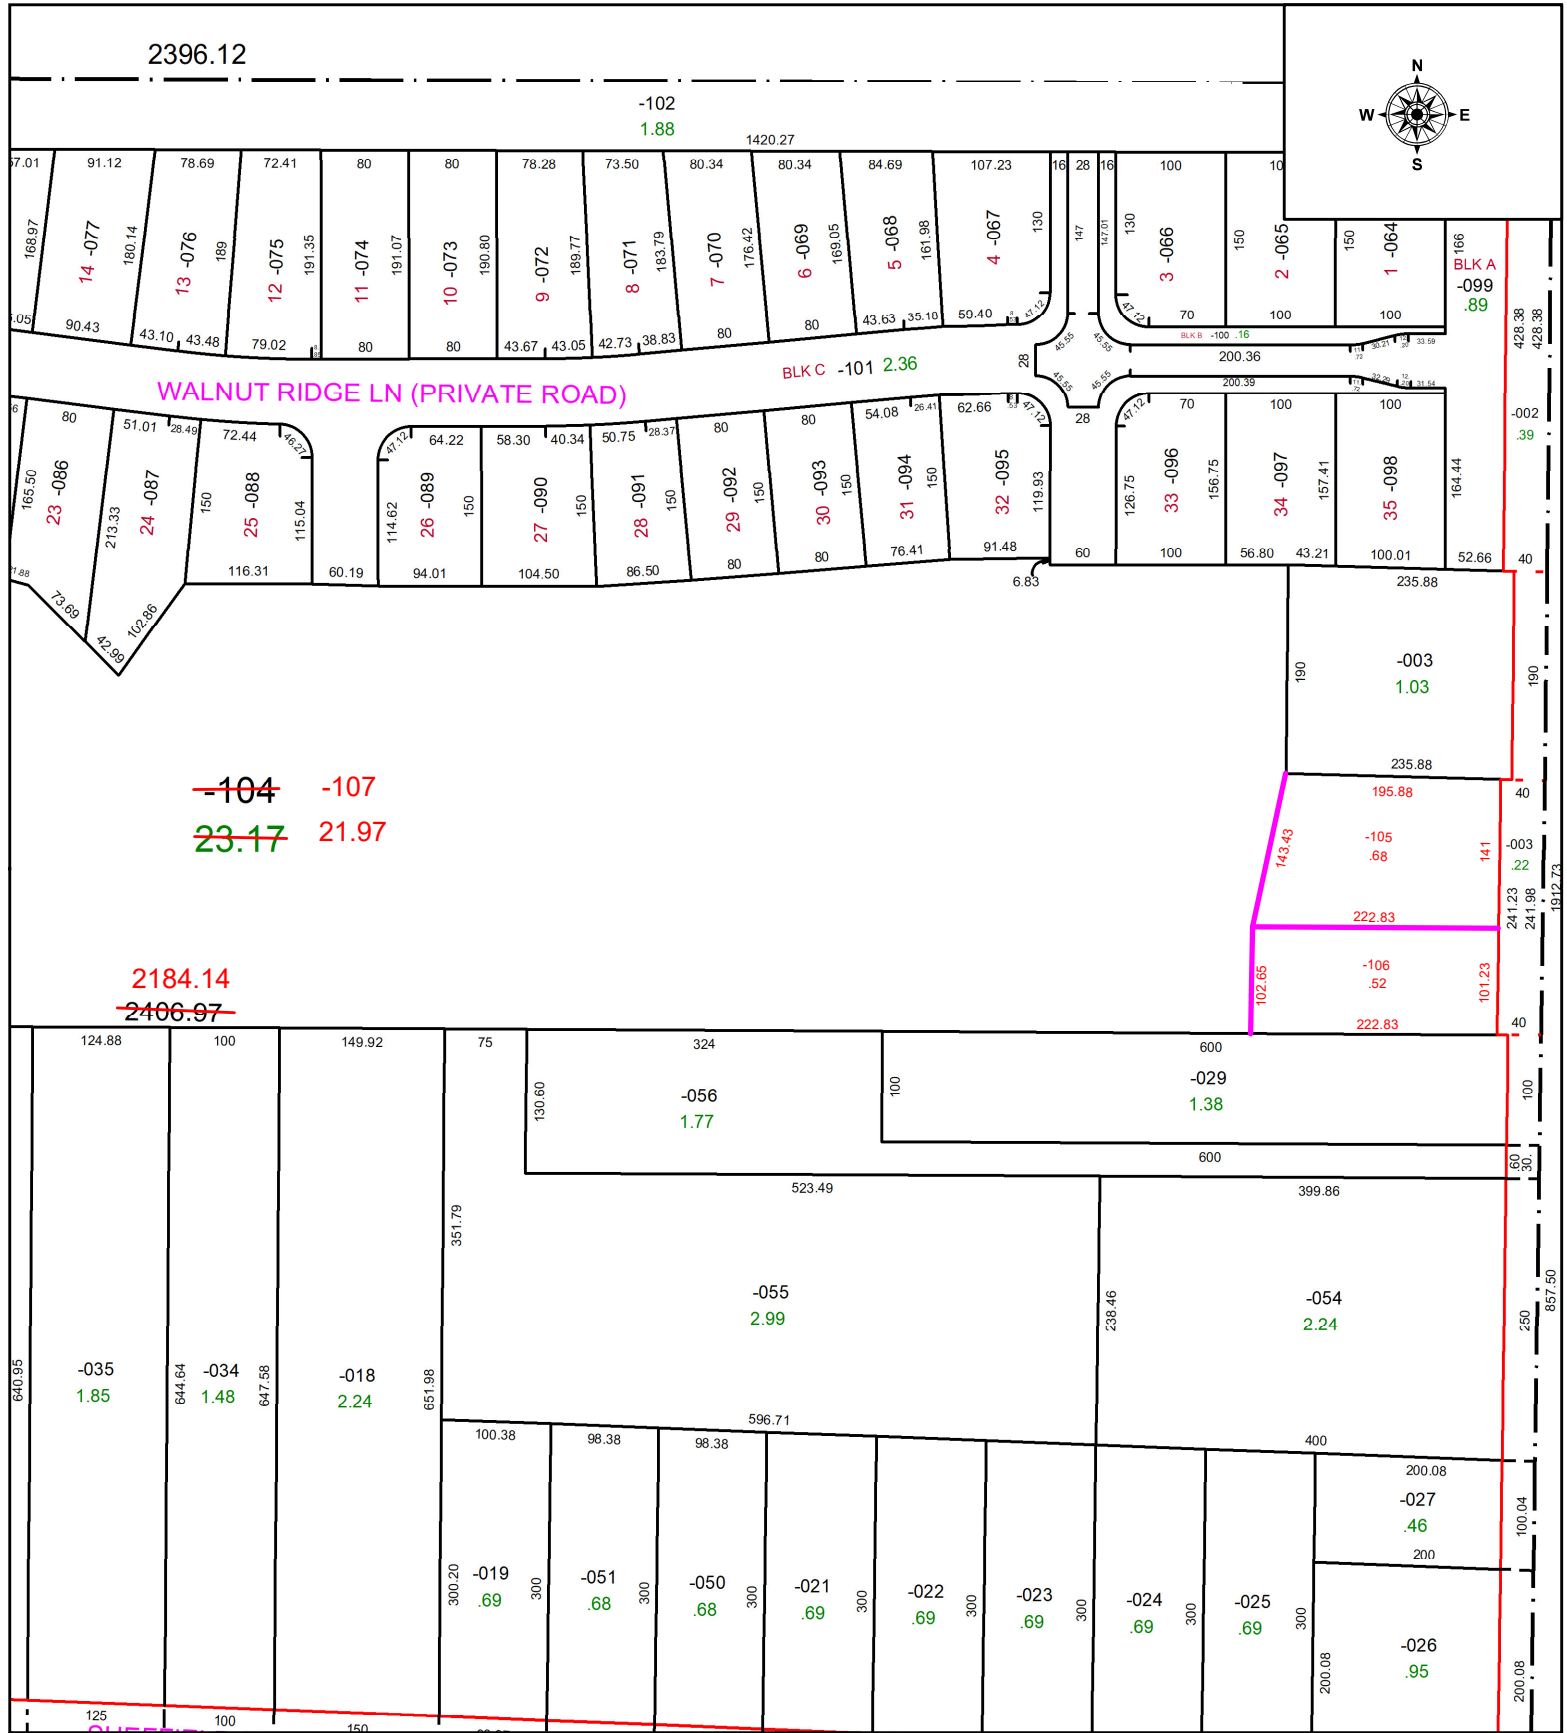

**SPLITS/DEEDS PROCESSED**  
 LORAIN COUNTY TAX MAP DEPARTMENT  
 226 MIDDLE AVE. ELYRIA, OH

SURVEYED BY: JOHN DECHANT JR. SURVEY # 51127  
 CLOSURE: 1: 332865  
 MAP PAGE(S): 03-00-015  
 APPROVED BY: WRZ DATE: 2/28/2024  
 SCALE: 1" = 175 PRIOR INSTRUMENT: #2024-0003527