


PARENT PARCEL: 06-26-077-000-001, -002, 005, -006, -007, & -008

CHILD PARCEL: 06-26-077-000-009

STARTING POINT: C/L OF KERSTETTER WAY AND BROAD ST **AC CORR PER SURV BY AMY M. KELLY**

24-04825

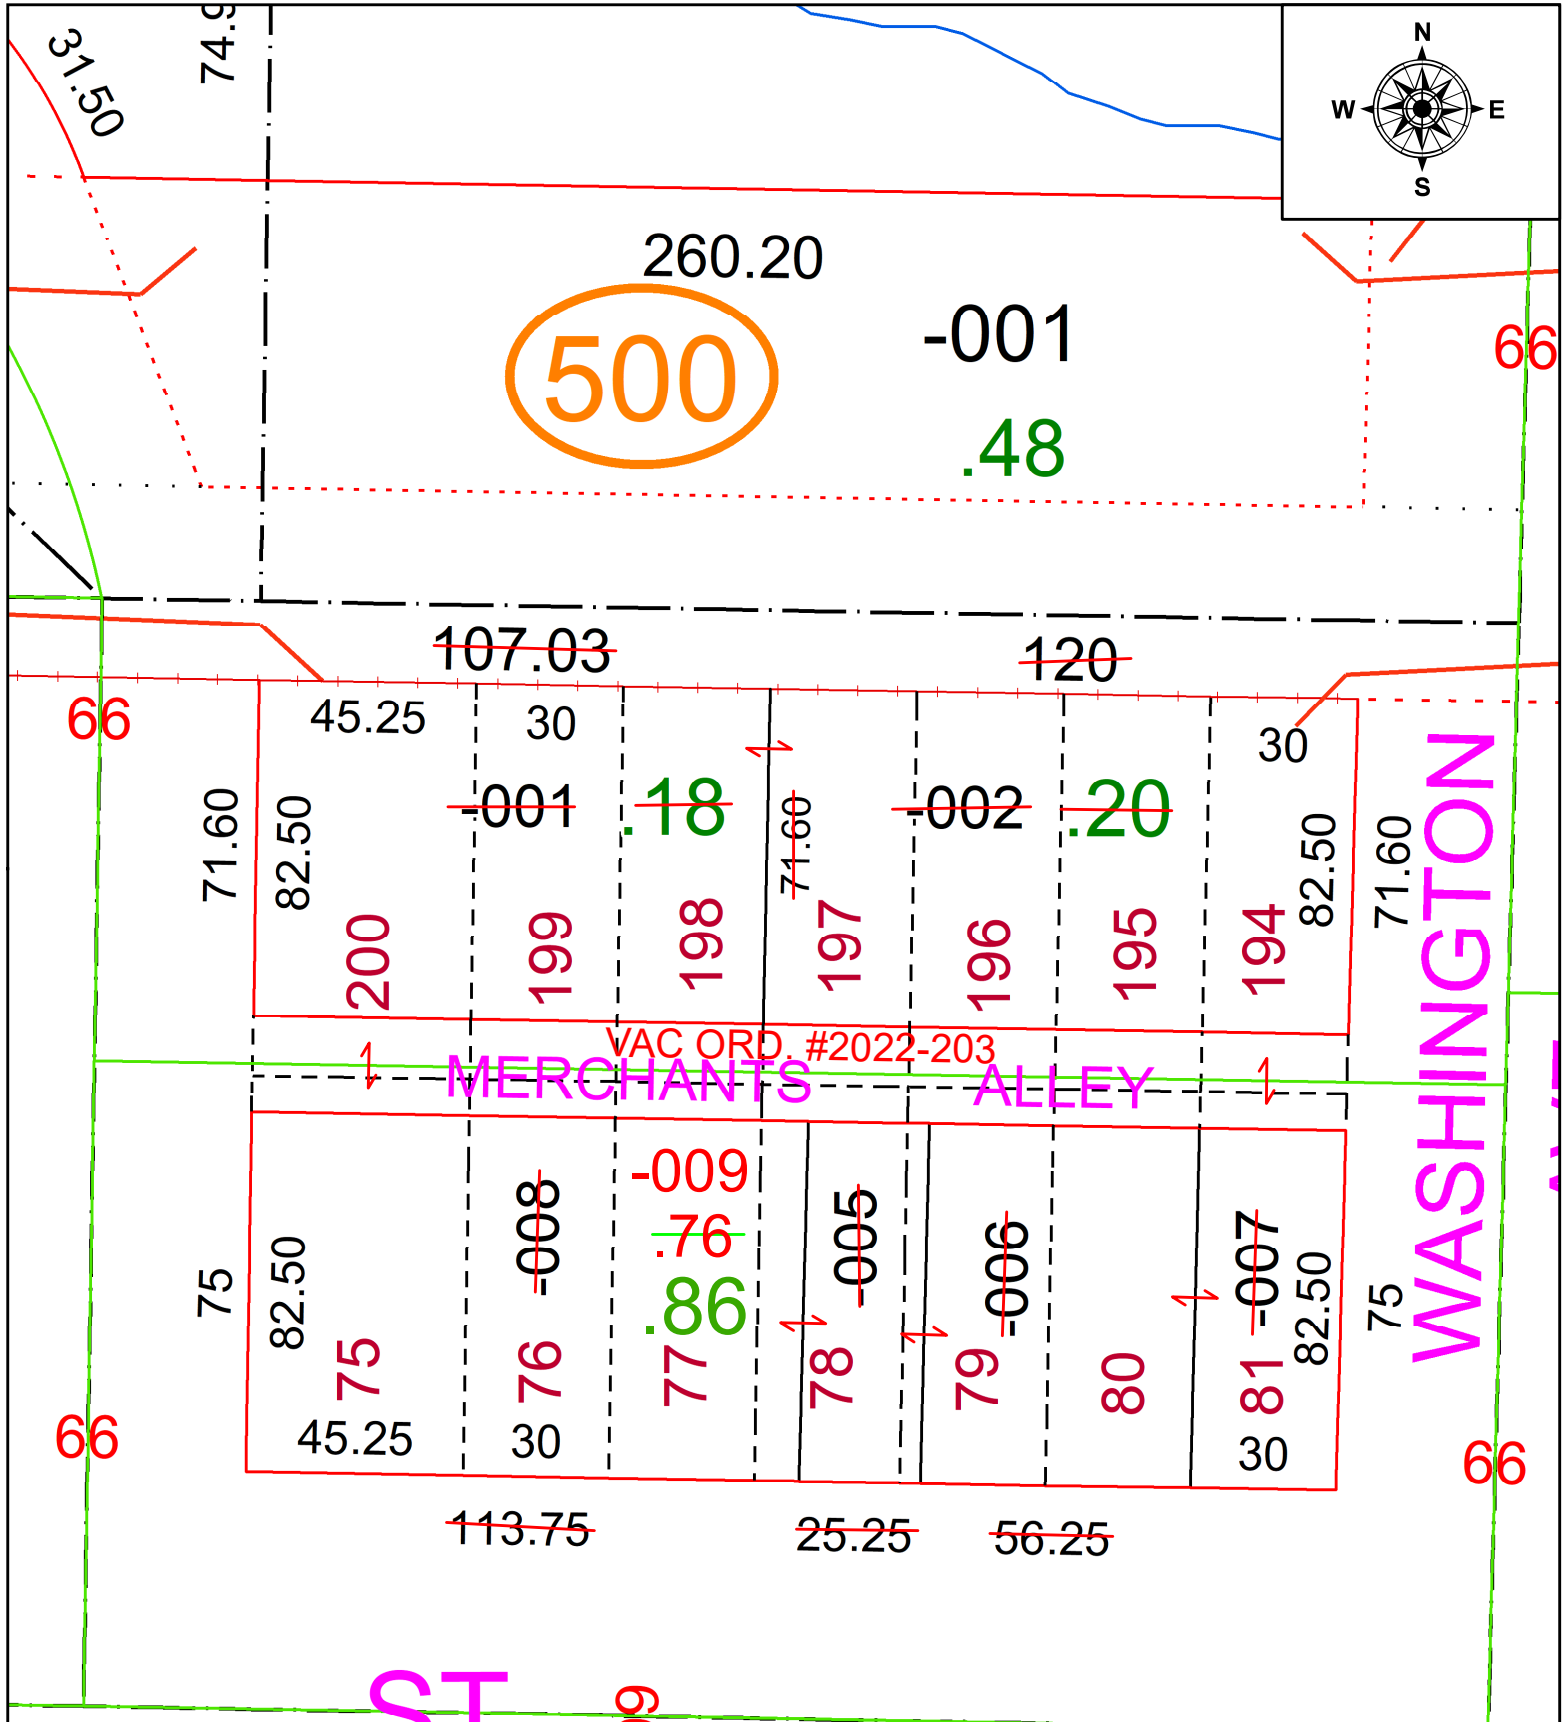

SPLITS/DEEDS PROCESSED
 LORAIN COUNTY TAX MAP DEPARTMENT
 226 MIDDLE AVE. ELYRIA, OH

SURVEYED BY: AMY M. KELLY SURV # 51131
 CLOSURE: 1: 590336
 MAP PAGE(S): 06-26
 APPROVED BY: AC DATE: March 07, 2024
 SCALE: 1 in = 40 ft PRIOR INSTRUMENT: 2021- 0851583