


PARENT PARCEL: 05-00-018-106-037 & -038

CHILD PARCEL: 05-00-018-106-096

AC CORR PER SURVEYOR THOMAS SIMON

24-04827

STARTING POINT: IRON PIPE IN MONUMENT BOX @ INTERSECTION OF C/LS OF STONEBRIDGE DR & SEELEY AVE

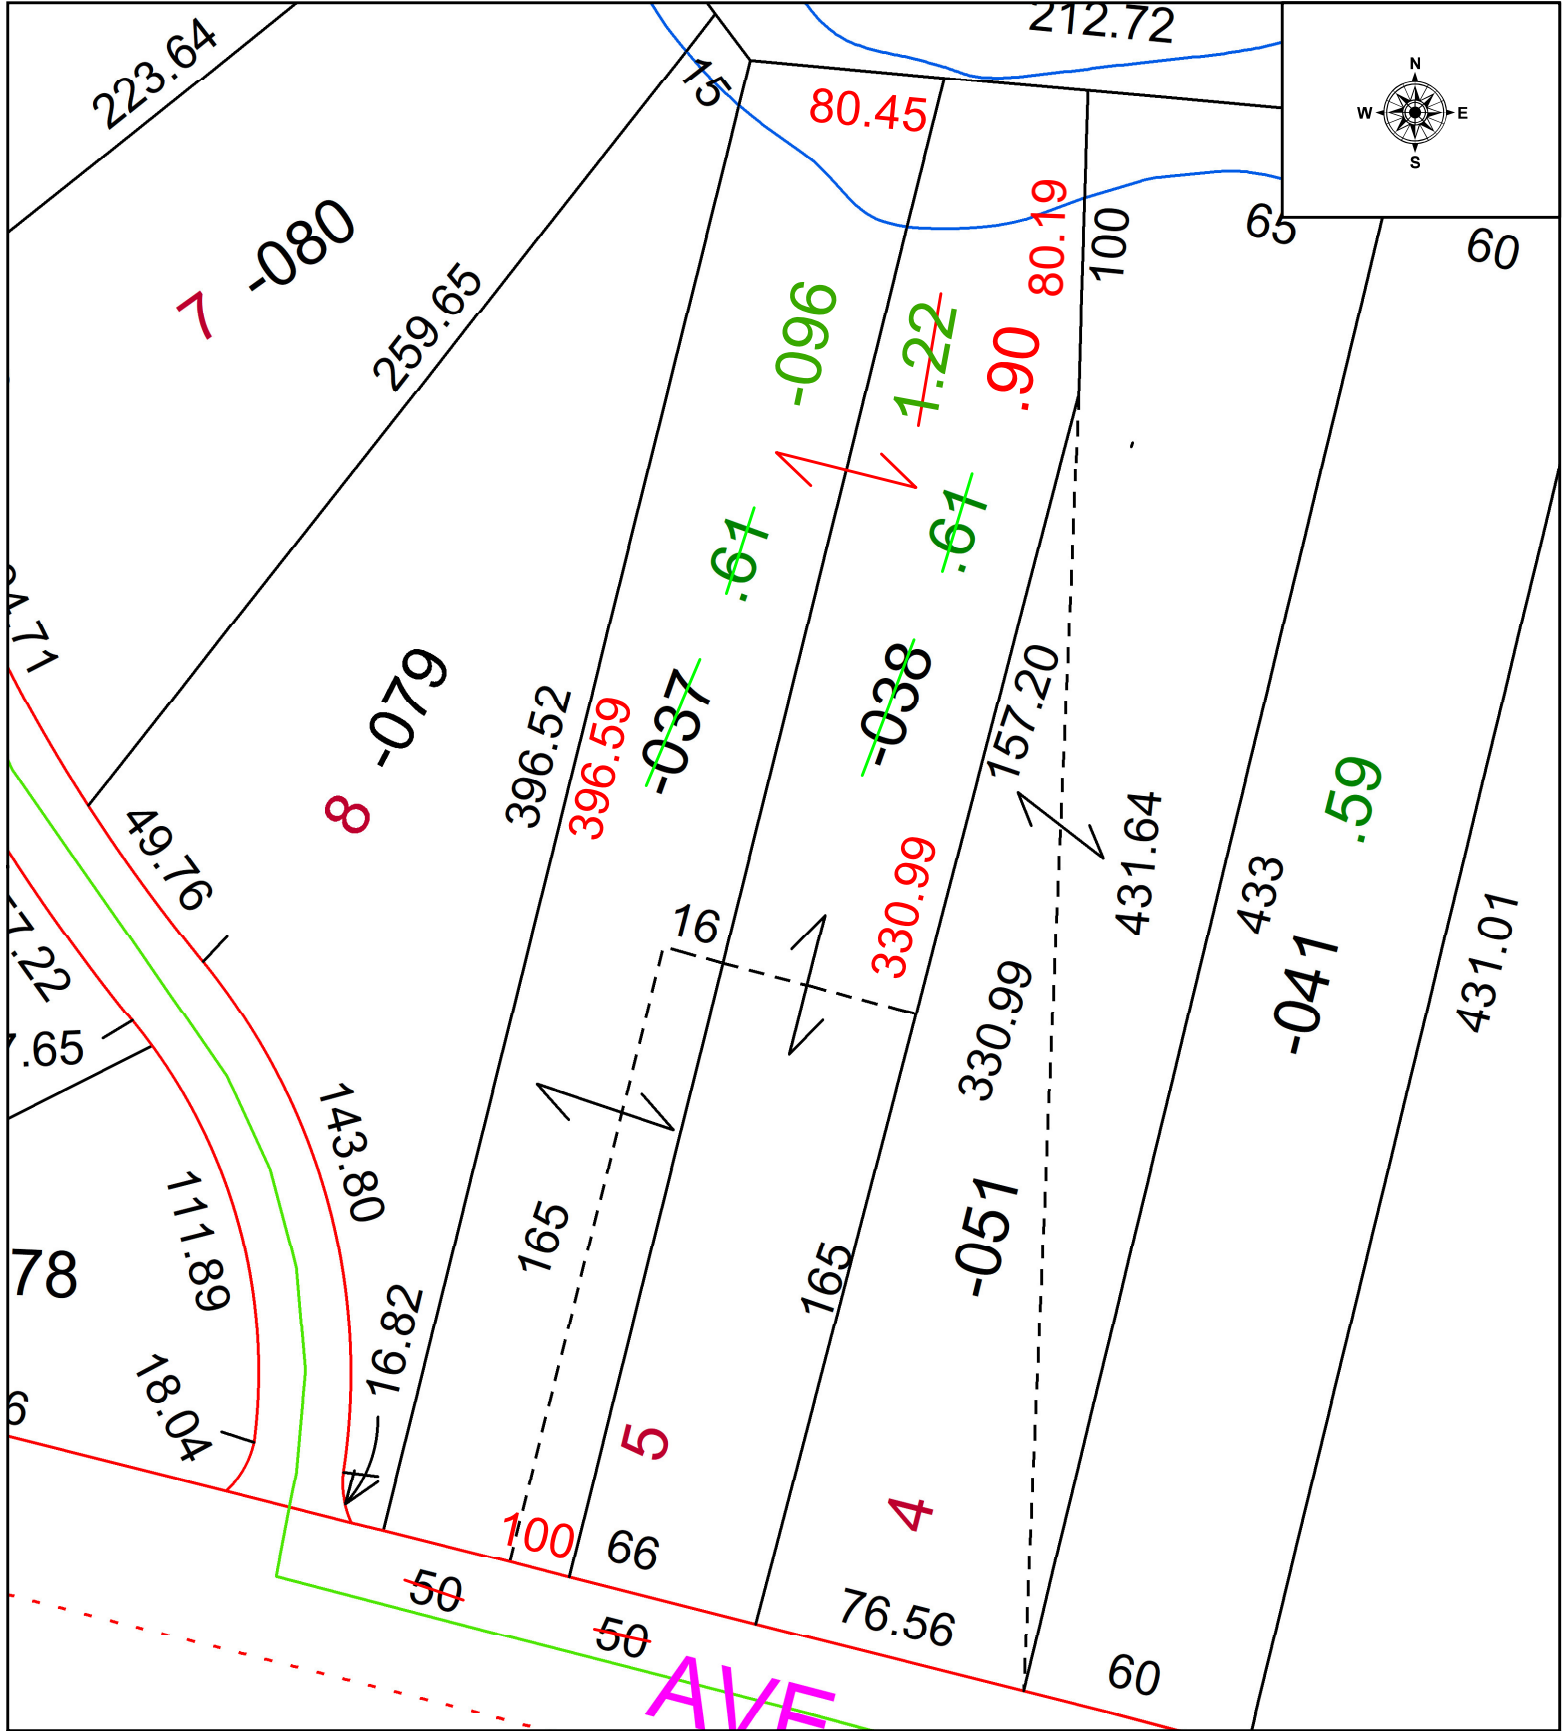

SPLITS/DEEDS PROCESSED
 LORAIN COUNTY TAX MAP DEPARTMENT
 226 MIDDLE AVE. ELYRIA, OH

SURVEYED BY: THOMAS SIMON SURVEY # 51133
 CLOSURE: 1: 207734
 MAP PAGE(S): 05-00-018
 APPROVED BY: WRZ DATE: 3/11/2024
 SCALE: 1" = 50 PRIOR INSTRUMENT: #2022-0860002