


PARENT PARCEL: 17-20-018-000-002, -003, & 17-08-036-000-001 (S.T.)

CHILD PARCEL: 17-20-018-000-030 & 17-08-036-000-001 (S.T.) AC CORR PER SURVEYOR CHAD CRAIG

STARTING POINT: IRON PIN IN MONUMENT BOX @ INTERSECTION OF C/LS OF GORE ORPHANAGE RD & PECK WADSWORTH RD

24-04829

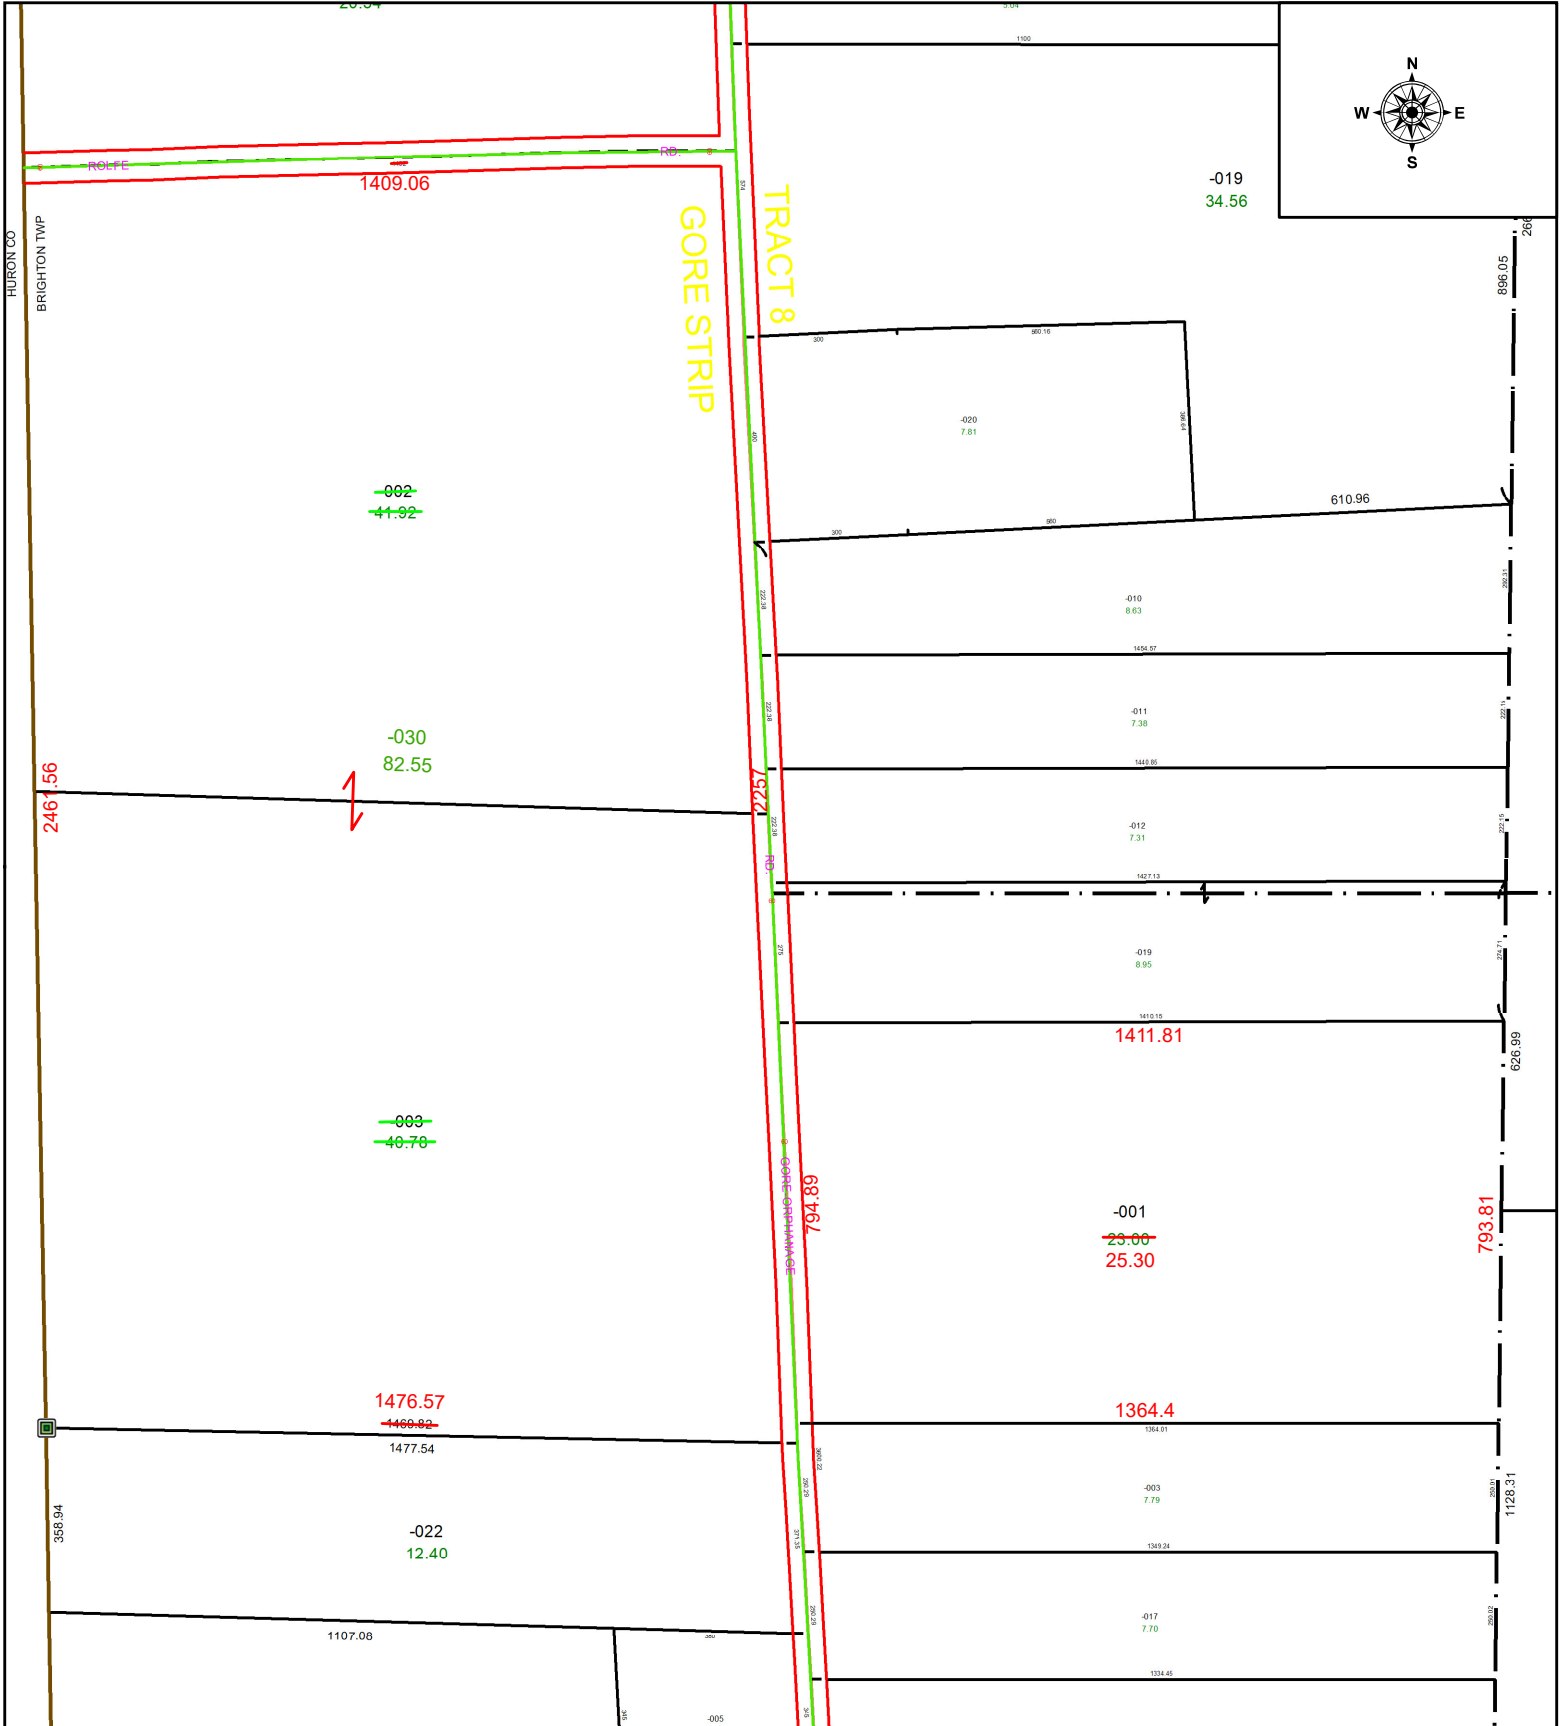

SPLITS/DEEDS PROCESSED
 LORAIN COUNTY TAX MAP DEPARTMENT
 226 MIDDLE AVE. ELYRIA, OH

SURVEYED BY: CHAD CRAIG SURVEY # 51138
 CLOSURE: 1: 1832168
 MAP PAGE(S): 17-20-018 & 17-08-036
 APPROVED BY: WRZ DATE: 3/14/2024
 SCALE: 1" = 375 PRIOR INSTRUMENT: #2024-0004263