


PARENT PARCEL: 07-00-028-103-001 & -002

CHILD PARCEL: 07-00-028-103-220

STARTING POINT: **AC CORR PER SURV BY RICHARD J. KOLE**

24-04830

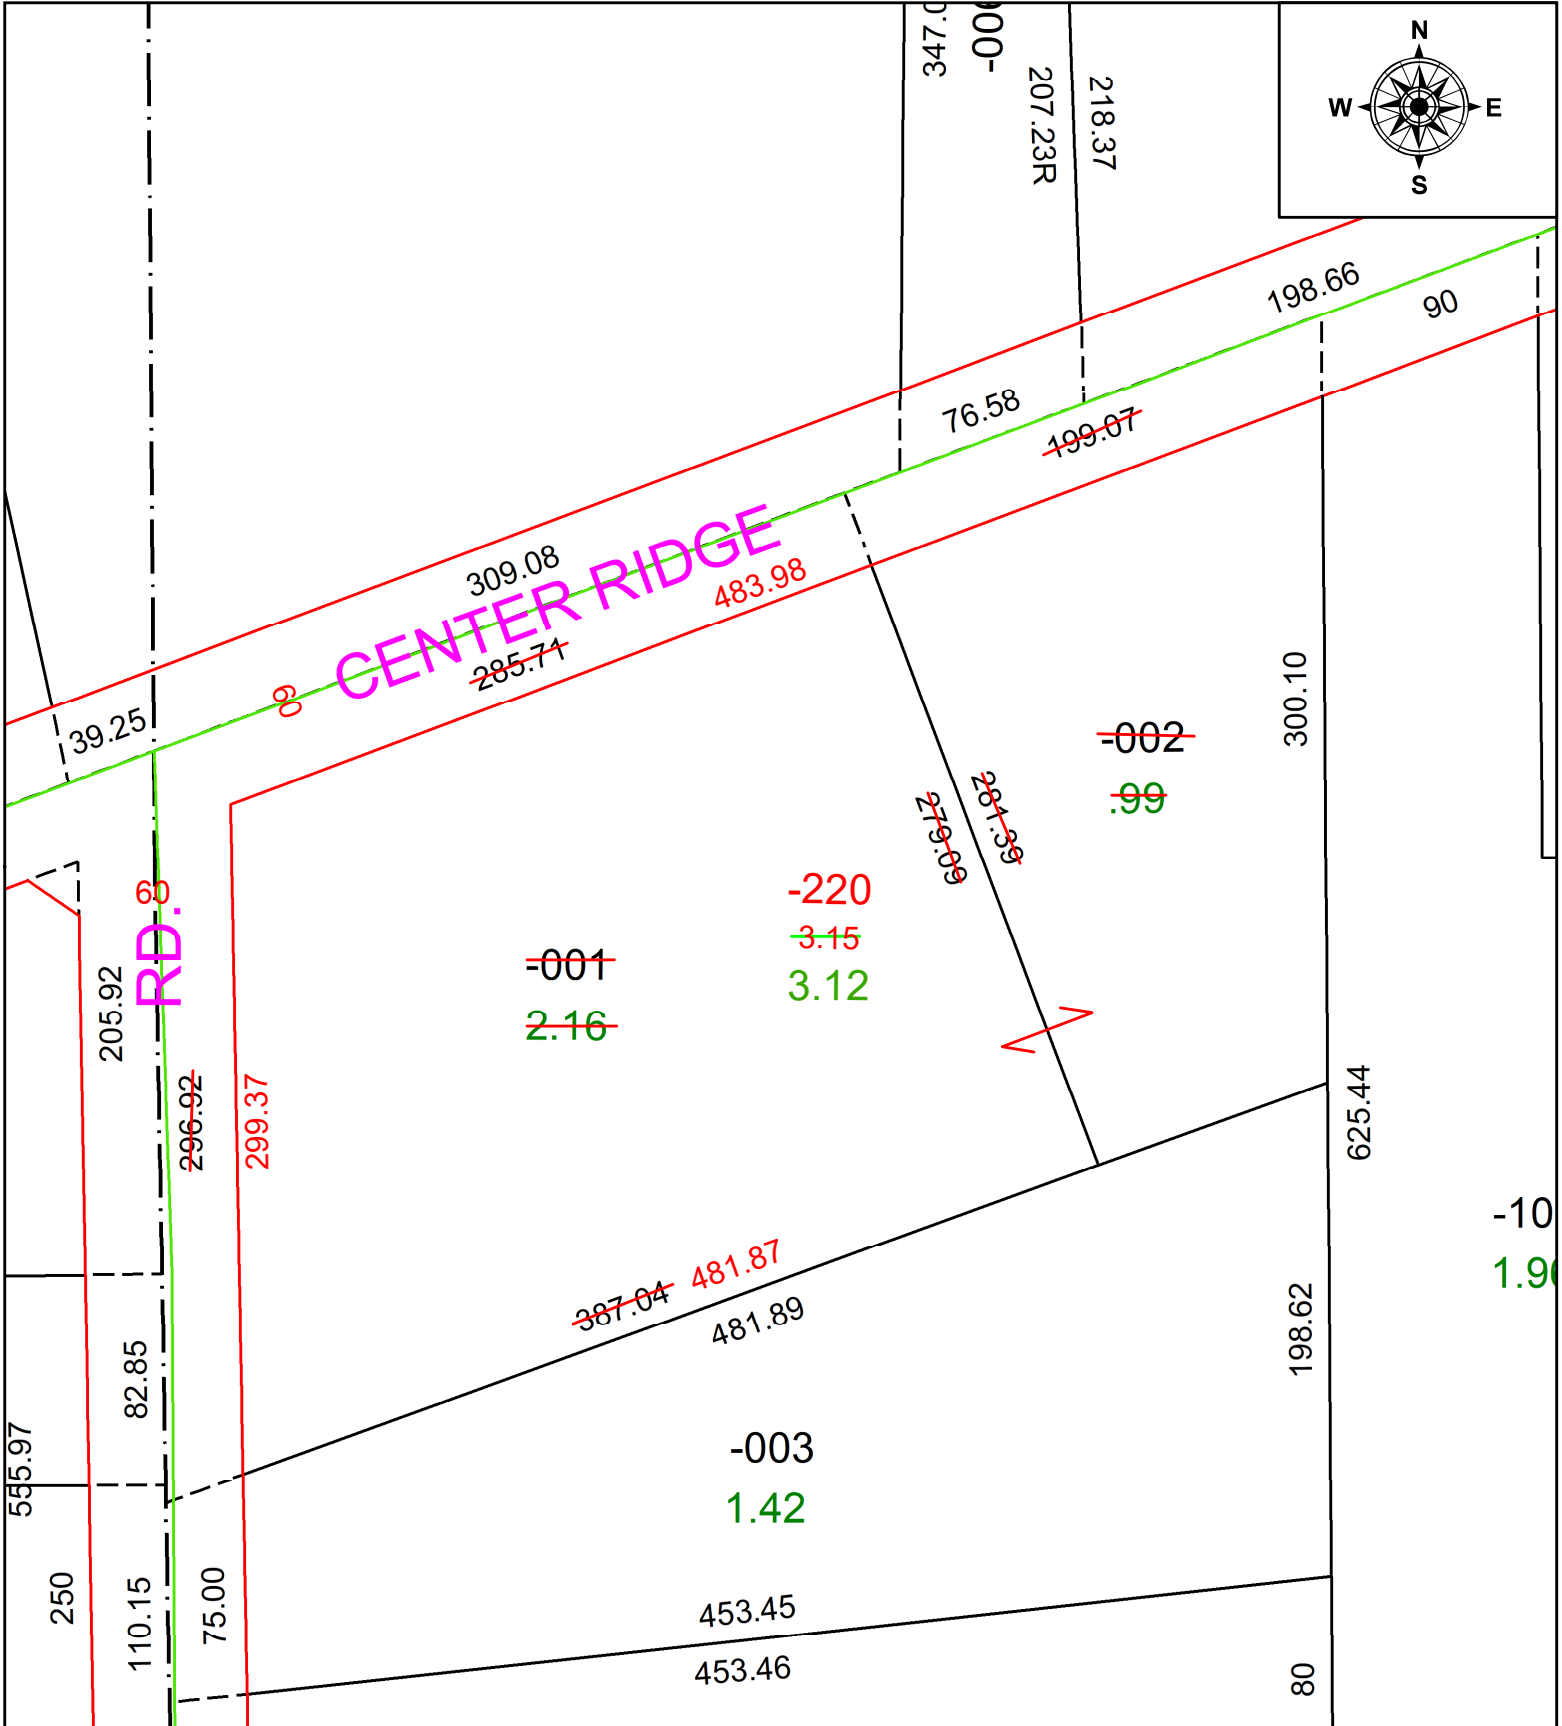

SPLITS/DEEDS PROCESSED
 LORAIN COUNTY TAX MAP DEPARTMENT
 226 MIDDLE AVE. ELYRIA, OH

SURVEYED BY: RICHARD J. KOLE **SURV # 51135**
CLOSURE: 1: 417519
MAP PAGE(S): 07-00-029
APPROVED BY: AC **DATE:** March 12, 2024
SCALE: 1 in = 75 ft **PRIOR INSTRUMENT:** 2022- 0880351