
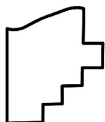


PARENT PARCEL: 04-00-010-114-056 & 04-00-003-103-082 AC CORR PER SURVEYOR STUART SAYLER

CHILD PARCEL: 04-00-010-114-057 THRU -068 & 04-00-003-103-083 THRU -094

24-04833

STARTING POINT: IRON PIN @ INTERSECTION OF WEST LINE OF N. LONG RD & SOUTH LINE OF O.S. 3

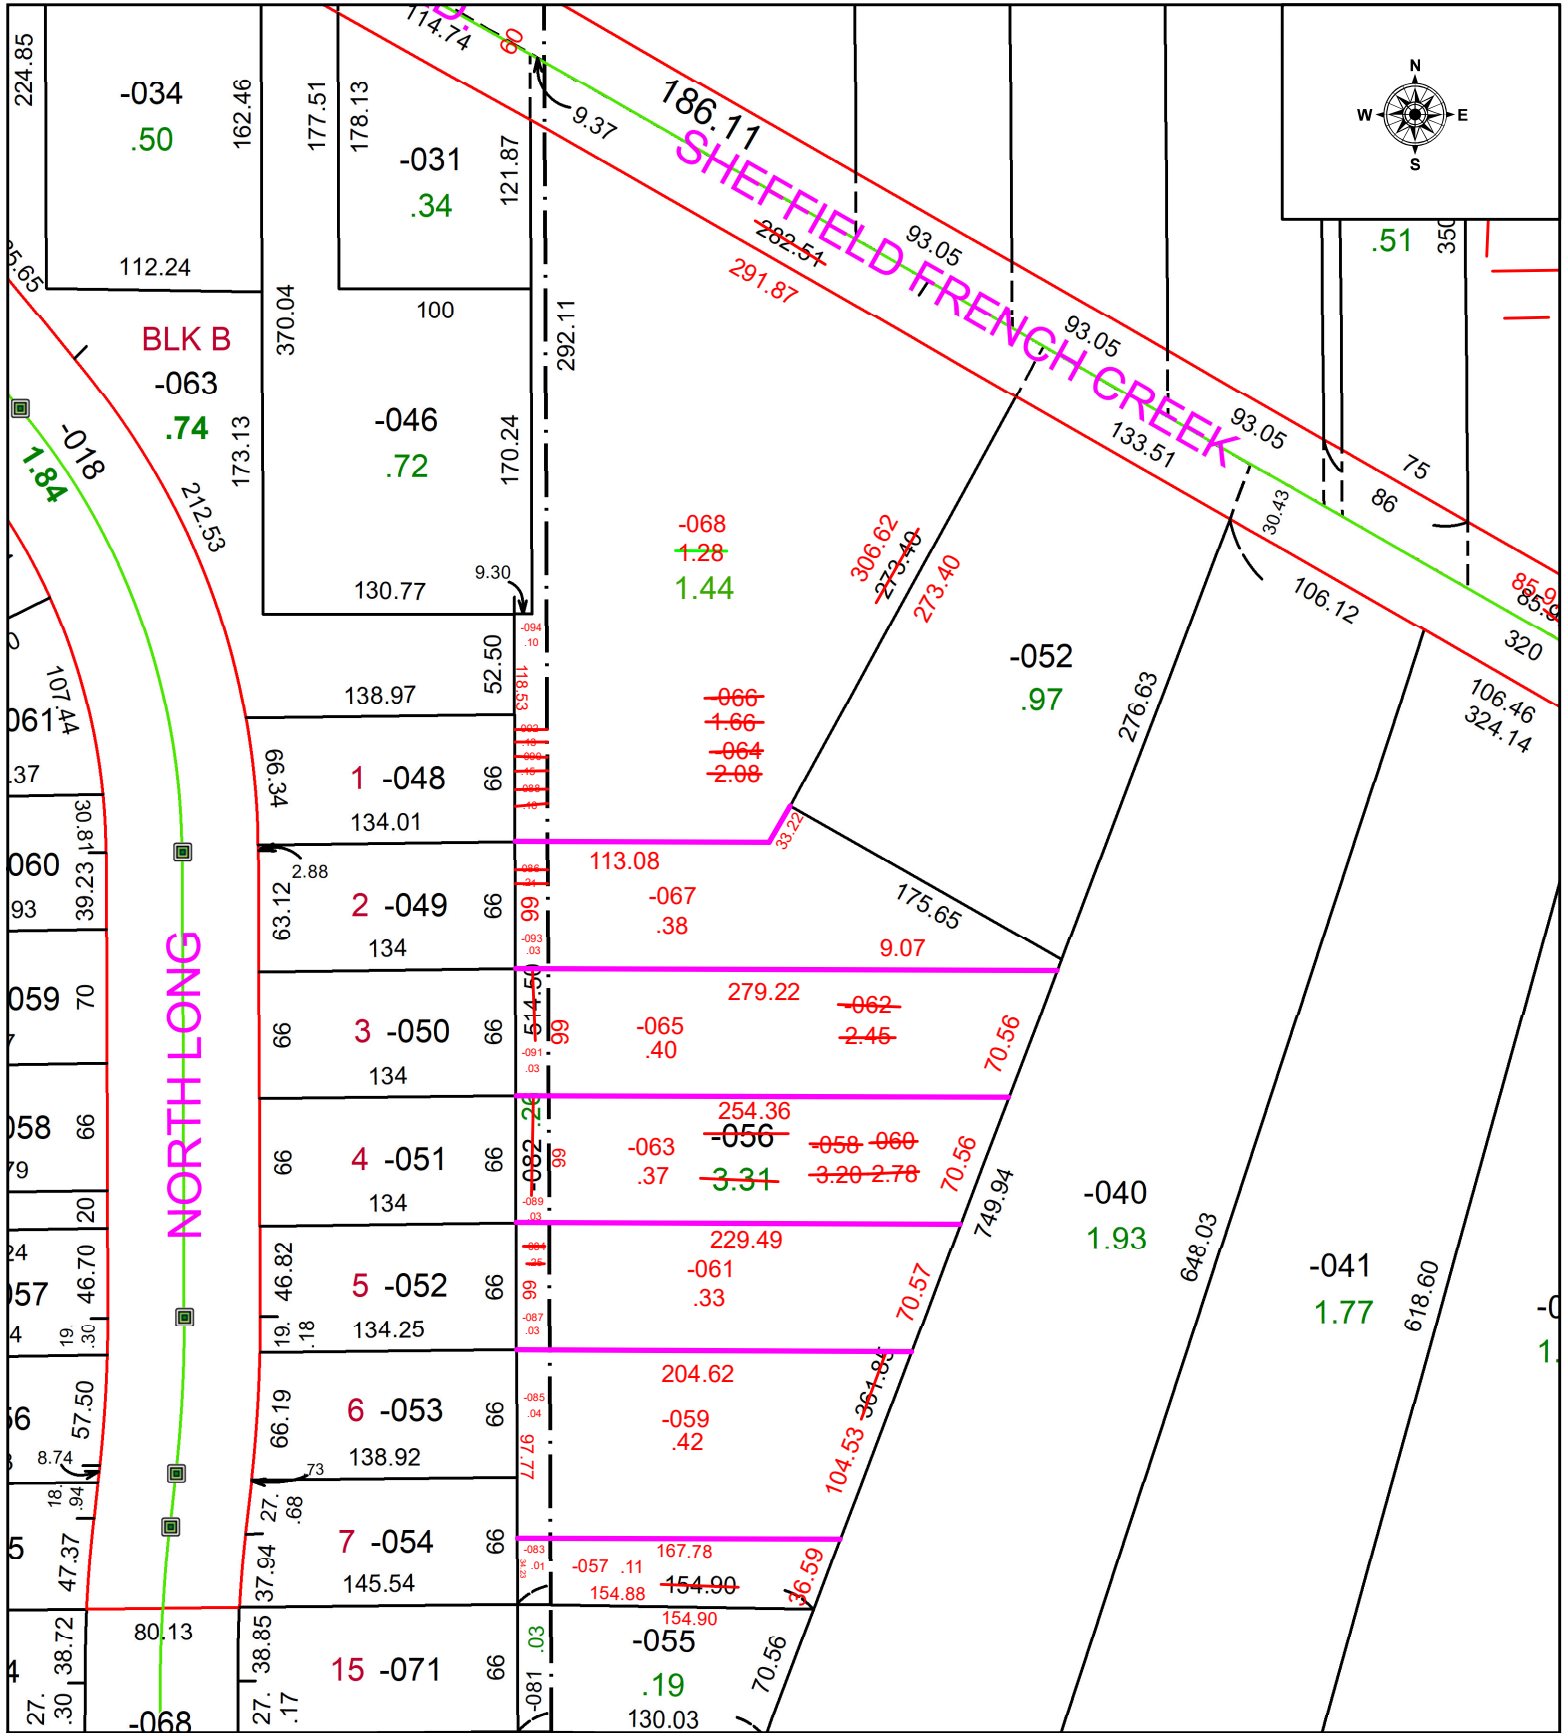

**SPLITS/DEEDS PROCESSED**

LORAIN COUNTY TAX MAP DEPARTMENT  
226 MIDDLE AVE. ELYRIA, OH

SURVEYED BY:	STUART SAYLER	SURVEY #	51140
CLOSURE:	1: 48996		
MAP PAGE(S):	04-00-010 & 04-00-003		
APPROVED BY:	WRZ	DATE:	3/22/2024
SCALE:	1" = 375	PRIOR INSTRUMENT:	#2024-0004263