


PARENT PARCEL: 01-00-054-000-018

CHILD PARCEL: **AC CORR PER SURV BY TIMOTHY D. HOZALSKI**

STARTING POINT: C/L OF BAUMHARDT RD AND NE CORNER OF O/L 54

22-04835-C

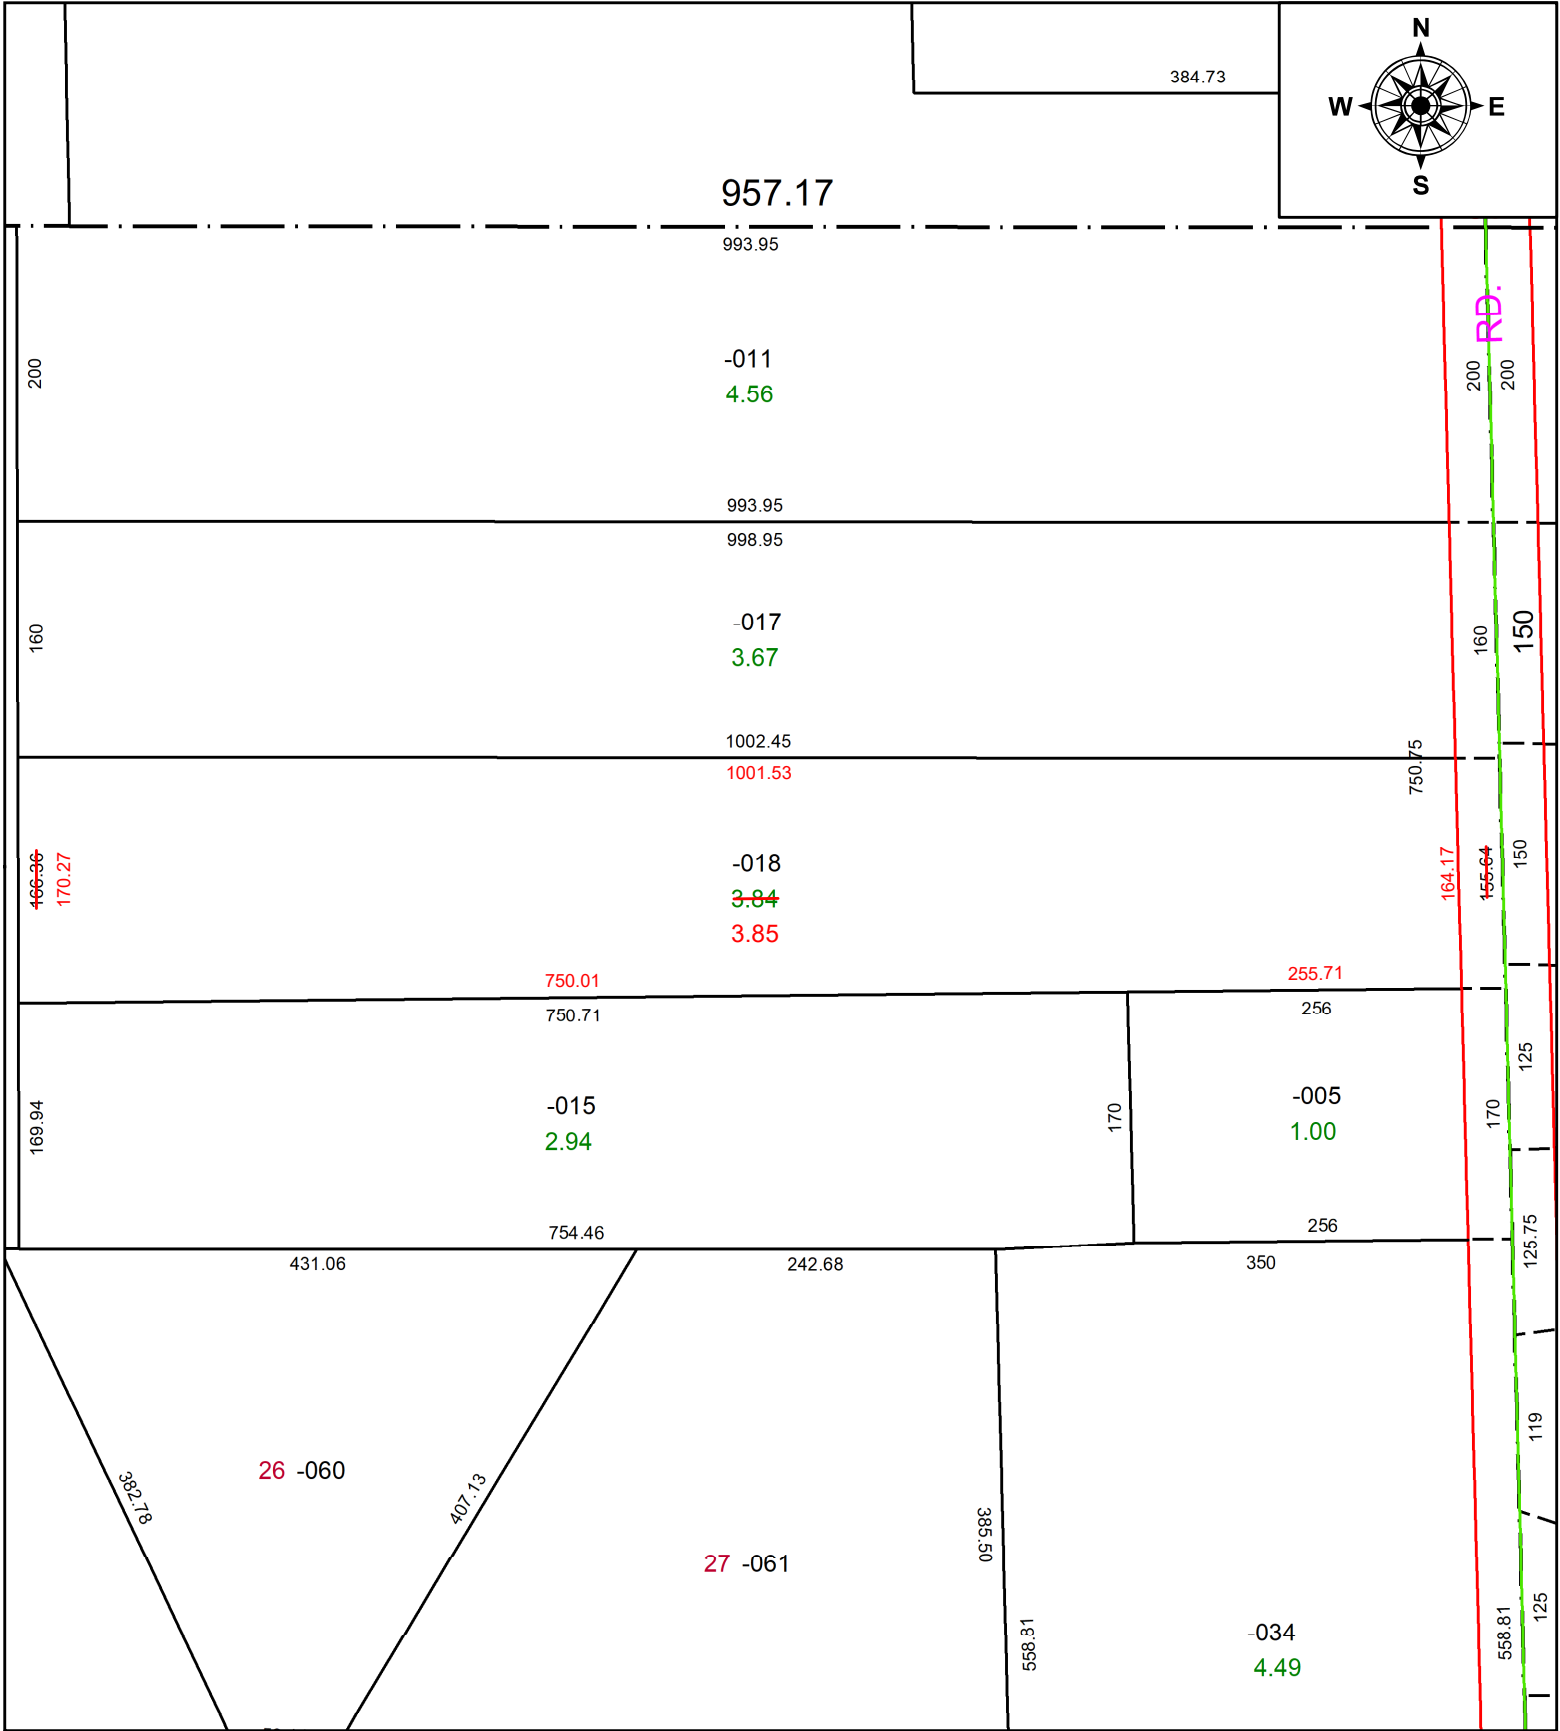

**SPLITS/DEEDS PROCESSED**  
 LORAIN COUNTY TAX MAP DEPARTMENT  
 226 MIDDLE AVE. ELYRIA, OH

**SURVEYED BY:** TIMOTHY D. HOZALSKI

**CLOSURE:** 1: 257408

**MAP PAGE(S):** 01-00-054-B

**APPROVED BY:** AC **DATE:** 4/8/2022

**SCALE:** 1" = 130 **PRIOR INSTRUMENT:** 2021- 0840051