


PARENT PARCEL: 03-00-101-122-010 THRU -015

CHILD PARCEL:

STARTING POINT:


FRONTAGE & DEPTH CORR PER VAC ORD # 171-87

22-04836-V

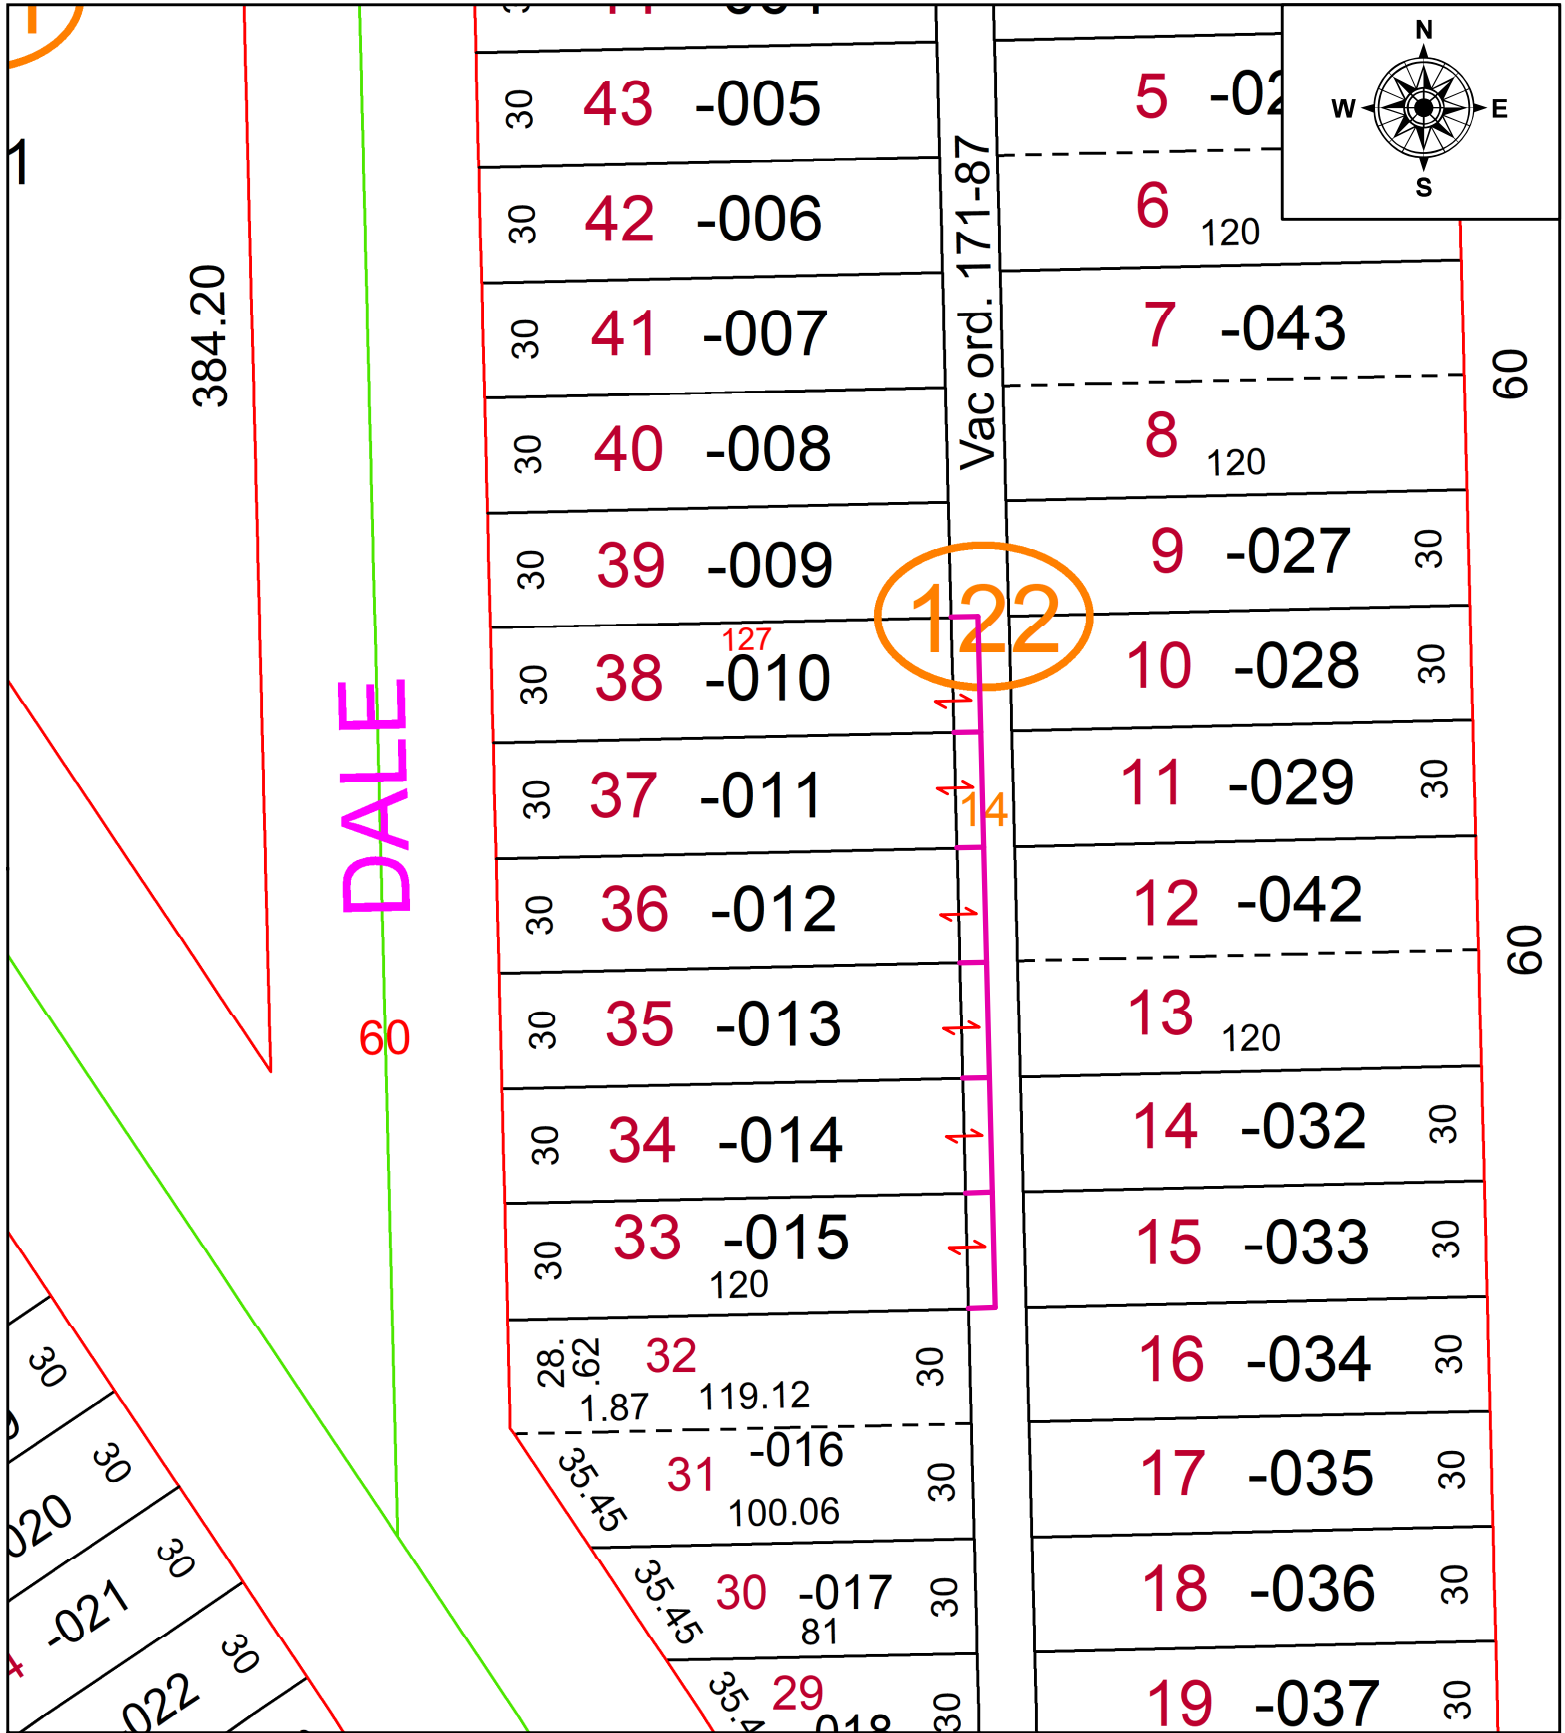

DALE

122

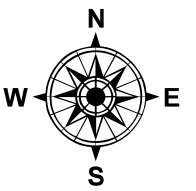


384.20

60

60

60

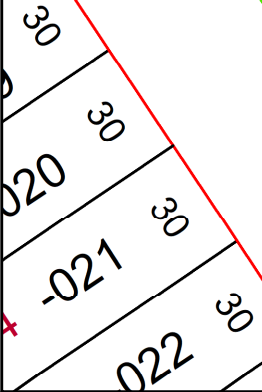

SPLITS/DEEDS PROCESSED

LORAIN COUNTY TAX MAP DEPARTMENT
226 MIDDLE AVE. ELYRIA, OH

SURVEYED BY: _____ N/A
 CLOSURE: _____ N/A
 MAP PAGE(S): _____ 03-00-101
 APPROVED BY: _____ AC DATE: 4/13/2022
 SCALE: 1" = 50 PRIOR INSTRUMENT: 2006- 0135228