


PARENT PARCEL: 05-00-025-104-001 & -026

CHILD PARCEL: 05-00-025-104-128, -129, & -130 AC CORR PER SURVEYOR WILFREDO BARBOSA

24-04837

STARTING POINT: NORTHEAST CORNER OF S/L 11 IN FOREST HILLS ALLOTMENT

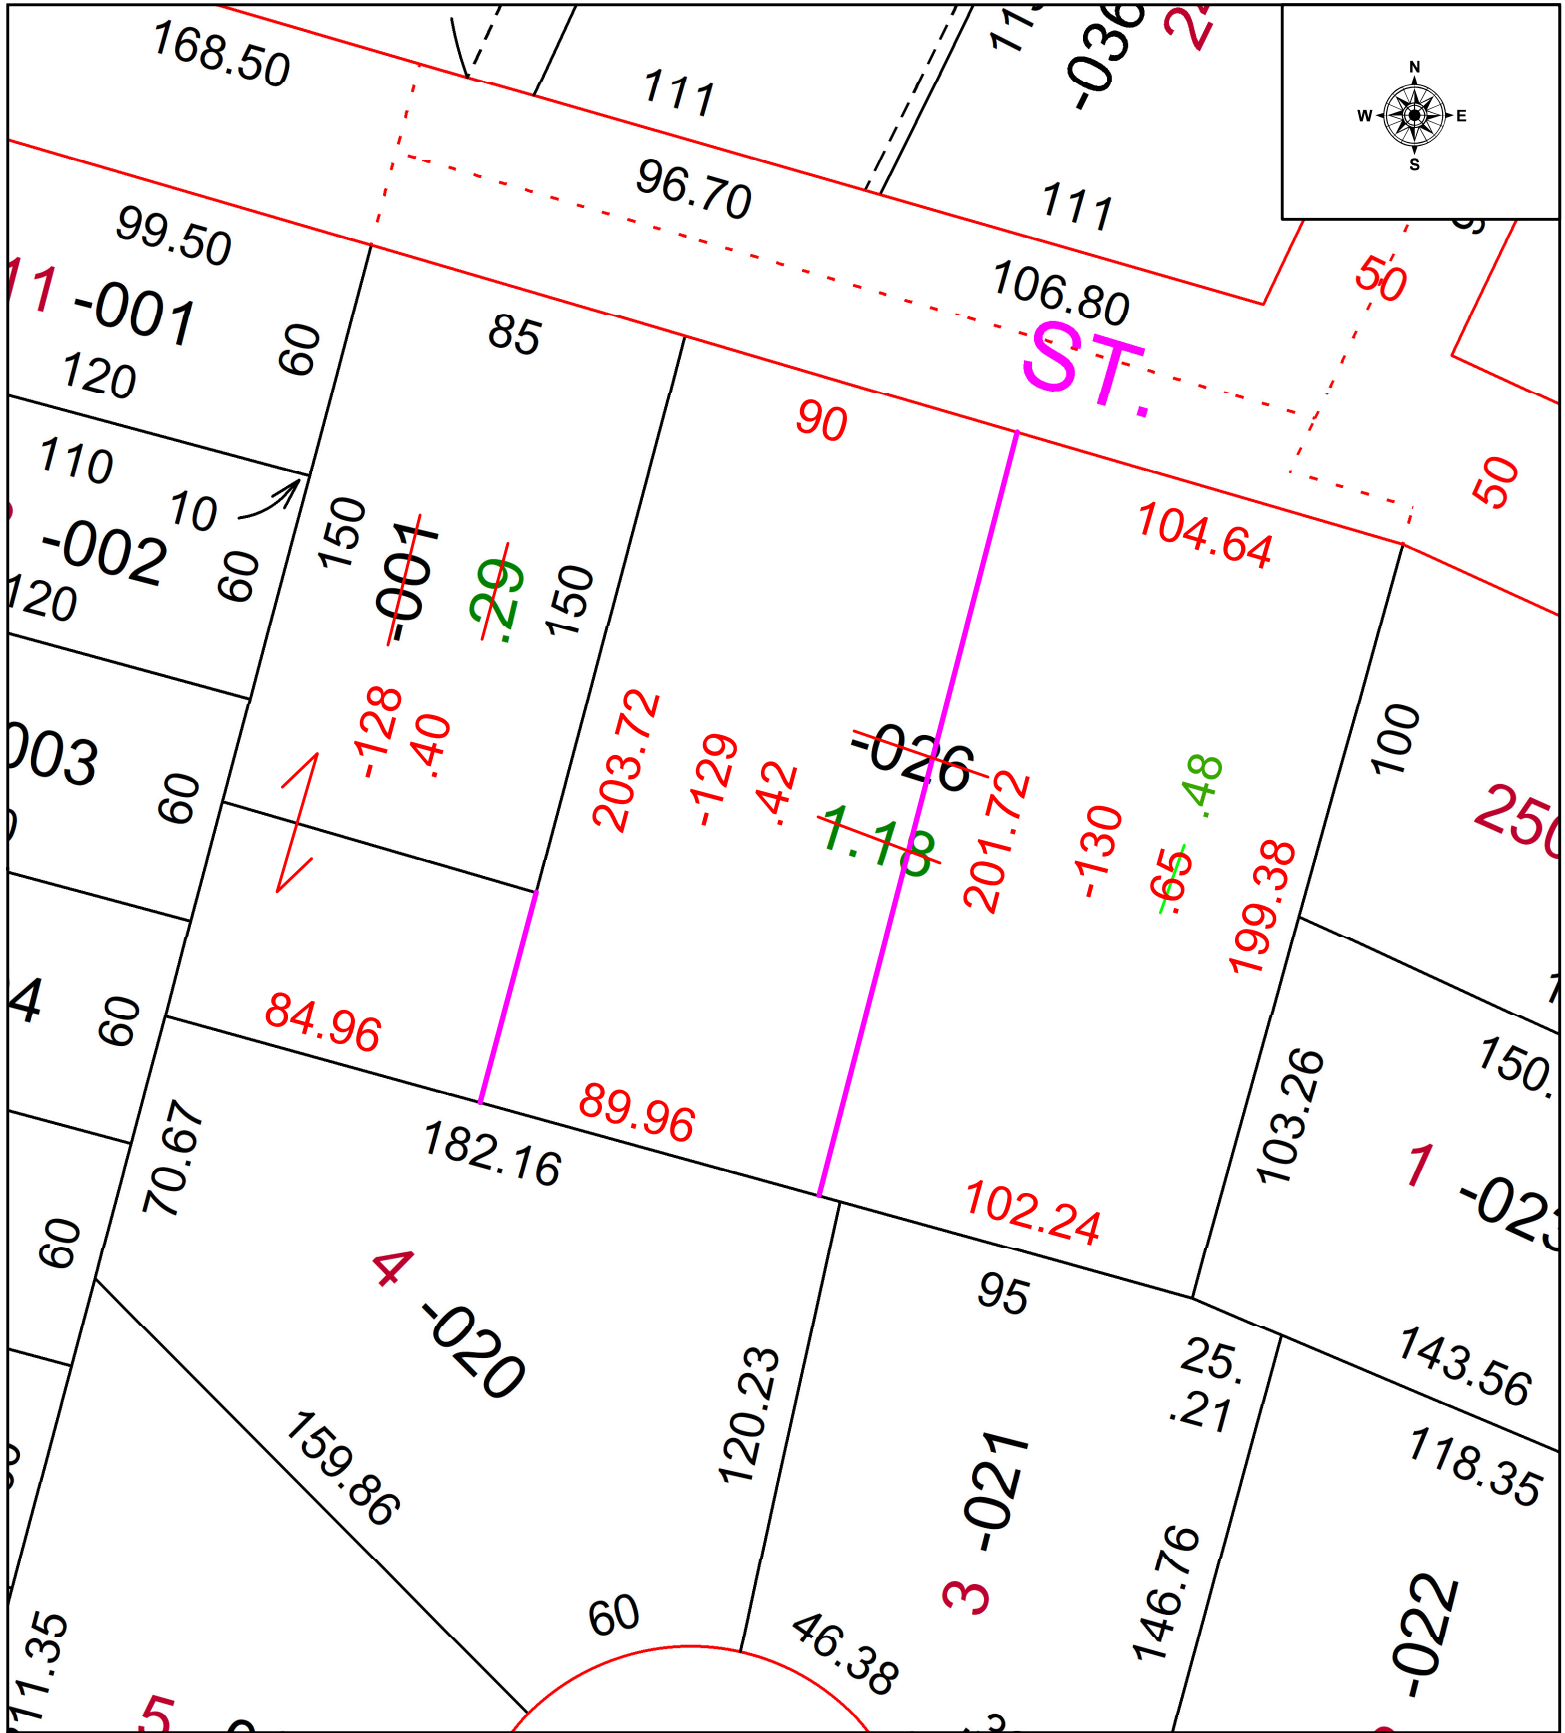

SPLITS/DEEDS PROCESSED
 LORAIN COUNTY TAX MAP DEPARTMENT
 226 MIDDLE AVE. ELYRIA, OH

SURVEYED BY: WILFREDO BARBOSA SURVEY # 51151
 CLOSURE: 1: 49096
 MAP PAGE(S): 05-00-025
 APPROVED BY: WRZ DATE: 4/4/2024
 SCALE: 1" = 50 PRIOR INSTRUMENT: #2008-0276070